IREDELL COUNTY HEALTH DEPARTMENT

STATESVILLE 704-878-5305 MOORESVILLE 704-664-5281

IMPROVEMENT PERMIT / AUTHORIZATION TO CONSTRUCT / OPERATION PERMIT / EXISTING SYSTEM INSPECTION

PERMIT# 152864 PIN# 4649873247 Eric Ward DATE 10-6-08

OWNER OR APPLICANT Robert Plyler/Freedom Homes PHONE: Business 704 746 4778 Home

ADDRESS 172 Sorrel Ln Troutman, NC 28166 172 sorrel

LOCATION Hwy 115/21 North TL Flower House Lp TL Thoroughbred TL Sorrel home on right

SUBDIVISION Palomino Pk BLOCK / SECTION LOT 18 LOT AREA 1.0 Acre SITE CLASS. PS DESIGN FLOW 240gpd T.A.R. .3

Existing

Septic Tank: 1000 Gallons; STB Date

Pump Tank: Gallons; PT Date

Pump Make: Model Serial No.

Nitrification Field: No Fields 1 Square Feet 1080 Linear Feet 360

No Lines 3 Trench Width 36" Max Trench Bottom Depth Gravel Depth 12"

☐ New System ☐ Repair ☐ Expansion System Type: I II III IV V VI

System Description: Existing Gravity-Convent.

Repair System Description: Pump-Panel

Maintenance Agreement Required: ☐ Yes ☒ No

☐ Gravity ☐ Pressure

☐ House/Mod. Home ☒ Mobile Home ☐ Business ☐ Other

No. Bedrooms 2 No. Persons No. Employees


Water Supply: ☒ Individual ☐ Public ☐ Community

☐ Slab ☐ Crawl Space ☐ Basement w/plumbing ☐ Basement wo/plumbing

Comments/Conditions: Existing Septic System appears to be functioning okay at time of inspection.

Comments/Conditions: Originally permitted & approved for 3 Bedroom Septic System installed 6/9/2000

Proposed Accessory INITIAL SITE SKETCH Not to Scale

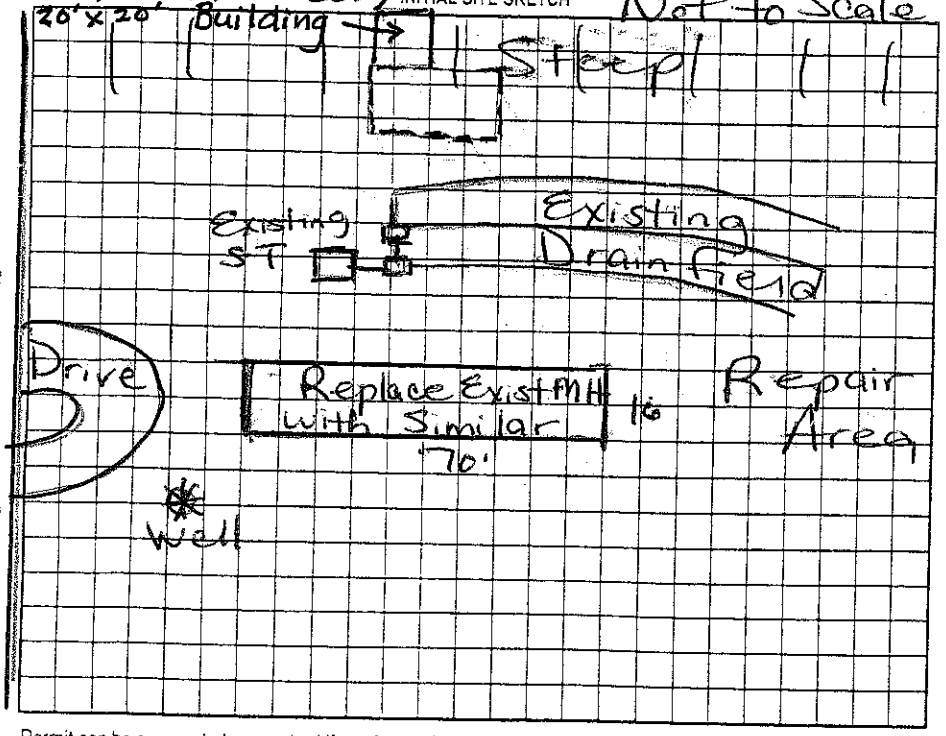

AS BUILT SKETCH

ICHD-Environmental Health Division

The proposed / existing Accessory Building addition does not appear to impact the existing septic system.

**NOTE: Building foundations shall be min 5' from septic system Judy Melvill R.S. Date: 4-5-12

Permit can be suspended or revoked if any false information is supplied toward securing the permit/any unauthorized changes are made to the site/any unauthorized changes are made in the installation of the system. Improvement Permit with plat valid without expiration ☐ Improvement Permit with site plan valid for sixty months ☐ Authorization to Construct is valid for a period equal to that of Improvement Permit – not to exceed sixty months.

Signed: X Robert Plyler date

Improvement Permit by: Myrna Holt Dotson RS date 10/6/08

Authorization to Construct by: Myrna Holt Dotson RS date 10/6/08

Installed by:

Operation Permit by: date

Existing System Inspection by: Myrna Holt Dotson RS date 10/6/08

HEALTH DEPT. COPY: WHITE OWNER COPY (FINAL): YELLOW OWNER COPY (INITIAL): PINK