IREDELL COUNTY HEALTH DEPARTMENT

STATESVILLE 704-878-5305 MOORESVILLE 704-664-5281

IMPROVEMENT PERMIT / AUTHORIZATION TO CONSTRUCT / OPERATION PERMIT / EXISTING SYSTEM INSPECTION

PERMIT # 161019 PIN # 4649-87-6306 DATE 5-26-10

OWNER or APPLICANT TERRY STACEY PHONE: Business 704-528-7960 Home: FREEDOM HOMES

OWNER or APPLICANT ADDRESS 198 SORREL LN TROUTMAN NC 28166

LOCATION / DIRECTIONS RANKIN HILL, TL THOUROUGHBRED, TL SORREL

SUBDIVISION PALOMINO PARK BLOCK / SECTION LOT # 20 & 21 LOT AREA 2.597 AC DESIGN FLOW 360 GPD L.T.A.R. .3

Septic Tank Ex. 1000 Gallons: STB Date

Pump Tank 2 Gallons: P T Date

Pump Make Model Serial #

Nitrification Field No Fields 1 No Lines 3 Linear Feet 400

Trench Width 36" Max. Trench Bottom Depth 36" Gravel Depth 12"

☐ New System ☐ Repair ☐ Expansion System Type I II III IV V VI

System Description: GRAVITY CON. GRAVEL

Repair System Description: SAME

Maintenance Agreement Required ☐ YES ☒ NO

☐ GRAVITY ☐ PRESSURE

☒ Residence No. Bedrooms 3

☐ Business No. Persons

☐ Other No. Employees

☐ Slab ☒ Crawl Space

☐ Basement w/plumbing ☐ Basement w/o plumbing


Water Supply: ☒ Private ☐ Public ☐ Community

Comments / Conditions

Comments / Conditions

SYSTEM FUNCTIONING GOOD @ TIME OF INSPECTION

INITIAL SITE SKETCH

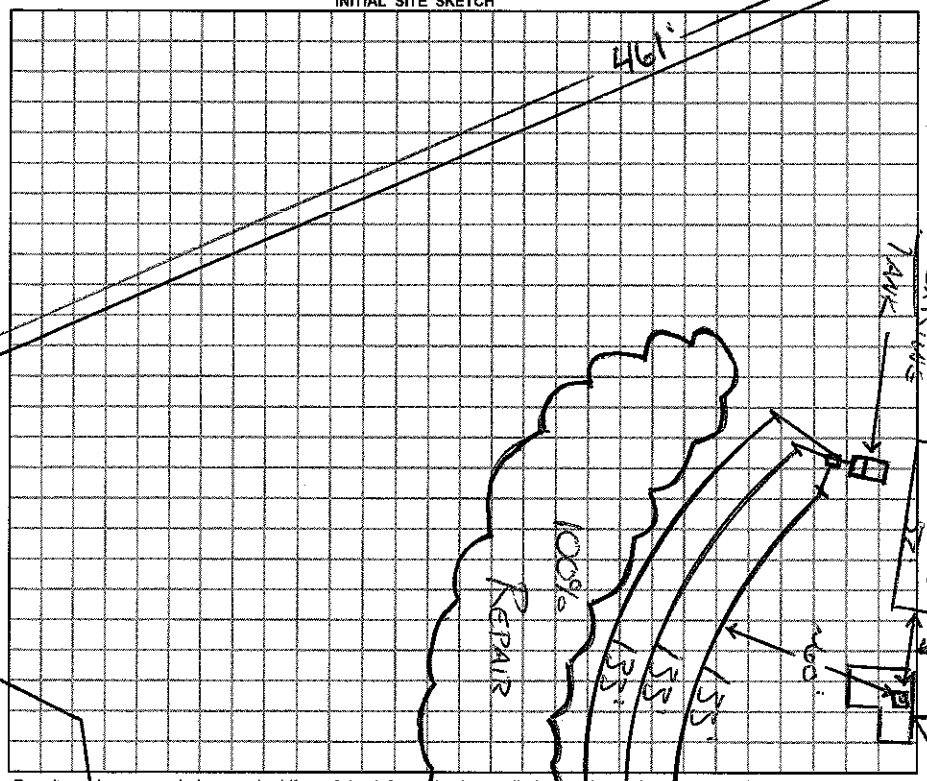

AS BUILT SKETCH

1) HOUSE MUST BE 25' FROM WELL & 5' FROM SEPTIC

Permit can be suspended or revoked if any false information is supplied toward securing the permit / any unauthorized changes are made to the site / any unauthorized changes are made in the installation of the system.

☐ *IMPROVEMENT PERMIT w / plat valid without expiration.* ☐ *IMPROVEMENT PERMIT w / site plan valid for 60 mos.* ☐ *AUTHORIZATION TO CONSTRUCT valid for period equal to IMPROVEMENT PERMIT-not to exceed 60 mo.*

Owner / Applicant Signature: [signature] Date 5-27-10

Improvement Permit by: Date

Authorization to Construct by: Date

YOU SHOULD CONTACT A LOCATOR SERVICE BEFORE ANY EXCAVATION.

Installed by:

Operation Permit by: Date:

Existing System Inspected by: [signature] Date: 5-26-10

WHITE COPY Environmental Health YELLOW COPY (Final) Owner / Applicant PINK COPY (Initial) Owner / Applicant