IREDELL COUNTY HEALTH DEPARTMENT

STATESVILLE 704-878-5305 MOORESVILLE 704-664-5281

IMPROVEMENT PERMIT / CERTIFICATE OF COMPLETION / OPERATION PERMIT / EXISTING SYSTEM INSPECTION

PROPERTY DESCRIPTION NO. 18440 DATE 5/16/94 TAX MAP NO. 4E 3A 46 Watershed: ☐ Yes ☑ No

OWNER OR CONTRACTOR LAURIN COOK PHONE: Business 4649-87-8604 Home 664-5705

ADDRESS 122 LITTLE CREEK MOORESVILLE, NC 28115

LOCATION SORRELL LANE; ON ⓛ TOWARD REAR CUL DE SAC

SUBDIVISION PALMINO PARK BLOCK / SECTION II LOT 46 LOT AREA 30,937 SITE CLASS. P DESIGN FLOW 360 L.T.A.R. .3

Septic Tank: 1000 Gallons; STB 794 Bellinger Date 6-10-94

Pump Tank: ____ Gallons; PT ____ Date ____

Pump Make: ____ Model ____ Serial No. ____

Nitrification Field: No Fields 1 Square Feet 1200 Linear Feet 400

No Lines 4 Trench Width 3' Max Trench Bottom Depth 36" Gravel Depth 12"

☑ New System ☐ Repair System Type: I, ⓘ, III, IV, V, VI

System Description: DIST. BOX - CONV.

Repair System Description: CONV.

Maintenance Agreement Required: ☐ Yes ☑ No

☐ House/Mod. Home ☑ Mobile Home ☐ Business ☐ Other

No. Bedrooms 3 No. Bathrooms 2 No. Employees ____


☐ Slab ☑ Crawl Space ☐ Basement w/plumbing ☐ Basement wo/plumbing

Water Supply: ☑ Individual ☐ Community ☐ Public


Comments: Trench depth no more than 36" to bottom of trench. Lines on slope contour in manner shown here.

Comments: Installed in 5 trenches @ 3' x 80'

INITIAL SITE SKETCH

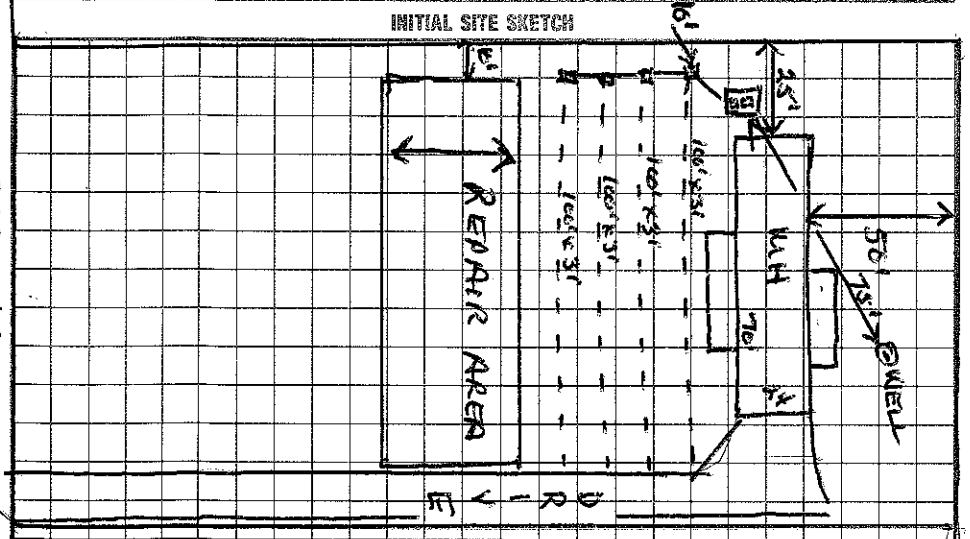

AS BUILT SKETCH

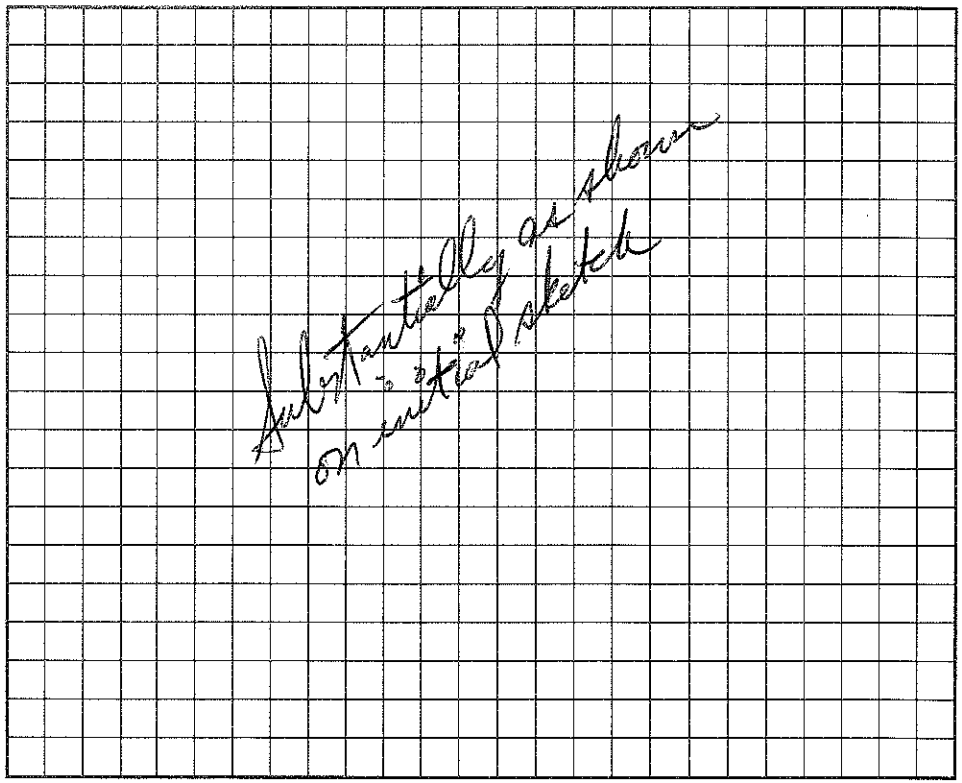

I understand that this permit can be suspended or revoked if any false information is supplied toward securing the permit/any unauthorized changes are made to the site/any unauthorized changes are made in the installation of the system. Improvement Permit is valid for 60 months from date of issuance.

Signed: [signature]

Improvement Permit by: Wesley Sparks RS. date 5/16/94

Existing System Inspection by: ____ date ____

Installed by: Barry Thompson

Certificate of Completion by: [signature] RS date 8/4/94

Operation Permit by: ____ date ____

HEALTH DEPT. COPY: WHITE INSPECTION COPY (FINAL): GREEN OWNER COPY (FINAL): YELLOW INSPECTION COPY (INITIAL): PINK OWNER COPY (INITIAL): GOLD