IREDELL COUNTY HEALTH DEPARTMENT

STATESVILLE 704-878-5305 Paid 175.00 MOORESVILLE 704-664-5281 4.00

IMPROVEMENT PERMIT / AUTHORIZATION TO CONSTRUCT / OPERATION PERMIT / EXISTING SYSTEM INSPECTION

PERMIT# 092079 PIN# 4659 08 261 PT of. 4649951230 DATE 10/20/00

OWNER OR CONTRACTOR Pruitt Development PHONE: Business 660-5903 Home

ADDRESS 142 Stubbs Rd. Mooresville, NC. 28117

LOCATION 115 N TL Sailwinds TL Capital Bay TR Clear Springs Rd., on (L) side of cul-de-sac

SUBDIVISION Windward Pointe BLOCK / SECTION 3 LOT 161 LOT AREA [redacted] SITE CLASS. PS DESIGN FLOW 360 L.T.A.R. .3

Septic Tank: 1000 Gallons; STB 312 Date 9-18-00

Pump Tank: Gallons; PT Date

Pump Make: Model Serial No.

Nitrification Field: No Fields 1 Square Feet 900 * Linear Feet 300 *

No Lines 4@75' Trench Width 3' Max Trench Bottom Depth 3' Gravel Depth SAND.

[X] New System [ ] Repair System Type: I II III IV V VI

System Description: * Gravity - Ch. Plastic 25% IR Reduction

Repair System Description:

Maintenance Agreement Required: [ ] Yes [X] No

[X] House/Mod. Home [ ] Mobile Home [ ] Business [ ] Other

No. Bedrooms 3 No. Bathrooms 2 No. Employees

Water Supply: [X] Individual [ ] Public [ ] Community


[X] Slab [X] Crawl Space [ ] Basement w/plumbing [ ] Basement wo/plumbing

Comments/Conditions:


Comments/Conditions: MH not set up at time of inspection, well not drilled yet. MB

(1" = 50')

INITIAL SITE SKETCH

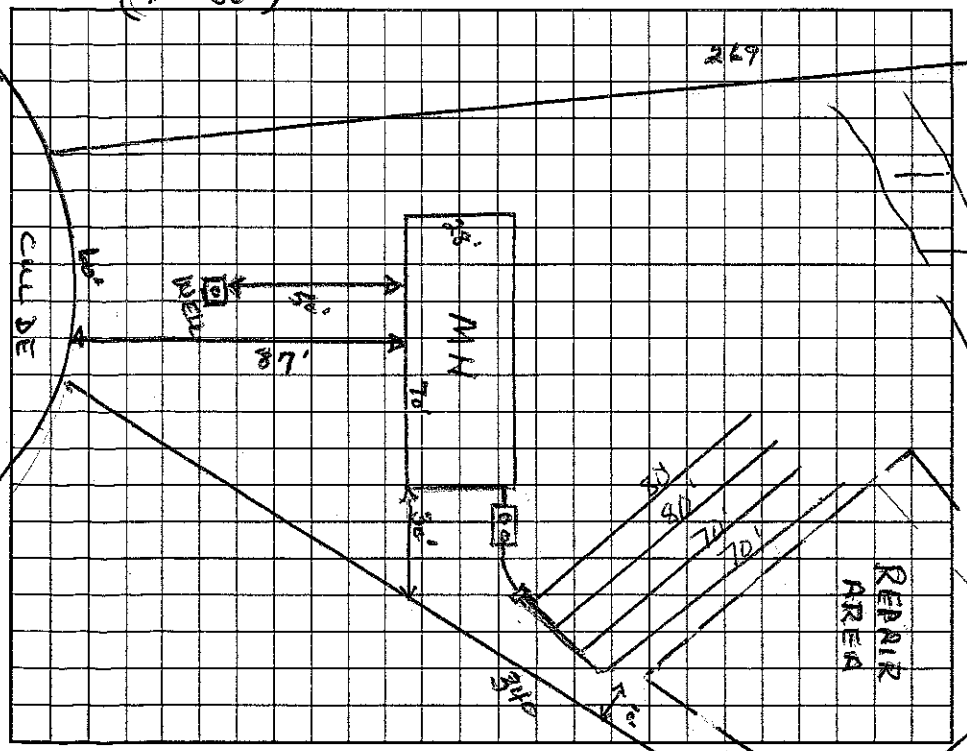

AS BUILT SKETCH

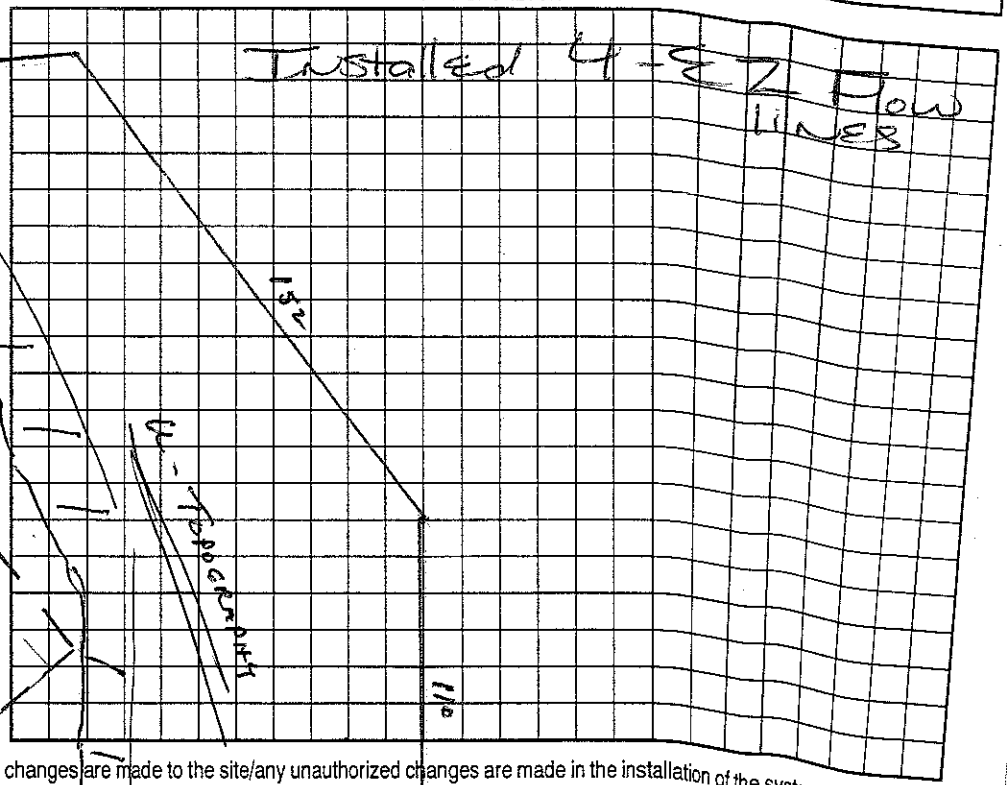

Permit can be suspended or revoked if any false information is supplied toward securing the permit/any unauthorized changes are made to the site/any unauthorized changes are made in the installation of the system. Improvement Permit with plat valid without expiration. Improvement Permit with site plan valid for sixty months. Authorization to Construct is valid for a period equal to that of Improvement Permit – not to exceed sixty months.

Signed: X date 10/20/00 Installed by: Craig Thompson

Improvement Permit by: Wesley Sparks RS. date 10/20/00 Operation Permit by: Maria H Roberts RS date 10/24/2000

Authorization to Construct by: Wesley Sparks RS date 10/20/00 Existing System Inspection by: date

HEALTH DEPT. COPY: WHITE OWNER COPY (FINAL): YELLOW OWNER COPY (INITIAL): PINK