10:00-10:15

IREDELL COUNTY HEALTH DEPARTMENT

STATESVILLE 704-878-5305 MOORESVILLE 704-664-5281

IMPROVEMENT PERMIT / AUTHORIZATION TO CONSTRUCT / OPERATION PERMIT / EXISTING SYSTEM INSPECTIO

PERMIT# 092080 PIN# ~~4659 06 8261 PL~~ 4649953198 DATE 10/23/00

OWNER OR CONTRACTOR Pruitt Dev. Co PHONE: Business 660-5903 Home

ADDRESS 142 Stutts Rd. Mooresville, NC. 28117

LOCATION 115 N TL Sailwinds TL Crystal Bay R Clear Springs L St. Thomas, on (R) below cul de sac

SUBDIVISION Windward Pointe BLOCK / SECTION 3 LOT 143 LOT AREA 1.26 AC SITE CLASS PS DESIGN FLOW 360 L.T.A.R. .3

Septic Tank: 1000 Gallons; STB 1012 Date 3/04/01
Pump Tank: Gallons; PT Date
Pump Make: Model Serial No.
Nitrification Field: No Fields 1 Square Feet 900 ± Linear Feet 300 ±
No Lines 4 @ 75' Trench Width 3' Max Trench Bottom Depth 3'

[X] New System [ ] Repair System Type: I, II, (III), IV, V, VI
System Description: CH PLASTIC or EZ FLOW
Repair System Description: 16" PPBS
Maintenance Agreement Required: [ ] Yes [X] No
~~Gravel Depth~~ SAND


[X] House/Mod. Home No. Bedrooms 3
[ ] Mobile Home No. Bathrooms 3
[ ] Business No. Employees
[ ] Other
[ ] Slab [X] Crawl Space [ ] Basement w/plumbing [ ] Basement wo/plumbing

Water Supply: [X] Individual [ ] Public [ ] Community

Comments:/Conditions:

Comments:/Conditions:

INITIAL SITE SKETCH

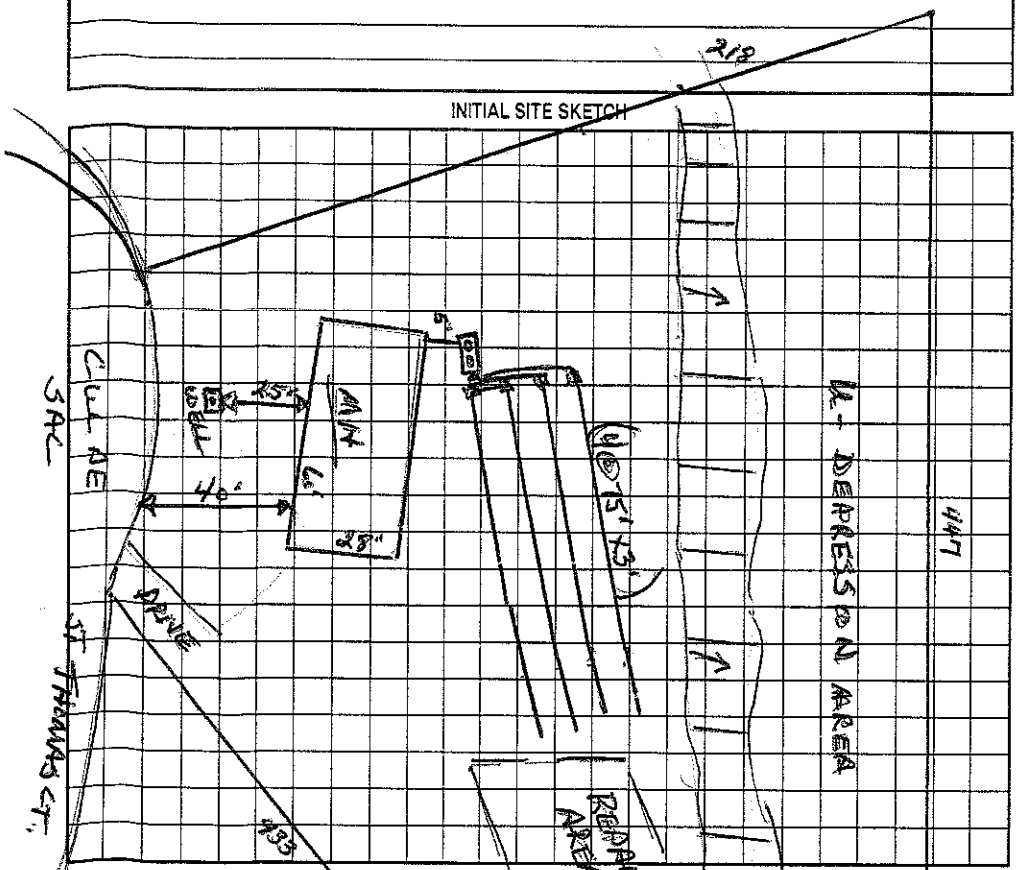

AS BUILT SKETCH

Permit can be suspended or revoked if any false information is supplied toward securing the permit/any unauthorized changes are made to the site/any unauthorized changes are made in the installation of the system. Improvement Permit with plat valid without expiration. Improvement Permit with site plan valid for sixty months. Authorization to Construct is valid for a period equal to that of Improvement Permit – not to exceed sixty months.

Signed: X date

Improvement Permit by: Wesley Sparks RS. date 10/23/00

Authorization to Construct by: Wesley Sparks RS. date 10/23/00

Installed by: A-1 Backhoe

Operation Permit by: Wesley Sparks RS. date 5/11/01

Existing System Inspection by: date

HEALTH DEPT. COPY: WHITE OWNER COPY (FINAL): YELLOW OWNER COPY (INITIAL): PINK