IREDELL COUNTY HEALTH DEPARTMENT

IMPROVEMENT PERMIT / AUTHORIZATION TO CONSTRUCT / OPERATION PERMIT / EXISTING SYSTEM INSPECTION

STATESVILLE 704-878-5305 — MOORESVILLE 704-664-5281

Cathy - 902-5021 11:00

PERMIT# Repair PIN# ~~4649 06 8261~~ 4649953302.000

OWNER OR CONTRACTOR Shelia Hutchinson PHONE: Business 704-500-3456 Sec-3460 Home

ADDRESS 108 St Thomas ct. Trent woo, NC. 28166 DATE 3/22/04

LOCATION 115-21W TL Sailworks TL Capt. Bay TR Clear Springs TR St Thomas Left on (R) Corner

SUBDIVISION Windward Pt. BLOCK / SECTION 3 LOT 162 LOT AREA 1.00 Ac SITE CLASS. PS DESIGN FLOW 360 L.T.A.R. .3

Septic Tank: EXIST. Gallons; STB Date


Pump Make: MYERS Model ~~ME50-511~~ Serial No. 25315200

Nitrification Field: No Fields 1 Square Feet 1200 Linear Feet 400

No Lines 5@80' Trench Width 3' Max Trench Bottom Depth 3 Gravel Depth N/A

☒ New System ☐ Repair System Type: I, II, III, IV, V, VI

System Description:

Repair System Description: Pressure w/ 25% Reduction

Maintenance Agreement Required: ☐ Yes ☒ No

☐ Slab ☒ Crawl Space ☐ Basement w/plumbing ☐ Basement wo/plumbing

☐ House/Mod. Home No. Bedrooms 4

☐ Mobile Home No. Bathrooms 3

☐ Business No. Employees


☐ Other

Water Supply: ☒ Individual ☐ Public ☐ Community

Comments:/Conditions:

Comments:/Conditions: Bedrooms changed from original AC - Extensive filling and stump removal done over entire N area. Will gutters chain over original systems area. Large tree stumps removed from between drainlines.

INITIAL SITE SKETCH

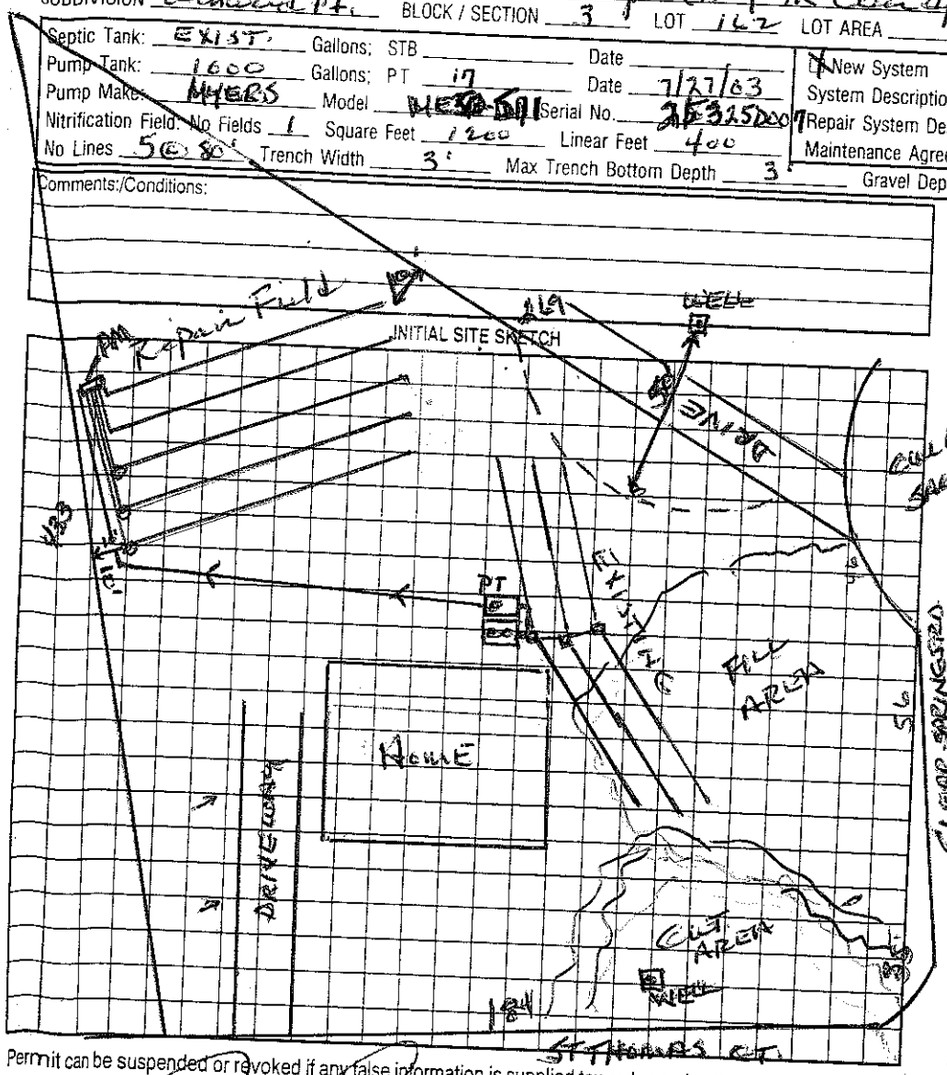

AS BUILT SKETCH

4/21/04 Phone conversation w/ Shelia Hutchinson System connected and Plumbing checked by plumber, "No Leaks found" in Admin.

Infiltrator installed as shown on repair permit

5/3/04 - Metered on well, original reading "0".

Permit can be suspended or revoked if any false information is supplied toward securing the permit/any unauthorized changes are made to the site/any unauthorized changes are made in the installation of the system. Improvement Permit with plat valid without expiration. Improvement Permit with site plan valid for sixty months. Authorization to Construct is valid for a period equal to that of Improvement Permit -- not to exceed sixty months.

Signed: X date 3-25-04

Improvement Permit by: Wesley Sparks R.S. date 3/22/04

Authorization to Construct by: Wesley Sparks R.S. date 3/22/04

Installed by: Craig Thompson

Operation Permit by: Wesley Sparks RS date 4/23/04

Existing System Inspection by: date

HEALTH DEPT. COPY: WHITE OWNER COPY (FINAL): YELLOW OWNER COPY (INITIAL): PINK