IREDELL COUNTY HEALTH DEPARTMENT

STATESVILLE 704-878-5305 MOORESVILLE 704-664-5281

IMPROVEMENT PERMIT / AUTHORIZATION TO CONSTRUCT / OPERATION PERMIT / EXISTING SYSTEM INSPECTION

PERMIT# 091631 PIN# 4659 06 8261 Pt. DATE 12/11/00

OWNER OR CONTRACTOR Fleetwood - Piedmont Homes PHONE: Business 528-7120 Home

ADDRESS 115-21N Troutman, NC 28166

LOCATION 115-21N TL Sanlwinds TL CapitalBay TR Clear Springs TL St Thomas, corner lot on (R)

SUBDIVISION Windward Point BLOCK / SECTION 3 LOT 162 LOT AREA 1.01 Ac SITE CLASS. PS DESIGN FLOW 360 L.T.A.R. .3

Septic Tank: 1000 Gallons; STB 312 Date 10/20/00

Pump Tank: Gallons; PT Date

Pump Make: Model Serial No.

Nitrification Field: No. Fields 1 Square Feet 900 ✱ Linear Feet 300 ✱

No Lines 3@100' Trench Width 3' Max Trench Bottom Depth 3'

Gravel Depth SAND.

[X] New System [ ] Repair System Type: I, II, (III), IV, V, VI

System Description: GRAV - 25% Reduction System

Repair System Description: Pressure to 25% Reduction

Maintenance Agreement Required: [ ] Yes [X] No

[X] House/Mod. Home [ ] Mobile Home [ ] Business [ ] Other

No. Bedrooms 3 No. Bathrooms 3 No. Employees


[ ] Slab [X] Crawl Space [ ] Basement w/plumbing [ ] Basement wo/plumbing

Water Supply: [X] Individual [ ] Public [ ] Community

Comments:/Conditions:

PRESSURE REPAIR AREA

INITIAL SITE SKETCH (1"=50')

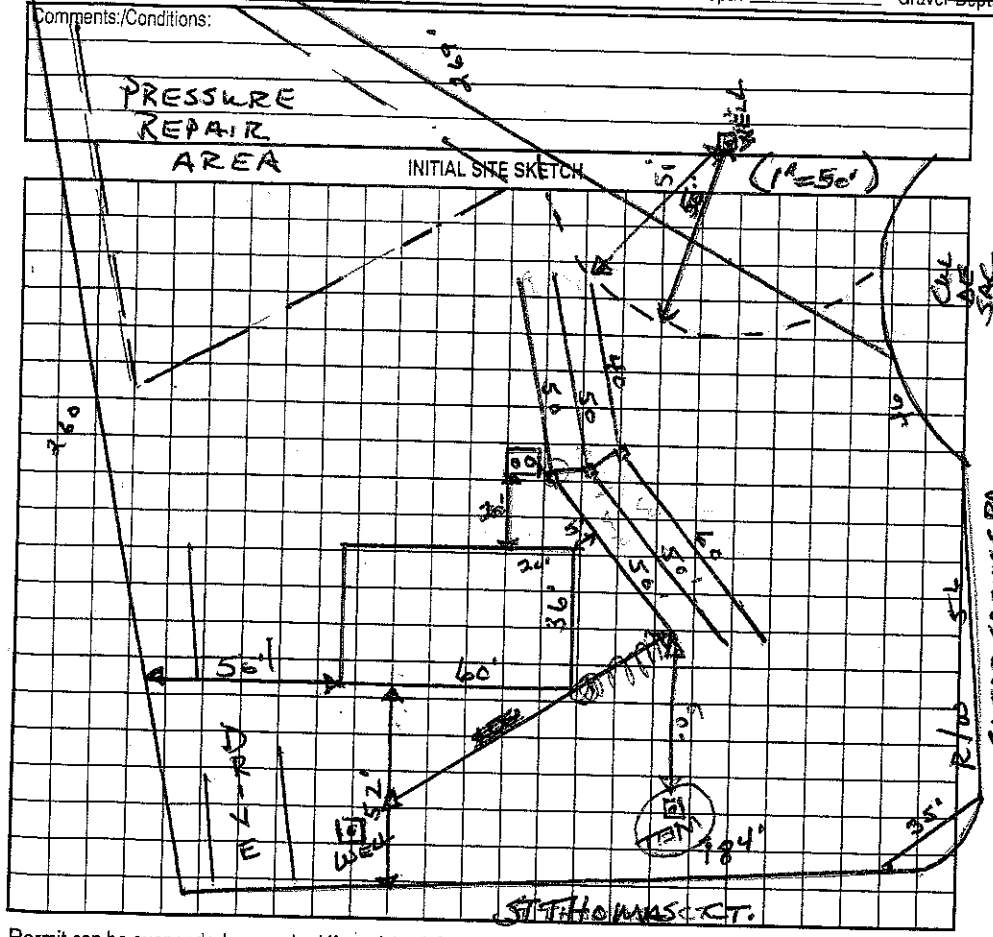

Comments:/Conditions: S.2 Flow installed.
D/W location moved but still 40' from closest drain line.

AS BUILT SKETCH

Permit can be suspended or revoked if any false information is supplied toward securing the permit/any unauthorized changes are made to the site/any unauthorized changes are made in the installation of the system. Improvement Permit with plat valid without expiration. Improvement Permit with site plan valid for sixty months. Authorization to Construct is valid for a period equal to that of Improvement Permit – not to exceed sixty months.

Signed: ✱ Darlene Crider date

Improvement Permit by: Wesley Sparks RS. date 12/11/00

Authorization to Construct by: Wesley Sparks RS. date 12/11/00

Installed by: Craig Thompson

Operation Permit by: Wesley Sparks RS. date 12/13/00

Existing System Inspection by: date

HEALTH DEPT. COPY: WHITE OWNER COPY (FINAL): YELLOW OWNER COPY (INITIAL): PINK