IREDELL COUNTY HEALTH DEPARTMENT

STATESVILLE 704-87[illegible] MOORESVILLE 704-664-5281

IMPROVEMENT PERMIT / AUTHORIZATION TO CONSTRUCT / OPERAT[illegible]ERMIT / EXISTING SYSTEM INSPECTION

PERMIT# 105314 PIN# 4649-95-3734 DATE 7/16/04

OWNER OR CONTRACTOR Fleetwood PHONE: Business 704 527 7128 Home

ADDRESS 1040 Charlotte Hwy Troutman NC 28166

LOCATION 115/21N, TL Sail Winds, TL Crystal Bay, TR Clear Springs on Rt

SUBDIVISION Windward Pt. BLOCK / SECTION 3 LOT 155 LOT AREA 0.624C SITE CLASS. PS DESIGN FLOW 480 L.T.A.R. 0.3

Septic Tank: 1000 Gallons; STB 1012 Date 2/17/04

Pump Tank: ____ Gallons; PT ____ Date ____

Pump Make: ____ Model ____ Serial No. ____

Nitrification Field: No Fields 1 Square Feet 700 Linear Feet 400

No Lines 8 Trench Width 36" Max Trench Bottom Depth 24" Gravel Depth —

☒ New System ☐ Repair System Type: I, II, III, IV, V, VI

System Description: Gravity 25% Reduction

Repair System Description: Same

Maintenance Agreement Required: ☐ Yes ☒ No

☐ House/Mod. Home ☒ Mobile Home ☐ Business ☐ Other

No. Bedrooms 4 No. Bathrooms 2 No. Employees ____


☐ Slab ☒ Crawl Space ☐ Basement w/plumbing ☐ Basement wo/plumbing

Water Supply: ☒ Individual ☐ Public ☐ Community

Comments:/Conditions:

Comments:/Conditions:

INITIAL SITE SKETCH

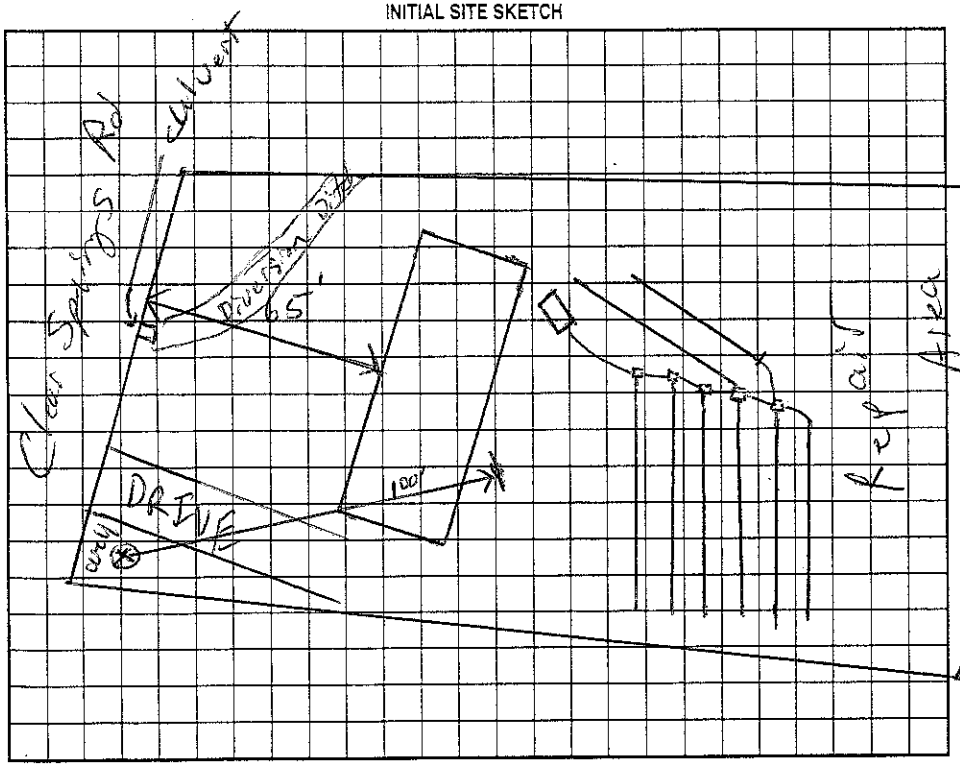

AS BUILT SKETCH

Permit can be suspended or revoked if any false information is supplied toward securing the permit/any unauthorized changes are made to the site/any unauthorized changes are made in the installation of the system. Improvement Permit with plat valid without expiration. Improvement Permit with site plan valid for sixty months. Authorization to Construct is valid for a period equal to that of Improvement Permit – not to exceed sixty months.

Signed: [signature] date 7-29-04

Improvement Permit by: [signature] RS date 7/16/04

Authorization to Construct by: [signature] RS date 7/16/04

Installed by: Craig Tramp son

Operation Permit by: [signature] RS date 7-30-04

Existing System Inspection by: ____ date ____

HEALTH DEPT. COPY: WHITE OWNER COPY (FINAL): YELLOW OWNER COPY (INITIAL): PINK