IREDELL COUNTY HEALTH DEPARTMENT

STATESVILLE 704-878-5305 MOORESVILLE 704-664-5281

IMPROVEMENT PERMIT / AUTHORIZATION TO CONSTRUCT / OPERATION PERMIT / EXISTING SYSTEM INSPECTION

125.00 4:00

PERMIT# 091077 PIN# ~~4659 06 8361~~ PT. 4649954749 DATE 10/13/00

OWNER OR CONTRACTOR Pruitt Dev. Co / OAKWOOD PHONE: Business 663-6700 Home

ADDRESS 142 Stutts Rd. Mooresville, NC. 28117

LOCATION 115 N TL Sailwinds TL Crystal Bay TR Clear Springs to 13th lot on (R) 228

SUBDIVISION Windward Pointe BLOCK / SECTION 3 LOT 154 LOT AREA .59 AC SITE CLASS A-1 DESIGN FLOW 360 L.T.A.R. .3

Septic Tank: 1000 Gallons; STB 1012 Date 11/13/02

Pump Tank: Gallons; PT Date

Pump Make: Model Serial No.

Nitrification Field: No Fields 1 Square Feet 900 ± Linear Feet 300 ±

No Lines 5@60' Trench Width 3' Max Trench Bottom Depth 3' Gravel Depth SAND

[X] New System [ ] Repair System Type: I, II, (III), IV, V, VI

System Description: GRAV-EZ FLOW OR ~~CHI PLAS~~

Repair System Description: ~~1000~~ 1/4" PPBPS

Maintenance Agreement Required: [ ] Yes [X] No

[ ] House/Mod. Home No. Bedrooms 3

[X] Mobile Home No. Bathrooms 3

[ ] Business No. Employees

[ ] Other

[ ] Slab [X] Crawl Space [ ] Basement w/plumbing [ ] Basement wo/plumbing


Water Supply: [X] Individual [ ] Public [ ] Community

Comments:/Conditions:


Comments:/Conditions: 4@75'x3' Ch. PLASTIC INSTALLED.

1" = 50'

INITIAL SITE SKETCH

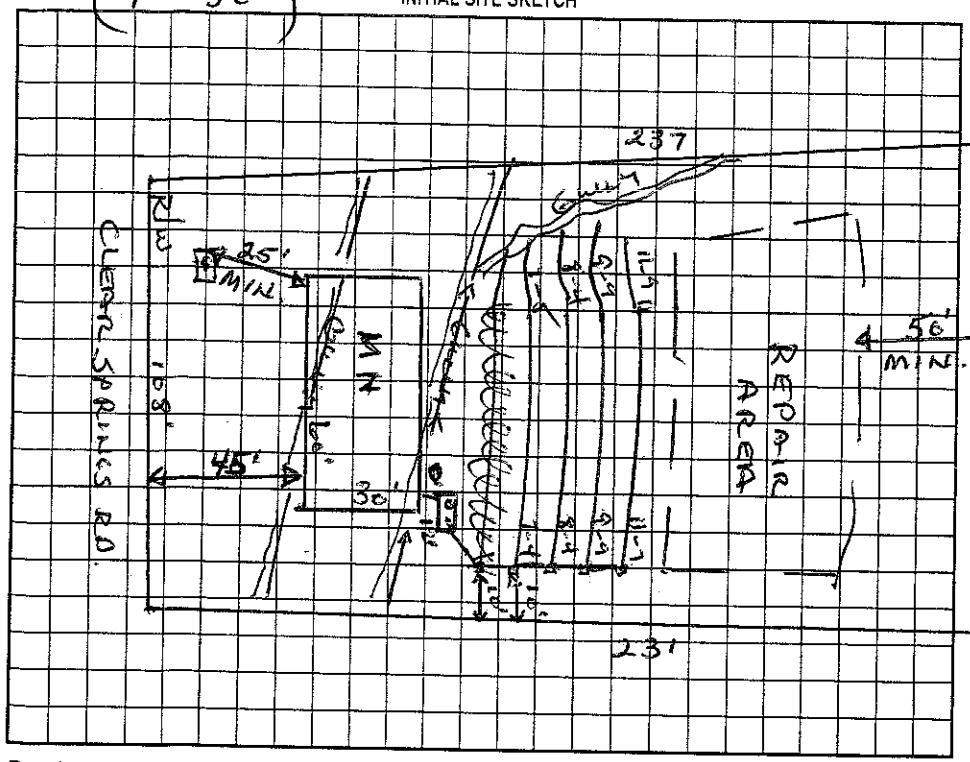

AS BUILT SKETCH

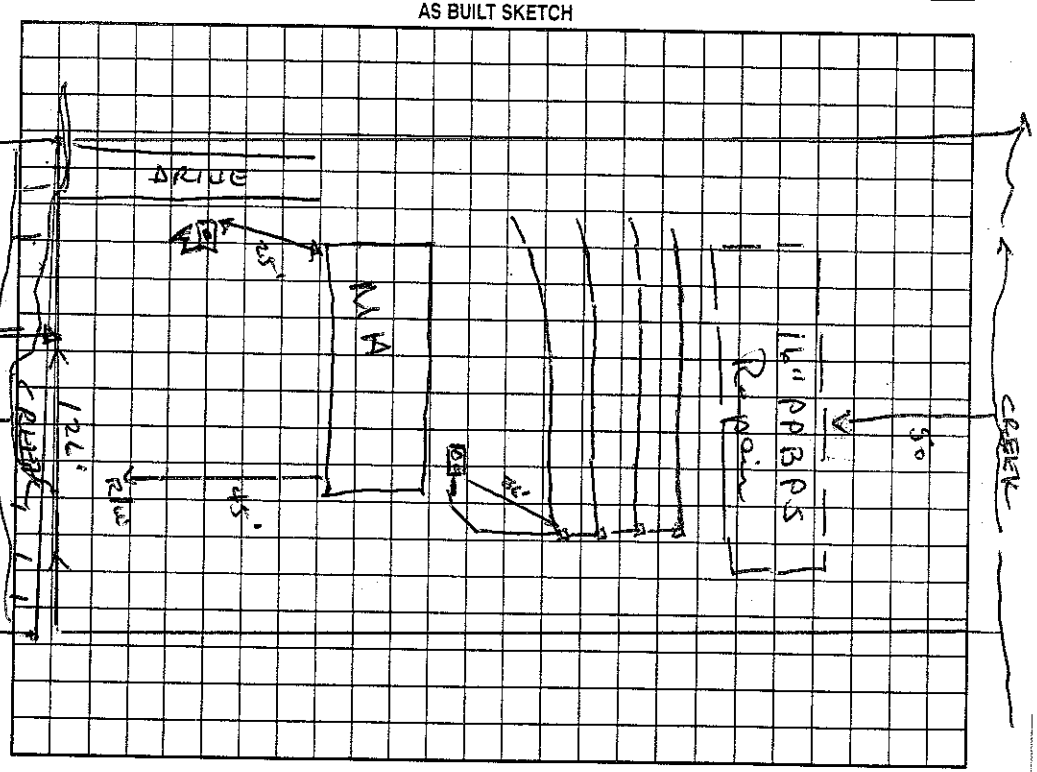

Permit can be suspended or revoked if any false information is supplied toward securing the permit/any unauthorized changes are made to the site/any unauthorized changes are made in the installation of the system. Improvement Permit with plat valid without expiration. Improvement Permit with site plan valid for sixty months. Authorization to Construct is valid for a period equal to that of Improvement Permit – not to exceed sixty months.

Signed: X date 10-16-00

Improvement Permit by: Wesley Sparks R.S. date 10/13/00

Authorization to Construct by: Wesley Sparks R.S. date 10/13/00

Installed by: Craig Thompson

Operation Permit by: Wesley Sparks R.S. date 1/10/03

Existing System Inspection by: date

HEALTH DEPT. COPY: WHITE OWNER COPY (FINAL): YELLOW OWNER COPY (INITIAL): PINK