IREDELL COUNTY HEALTH DEPARTMENT

STATESVILLE 704-878-5305 125.00 Paid MOORESVILLE 704-664-5281

IMPROVEMENT PERMIT / AUTHORIZATION TO CONSTRUCT / OPERATION PERMIT / EXISTING SYSTEM INSPECTION

PERMIT# 092170 PIN# ~~4659 66 8264~~ 4649955467.000 DATE 12/29/00

OWNER OR CONTRACTOR Pruitt Dev. Co. PHONE: Business 660-5903 Home

ADDRESS 142 Stutts Rd. Statesville, NC. 28117

LOCATION 115-21N TL Sailwinds TL Crystal Bay TR Clear Springs RD TL St Thomas Ct, 2ND lot on (L)

SUBDIVISION Windward Pointe BLOCK / SECTION 3 LOT 166 LOT AREA .67Ac SITE CLASS. PS DESIGN FLOW 360 L.T.A.R. .3

Septic Tank: 1000 Gallons; STB 1012 Date 8/17/03

Pump Tank: ~~1000~~ Gallons; PT Date

Pump Make: Model 426 Serial No.

Nitrification Field(s) Fields 1 Square Feet 430 Linear Feet 200

No Lines ~~3@70'~~ Trench Width 3' Max Trench Bottom Depth 36" Gravel Depth SAND

[X] New System [ ] Repair System Type: I, II, ~~III~~, V, VI

System Description: PM – 16" PPBS (50% Red)

Repair System Description: Same

Maintenance Agreement Required: [ ] Yes [X] No

[ ] House/Mod. Home No. Bedrooms 3

[ ] Mobile Home No. Bathrooms 3

[ ] Business No. Employees


[ ] Other

[ ] Slab [X] Crawl Space [ ] Basement w/plumbing [ ] Basement wo/plumbing

Water Supply: [X] Individual [ ] Public [ ] Community


Comments:/Conditions: Drain with pump due to extensive area that will be effected by grading and filling operation. 1/23/04 - Changed to gravity on inlet, kept below problem area - 4@50'±

INITIAL SITE SKETCH (1" = 50')

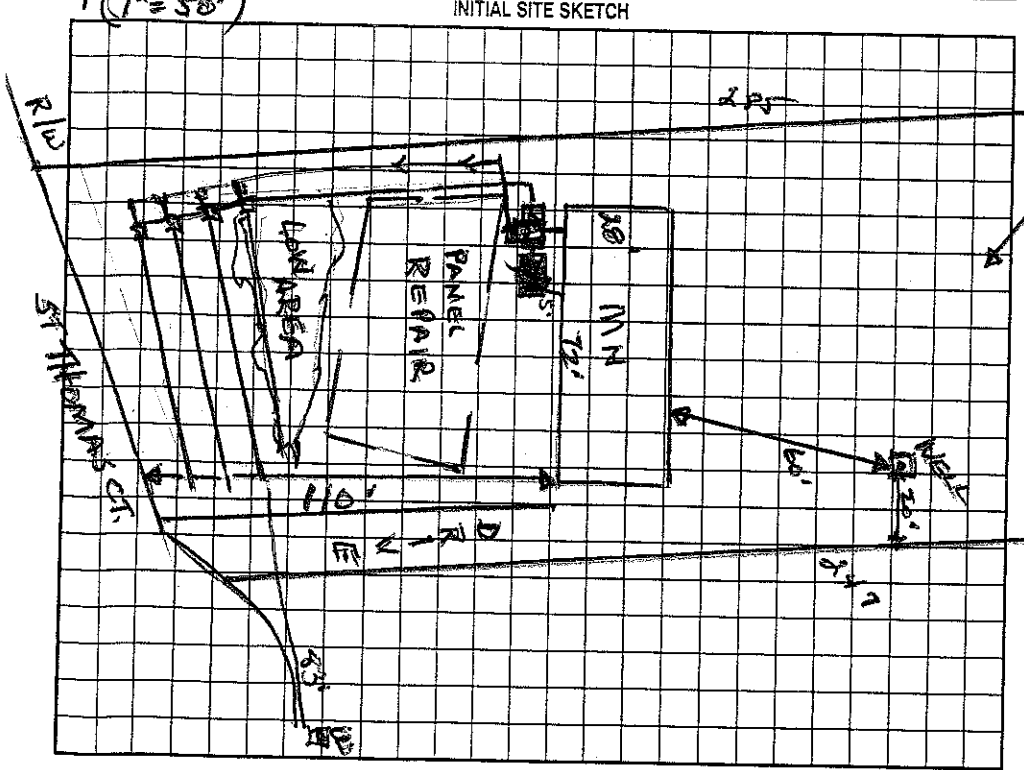


Comments:/Conditions:

216
2
432

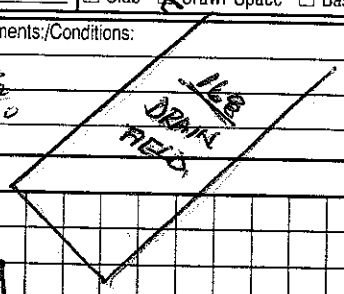

AS BUILT SKETCH

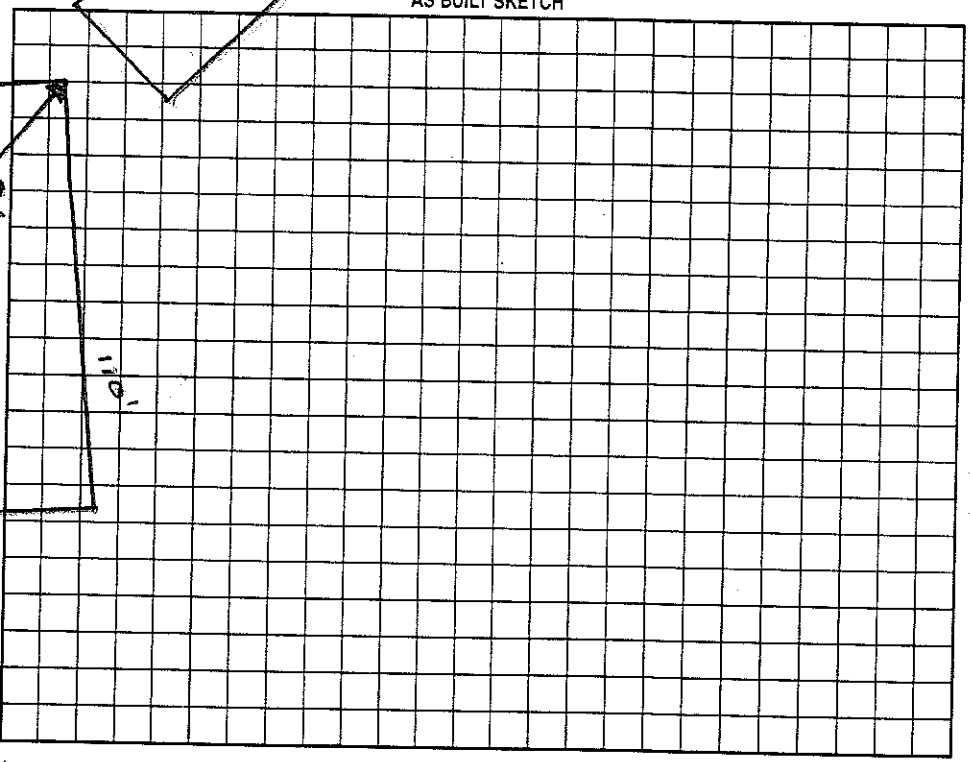

Permit can be suspended or revoked if any false information is supplied toward securing the permit/any unauthorized changes are made to the site/any unauthorized changes are made in the installation of the system. Improvement Permit with plat valid without expiration. Improvement Permit with site plan valid for sixty months. Authorization to Construct is valid for a period equal to that of Improvement Permit – not to exceed sixty months.

Signed: Emily Cronch date 1/4/01

Improvement Permit by: Wesley Sparks R.S. date 12/29/00

Authorization to Construct by: Wesley Sparks R.S. date 12/29/00

Installed by: Craig Thompson

Operation Permit by: Wesley Sparks R.S. date 1/23/04

Existing System Inspection by: date

HEALTH DEPT. COPY: WHITE OWNER COPY (FINAL): YELLOW OWNER COPY (INITIAL): PINK