Redraw

IREDELL COUNTY HEALTH DEPARTMENT

STATESVILLE 704-878-5305 MOORESVILLE 704-664-5281

IMPROVEMENT PERMIT / AUTHORIZATION TO CONSTRUCT / OPERATION PERMIT / EXISTING SYSTEM INSPECTION

PERMIT# 144231 PIN# 4649955506 DATE 10/10/07

OWNER OR APPLICANT Full Spectrum Realty PHONE: Business 400-7019 Home

ADDRESS 155 D S Eastway Dr.

LOCATION Hwy 115 N TL Sailwinds TL Crystal Bay TR Clear Spring on Left 6 St Thomas Ct.

SUBDIVISION Windward Pt. BLOCK / SECTION 3 LOT 167 LOT AREA .82ac SITE CLASS PS DESIGN FLOW 360 L.T.A.R. @ 35

Septic Tank: 1000 Gallons; STB 786 Date 6-1-07
Pump Tank: Gallons; PT Date
Pump Make: Model Serial No.
Nitrification Field: No Fields Square Feet Linear Feet 258'
No Lines 3@86' Trench Width 36" Max Trench Bottom Depth 36"

☑ New System ☐ Repair ☐ Expansion System Type: I (II) III IV V VI
System Description: Gravity 25% Reduction
Repair System Description: Pump-Panel Blk
Maintenance Agreement Required: ☐ Yes ☑ No Initial

☑ House/Mod. Home No. Bedrooms 3
☐ Mobile Home No. Persons
☐ Business No. Employees
☐ Other

Water Supply: ☑ Individual ☐ Public ☐ Community


Gravel Depth N/A ☐ Gravity ☐ Pressure ☐ Slab ☑ Crawl Space ☐ Basement w/plumbing ☐ Basement wo/plumbing

Comments/Conditions: Use D-box for equal distribution


Comments/Conditions:

Scale 1:40

INITIAL SITE SKETCH

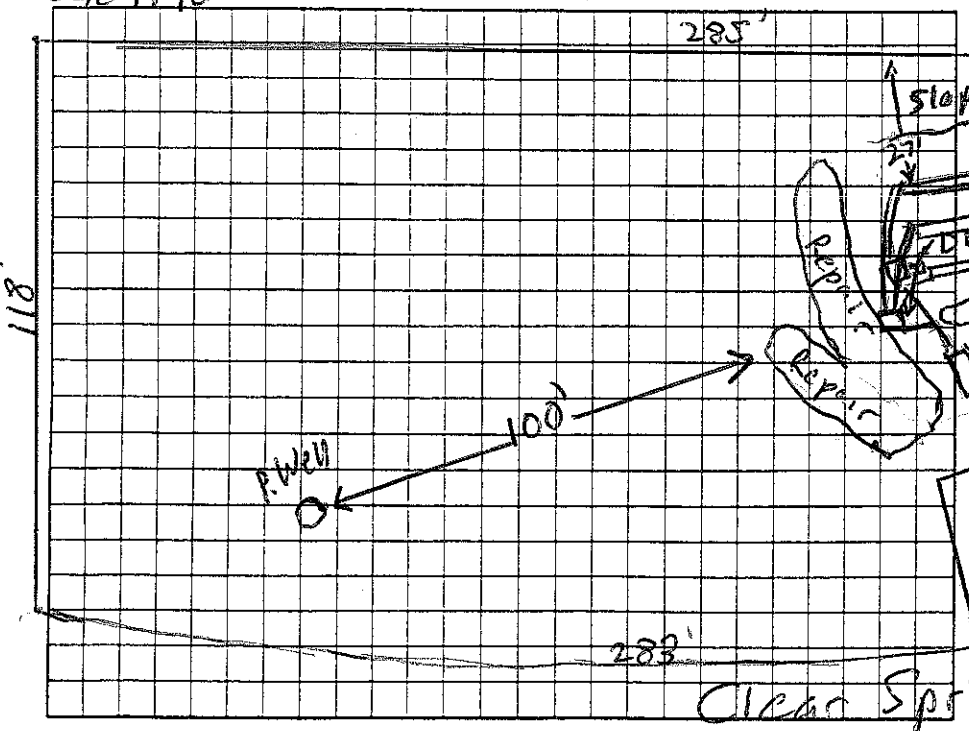

AS BUILT SKETCH

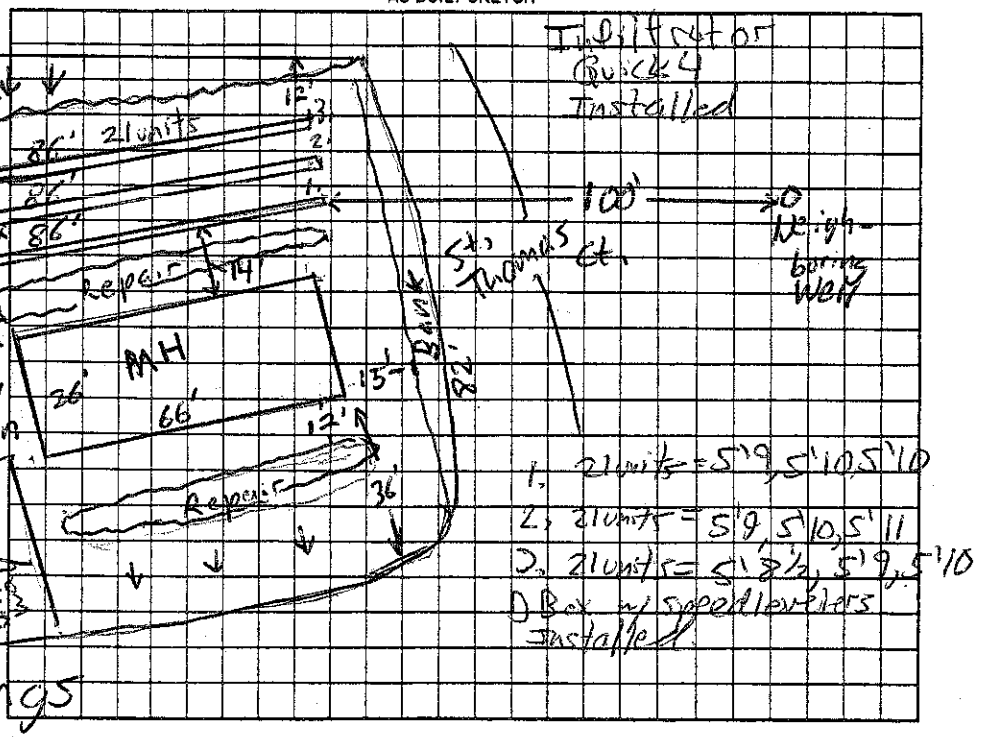

Permit can be suspended or revoked if any false information is supplied toward securing the permit/any unauthorized changes are made to the site/any unauthorized changes are made in the installation of the system. Improvement Permit with plat valid without expiration ☐ Improvement Permit with site plan valid for sixty months ☑ Authorization to Construct is valid for a period equal to that of Improvement Permit – not to exceed sixty months.

Signed: date 10/10/07 Installed by: Buck Grading

Improvement Permit by: Anthony Cohen Jr. date 10/10/07 Operation Permit by: Anthony Cohen Jr. date 10/12/07

Authorization to Construct by: Anthony Cohen Jr. date 10/10/07 Existing System Inspection by: date

HEALTH DEPT. COPY: WHITE OWNER COPY (FINAL): YELLOW OWNER COPY (INITIAL): PINK