IREDELL COUNTY HEALTH DEPARTMENT

Statesville Office (704) 878-5305 Mooresville Office (704) 660-3625 PERMIT # 215980

MD

IMPROVEMENT PERMIT / AUTHORIZATION TO CONSTRUCT / OPERATION PERMIT / EXISTING SYSTEM

PIN # 4649-95-6857

APPLICANT: ERIC WARD APPLICANT ADDRESS: 1124 CHARLOTTE HWY TROUTMAN, NC

SITE ADDRESS: 220 CLEAR SPRINGS Rd - Mrwl PHONE: 704-883-6148 ALT. PHONE:

SITE DIRECTIONS: 21 N, TL CLEAR SPRINGS, ON R

SUBDIVISION: WINDWARD POINT SECTION: 3 LOT # 152 LOT AREA: .56 AC DESIGN FLOW: 360 L.T.A.R.: .3 (.35R)

Septic Tank 1000 (gal) STB 794 - Petitgage Date 6-24-15
Pump Tank (gal) PT Date
Pump Make Model Serial #
Nitrification Fields 1 # Lines 4 C 75' Linear Ft: 300'
Trench Width 36" Max. Trench Bottom Depth X 28" X Gravel Depth —


☒ New System ☐ Repair ☐ Expansion System Type: I II (III) IV V VI
System Description: 25% REDUCTION
Repair System Description: PANEL BLOCK
Maintenance Agreement Required: ☐ YES ☒ NO
☒ GRAVITY ☐ PRESSURE

☒ Residence No. Bedrooms 3
☐ Business No. Persons
☐ Other No. Employees
☐ Slab ☒ Crawl Space
☐ Basement w/plumbing ☐ Basement w/o plumbing


Water Supply: ☒ Private ☐ Public ☐ Community

Comments / Conditions:

INITIAL SITE SKETCH

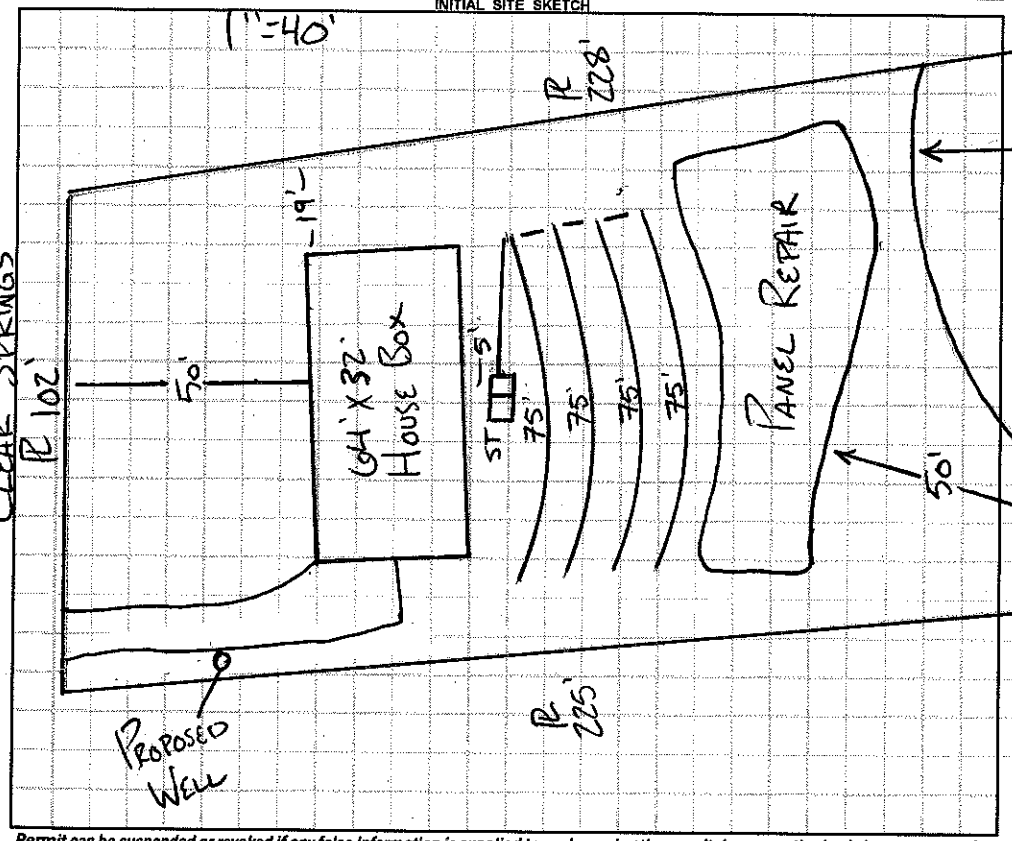

AS BUILT SKETCH

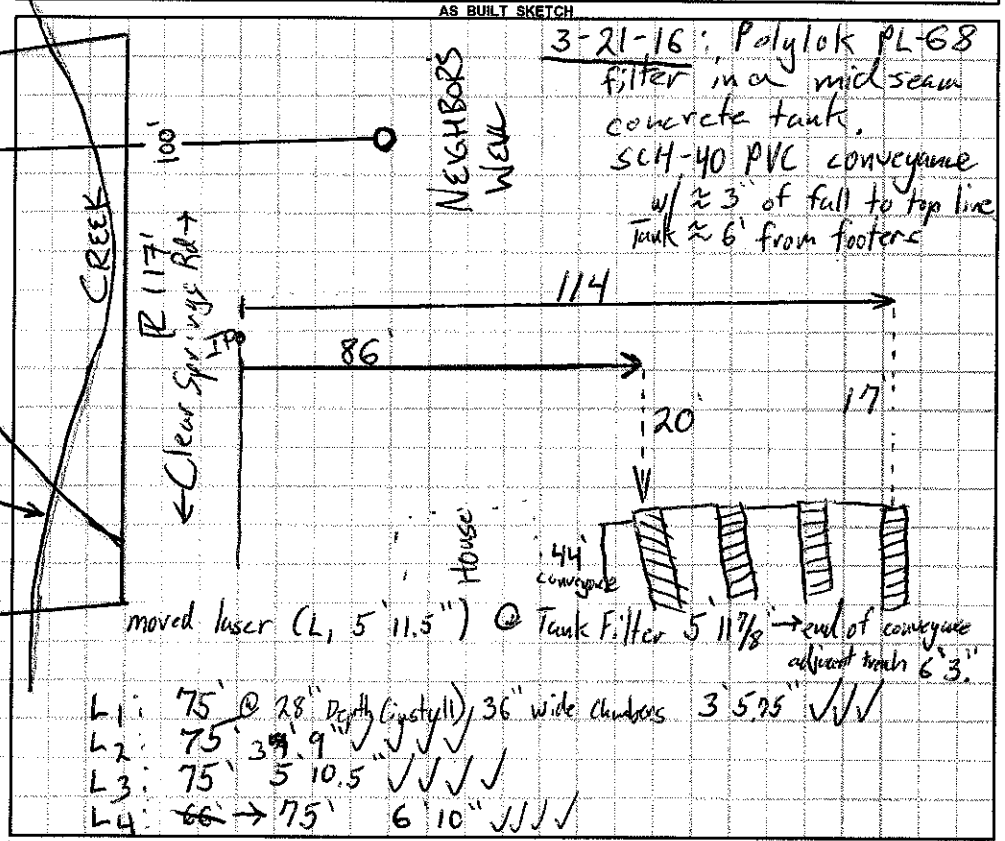

Permit can be suspended or revoked if any false information is supplied toward securing the permit / any unauthorized changes are made to the site / any unauthorized changes are made in the installation of the system. **CONTACT A LOCATOR SERVICE PRIOR TO ANY EXCAVATION**

☐ **IMPROVEMENT PERMIT** *with plat valid without expiration.* ☐ **IMPROVEMENT PERMIT** *with site plan valid for 60 mos.* ☑ **AUTHORIZATION TO CONSTRUCT** *valid for period equal to IMPROVEMENT PERMIT--not to exceed 60 mo.*

Owner / Applicant Signature: Date: 2/3/16 Installed by: Marty Tucker

IMPROVEMENT PERMIT by: APPROVED Date: JAN 28 2016 OPERATION PERMIT by: Thomas Shuck Date: 3-21-16

AUTHORIZATION TO CONSTRUCT by: APPROVED Date: JAN 28 2016 Existing System Inspected by: Date:

Health Dept. Copy - WHITE Applicant (Final Approval) - YELLOW Applicant (Conditional Approval) - PINK