ICHD - ENVIRONMENTAL HEALTH DIVISION

Statesville Office (704) 878-5305 (BB) Mooresville Office (704) 660-3625 PERMIT # 247011

SEPTIC: IMPROVEMENT PERMIT / AUTHORIZATION TO CONSTRUCT / OPERATION PERMIT / EXISTING SYSTEM

PIN # 4649958989

APPLICANT/OWNER: FREEDOM HOMES / CMH HOMES INC APPLICANT ADDRESS: 1124 CHARLOTTE HIGHWAY, TROUTMAN, N.C. 28166

SITE ADDRESS: 208 CLEAR SPRINGS ROAD, MOORESVILLE, NC. 28115 PHONE: 704-881-2326 ALT. PHONE —

SITE DIRECTIONS: (S) ON 77, (R) ON 21, (R) ON CLEAR SPRINGS, LOT ON (R) SAP CONTROLLED: ☐ YES ☑ NO

SUBDIVISION: WINDWARD POINTE SECTION: P3 LOT # 149/150 LOT AREA: 1.04 AC DESIGN FLOW: 480 GPD L.T.A.R.: 0.275


Septic Tank	EXT (1000) (gal)	STB	760	Date	11-11-19	☑ New System	☐ Repair	☐ Expansion	System Type: I II (III) IV V VI
Pump Tank	EXT (1000) (gal)	PT	363	Date	8-22-19	System Description:	25% REDUCTION		
Pump Make	GOULDS	Model	PES1M	Serial #	L1938826	Repair System Description:	50% REDUCTION		
# Nitrification Fields	1	# Lines	7	Linear Ft	438 FT	Maintenance Agreement Required:	☐ YES	☑ NO	
Trench Width	36 IN	Trench Bottom Depth(Low side)	31 IN	Gravel Depth	—	☐ GRAVITY	☑ PRESSURE		

☑ Residence No. Bedrooms 4 — ☐ Business No. Persons 8 — ☐ Other No. Employees — — ☐ Slab ☑ Crawl Space — ☐ Basement w/plumbing ☐ Basement w/o plumbing

Water Supply: ☑ Private ☐ Public ☐ Community

Comments / Conditions: THE PURPOSE OF THIS PERMIT IS TO REFLECT PROPERTY LINE CHANGES MADE 11-25-2019, PRIOR PERMIT ISSUED 10-16-19 WAS REVOKED 2-10-2020 DUE TO CHANGES.

INITIAL SITE SKETCH

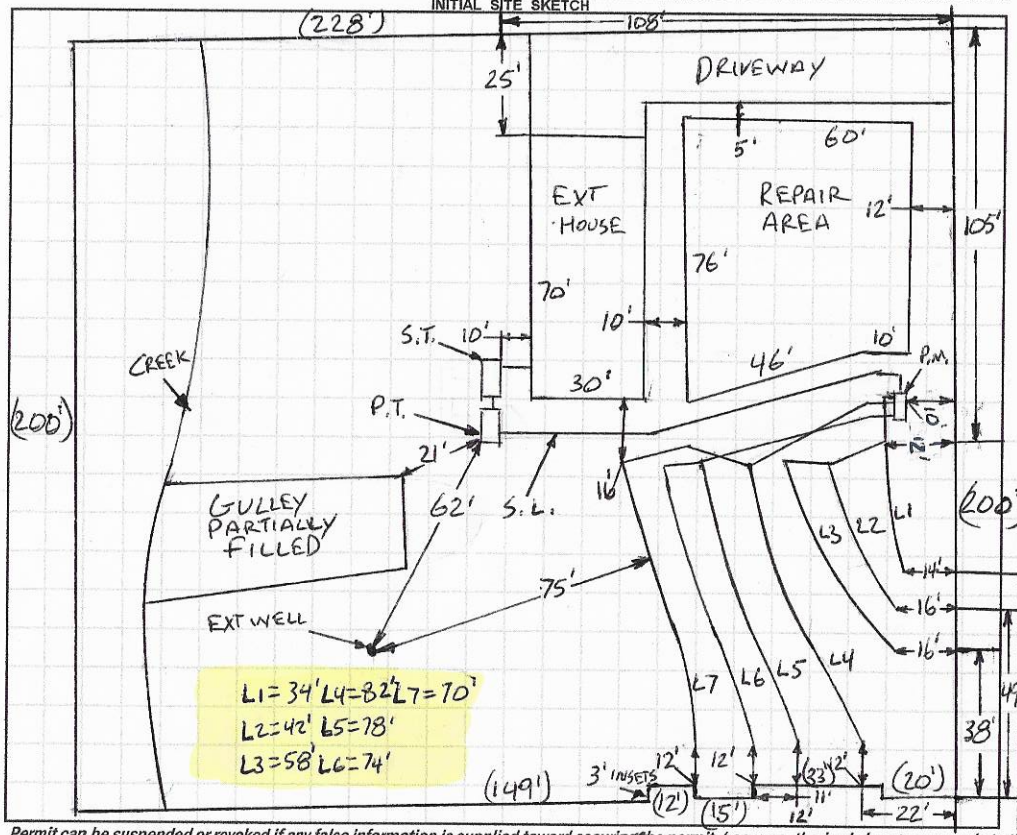

AS BUILT SKETCH

- L1+L2+L3 TO BE FED SERIALLY FROM A 3/4 SCH 80 TAP
- L4+L7 TO BE FED SERIALLY FROM A 3/4 SCH 40 TAP
- L5+L6 TO BE FED SERIALLY FROM A 3/4 SCH 40 TAP

CLEAR SPRINGS ROAD

-35.1 GPM
-206 GAL DOSE VOLUME
- 9 MIN PUMP RUN TIME
- 10 IN DRAW DOWN

1 IN = 50 FT
S.T. = SEPTIC TANK
S.L. = SUPPLY LINE
P.M. = PRESSURE MANIFOLD

INSTALLED AS PERMITTED

Permit can be suspended or revoked if any false information is supplied toward securing the permit / any unauthorized changes are made to the site / any unauthorized changes are made in the installation of the system. **CONTACT A LOCATOR SERVICE PRIOR TO ANY EXCAVATION**

☐ **IMPROVEMENT PERMIT** *with plat valid without expiration.* ☑ **IMPROVEMENT PERMIT** *with site plan valid for 60 mos.* ☑ **AUTHORIZATION TO CONSTRUCT** *valid for period equal to IMPROVEMENT PERMIT--not to exceed 60 mo.*

Owner / Applicant Signature: Kimberly Smith Date: 2-24-2020 Installed by: CRAIG THOMPSON

IMPROVEMENT PERMIT by: Bradford C. White Date: 2-24-2020 OPERATION PERMIT by: Bradford C. White Date: 2-25-2020

AUTHORIZATION TO CONSTRUCT by: Bradford C. White Date: 2-24-2020 Existing System Inspected by: Date:

FOR SEPTIC FINAL INSPECTION: CALL 704-664-3703 between 8am-9am the day the inspection is needed. Be sure to speak with an inpsector to confirm your inspection time.

	Date	Initials
Drain Lines Checked	2-5-2020	BCW
Tanks Checked	2-5-2020	BCW
Pressure Manifold or Valve Box Checked	2-5-2020	BCW
Pressure Head Set	2-25-2020	BCW
Electrical Checked	2-25-20	BCW
Floats Set	2-25-20	BCW
Alarm Checked	2-25-20	BCW
Maintenance Contract Y (N)	2-5-2020	BCW

DEPARTMENT OF HEALTH AND HUMAN SERVICES
DIVISION OF PUBLIC HEALTH, ENVIRONMENTAL HEALTH SECTION
ON-SITE WATER PROTECTION BRANCH

Sheet 1 of 2
PROPERTY ID #: 4649958985
COUNTY: IREDELL

SOIL/SITE EVALUATION
***for* ON-SITE WASTEWATER SYSTEM**
(Complete all fields in full)

OWNER: FREEDOM HOMES — APPLICATION DATE 7-25-19
ADDRESS: 1124 CHARLOTTE HIGHWAY, TROUTMAN, N.C. 28166 — DATE EVALUATED: 8-15-19
PROPOSED FACILITY: 4BR — PROPOSED DESIGN FLOW (.1949): 480 GPD — PROPERTY SIZE: 1.04 AC
LOCATION OF SITE: 208 CLEAR SPRINGS ROAD, MOORESVILLE, N.C. 28115 — PROPERTY RECORDED: YES
WATER SUPPLY: ☒ Private ☐ Public ☒ Well ☐ Spring ☐ Other
EVALUATION METHOD: ☐ Auger Boring ☒ Pit ☐ Cut — TYPE OF WASTEWATER: ☒ Sewage ☐ Industrial Process ☐ Mixed

PROFILE #	.1940 LANDSCAPE POSITION/ SLOPE %	HORIZON DEPTH (IN.)	SOIL MORPHOLOGY (.1941) .1941 STRUCTURE/ TEXTURE	SOIL MORPHOLOGY (.1941) .1941 CONSISTENCE/ MINERALOGY	OTHER PROFILE FACTORS .1942 SOIL WETNESS/ COLOR	OTHER PROFILE FACTORS .1943 SOIL DEPTH	OTHER PROFILE FACTORS .1956 SAPRO CLASS	OTHER PROFILE FACTORS .1944 RESTR HORIZ	PROFILE CLASS & LTAR
1	LINEAR SIDE 5%	0-16	SC, SBK	FR, S, P, SEXP	Y/B REDOX FEATURES THRUOUT SAP INC 30% MICA COMMON	48"+	NA	NA	PS .275
		16-34	C, ABK	FR S, P, SEXP					
		34-48	CL/WABK	FI, SS, SP, SEXP					
2	LINEAR SIDE 5%	0-20	C, SBK	FR, S, P, SEXP	Y/B REDOX FEATURES 0-24" SAP INC 20% MICA COMMON	53"	NA	NA	PS .275
		20-53	CL, WABK	FR, S, SP, SEXP					
		53-60	SAP, MAS	FR, NS, NPSEXP					
3	RIDGE 10% POSSIBLE BERM	0-53	FILL	FILL	MIXED 53-60"	NA	NA	NA	PS IF FILL CUT
		53-60	C, ABK	FI, S, P, SEXP					
4	LINEAR SIDE 5%	0-30	SC, SBK	FR, SS, SP, SEXP	Y/B REDOX FEATURES 0"-22" SAP INC THRUOUT MICA COMMON	60"+	NA	NA	PS .275
		30-60	C, ABK	FI, S, P, SEXP					

DESCRIPTION	INITIAL SYSTEM	REPAIR SYSTEM
Available Space (.1945)	PS	PS
System Type(s)	25%	50%
Site LTAR	0.275	0.275

OTHER FACTORS (.1946): PS
SITE CLASSIFICATION (.1948): PS
EVALUATED BY: Bernard C. White
OTHER(S) PRESENT:

COMMENTS:

Updated February 2014

LEGEND

use the following standard abbreviations

LANDSCAPE POSITION	GROUP	SOIL TEXTURE	CONVENTIONAL .1955 LTAR*	LPP .1957 LTAR*	MINERALOGY/ CONSISTENCE	STRUCTURE
CC (Concave Slope)	I	S (Sand)	1.2 - 0.8	0.6 - 0.4	SEXP (Slightly Expansive)	G (Single Grain)
CV (Convex Slope)		LS (Loamy Sand)			EXP (Expansive)	M (Massive)
D (Drainage Way)						CR (Crumb)
DS (Debris Slump)	II	SL (Sandy Loam)	0.8 - 0.6	0.4 - 0.3		GR (Granular)
FP (Flood Plain)		L (Loam)				SBK (Subangular Blocky)
FS (Foot Slope)						ABK (Angular Blocky)
H (Head Slope)	III	Si (Silt)	0.6 - 0.3	0.3 - 0.15		PL (Platy)
L (Linear Slope)		SiCL (Silty Clay Loam)				PR (Prismatic)
N (Nose Slope)		CL (Clay Loam)				
R (Ridge)		SCL (Sandy Clay Loam)			**MOIST**	**WET**
S (Shoulder Slope)		SiL (Silt Loam)				
T (Terrace)					VFR (Very Friable)	NS (Non-sticky)
	IV	SC (Sandy Clay)	0.4 - 0.1	0.2 - 0.05	FR (Friable)	SS (Slightly Sticky)
		SiC (Silty Clay)			FI (Firm)	S (Sticky)
		C (Clay)			VFI (Very Firm v. Very Sticky)	VS (Very Sticky)
		O (Organic)	None	None	EFI (Extremely Firm)	NP (Non-plastic)
						SP (Slightly Plastic)
						P (Plastic)
						VP (Very Plastic)

*Adjust LTAR due to depth, consistence, structure, soil wetness, landscape, position, wastewater flow and quality.


NOTES

HORIZON DEPTH	In inches below natural soil surface
DEPTH OF FILL	In inches from land surface
RESTRICTIVE HORIZON	Thickness and depth from land surface
SAPROLITE	S(suitable) or U(unsuitable)
SOIL WETNESS	Inches from land surface to free water or inches from land surface to soil colors with chroma 2 or less - record Munsell color chip designation
CLASSIFICATION	S (Suitable), PS (Provisionally Suitable), or U (Unsuitable)

Evaluation of saprolite shall be by pits.

Long-term Acceptance Rate (LTAR): gal/day/ft^2

Show profile locations and other site features (dimensions, reference or benchmark, and North)

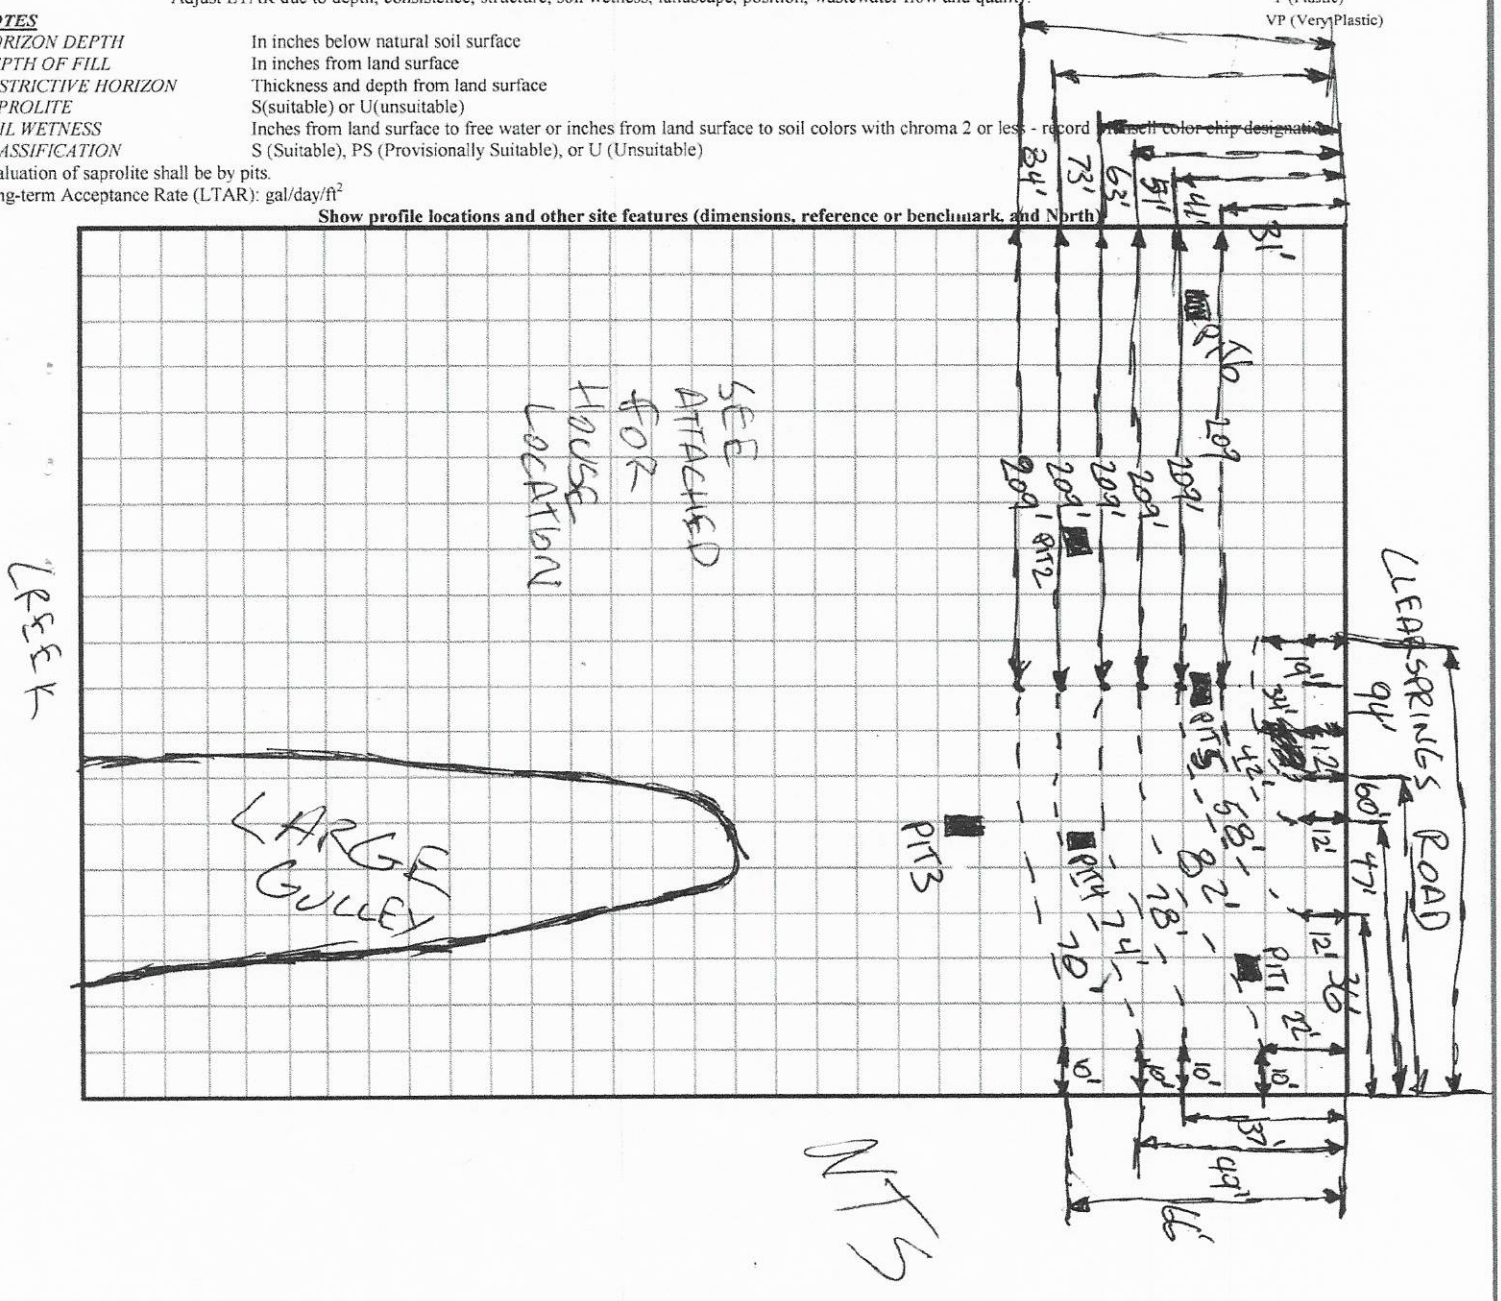

Updated February 2014

DEPARTMENT OF HEALTH AND HUMAN SERVICES
DIVISION OF PUBLIC HEALTH, ENVIRONMENTAL HEALTH SECTION
ON-SITE WATER PROTECTION BRANCH

PROPERTY ID #: 4649
COUNTY: IREDELL

SOIL/SITE EVALUATION
***for* ON-SITE WASTEWATER SYSTEM**
(Complete all fields in full)

OWNER: SEE PAGE 1 APPLICATION DATE
ADDRESS: DATE EVALUATED:
PROPOSED FACILITY: PROPOSED DESIGN FLOW (.1949): PROPERTY SIZE:
LOCATION OF SITE: PROPERTY RECORDED:
WATER SUPPLY: ☐ Private ☐ Public ☐ Well ☐ Spring ☐ Other
EVALUATION METHOD: ☐ Auger Boring ☐ Pit ☐ Cut TYPE OF WASTEWATER: ☐ Sewage ☐ Industrial Process ☐ Mixed

PROFILE #	.1940 LANDSCAPE POSITION/ SLOPE %	HORIZON DEPTH (IN.)	SOIL MORPHOLOGY (.1941) .1941 STRUCTURE/ TEXTURE	.1941 CONSISTENCE/ MINERALOGY	OTHER PROFILE FACTORS .1942 SOIL WETNESS/ COLOR	.1943 SOIL DEPTH	.1956 SAPRO CLASS	.1944 RESTR HORIZ	PROFILE CLASS & LTAR
1	LINEAR SIDE 5%	0-16	SC, WSBK	FR, SS, SP, SEXP	Y/B REDOX FEATURES 0"-12" SAP INC THRU OUT MICA COMMON	60"+	NA	NA	PS .3
		16-30	C, ABK	FR, S, P, SEXP					
		30-60	CL/WABK	FI, SS, SP, SEXP					
2	LINEAR SIDE 5%	0-12	SC, WSBK	FR, SS, SP SEXP	SAP INC THRU OUT	52"+	NA	NA	PS .3
		12-45	C, ABK	FR, S, P, SEXP					
		45-52	CL/WABK	FI, SS SP, SEXP					
3									
4									

DESCRIPTION	INITIAL SYSTEM	REPAIR SYSTEM
Available Space (.1945)		
System Type(s)	SEE PAGE 1	
Site LTAR		

OTHER FACTORS (.1946):
SITE CLASSIFICATION (.1948):
EVALUATED BY:
OTHER(S) PRESENT:

COMMENTS:

LEGEND

use the following standard abbreviations

LANDSCAPE POSITION	GROUP	SOIL TEXTURE	CONVENTIONAL .1955 LTAR*	LPP .1957 LTAR*	MINERALOGY/ CONSISTENCE	STRUCTURE
CC (Concave Slope)	I	S (Sand)	1.2 - 0.8	0.6 - 0.4	SEXP (Slightly Expansive)	G (Single Grain)
CV (Convex Slope)		LS (Loamy Sand)			EXP (Expansive)	M (Massive)
D (Drainage Way)						CR (Crumb)
DS (Debris Slump)	II	SL (Sandy Loam)	0.8 - 0.6	0.4 - 0.3		GR (Granular)
FP (Flood Plain)		L (Loam)				SBK (Subangular Blocky)
FS (Foot Slope)						ABK (Angular Blocky)
H (Head Slope)	III	Si (Silt)	0.6 - 0.3	0.3 - 0.15		PL (Platy)
L (Linear Slope)		SiCL (Silty Clay Loam)				PR (Prismatic)
N (Nose Slope)		CL (Clay Loam)				
R (Ridge)		SCL (Sandy Clay Loam)			**MOIST**	**WET**
S (Shoulder Slope)		SiL (Silt Loam)				
T (Terrace)					VFR (Very Friable)	NS (Non-sticky)
	IV	SC (Sandy Clay)	0.4 - 0.1	0.2 - 0.05	FR (Friable)	SS (Slightly Sticky)
		SiC (Silty Clay)			FI (Firm)	S (Sticky)
		C (Clay)			VFI (Very Firm v. Very Sticky)	VS (Very Sticky)
		O (Organic)	None	None	EFI (Extremely Firm)	NP (Non-plastic)
						SP (Slightly Plastic)
						P (Plastic)
						VP (Very Plastic)

*Adjust LTAR due to depth, consistence, structure, soil wetness, landscape, position, wastewater flow and quality.


NOTES

HORIZON DEPTH	In inches below natural soil surface
DEPTH OF FILL	In inches from land surface
RESTRICTIVE HORIZON	Thickness and depth from land surface
SAPROLITE	S(suitable) or U(unsuitable)
SOIL WETNESS	Inches from land surface to free water or inches from land surface to soil colors with chroma 2 or less - record Munsell color chip designation
CLASSIFICATION	S (Suitable), PS (Provisionally Suitable), or U (Unsuitable)

Evaluation of saprolite shall be by pits.

Long-term Acceptance Rate (LTAR): gal/day/ft^2

Show profile locations and other site features (dimensions, reference or benchmark, and North).

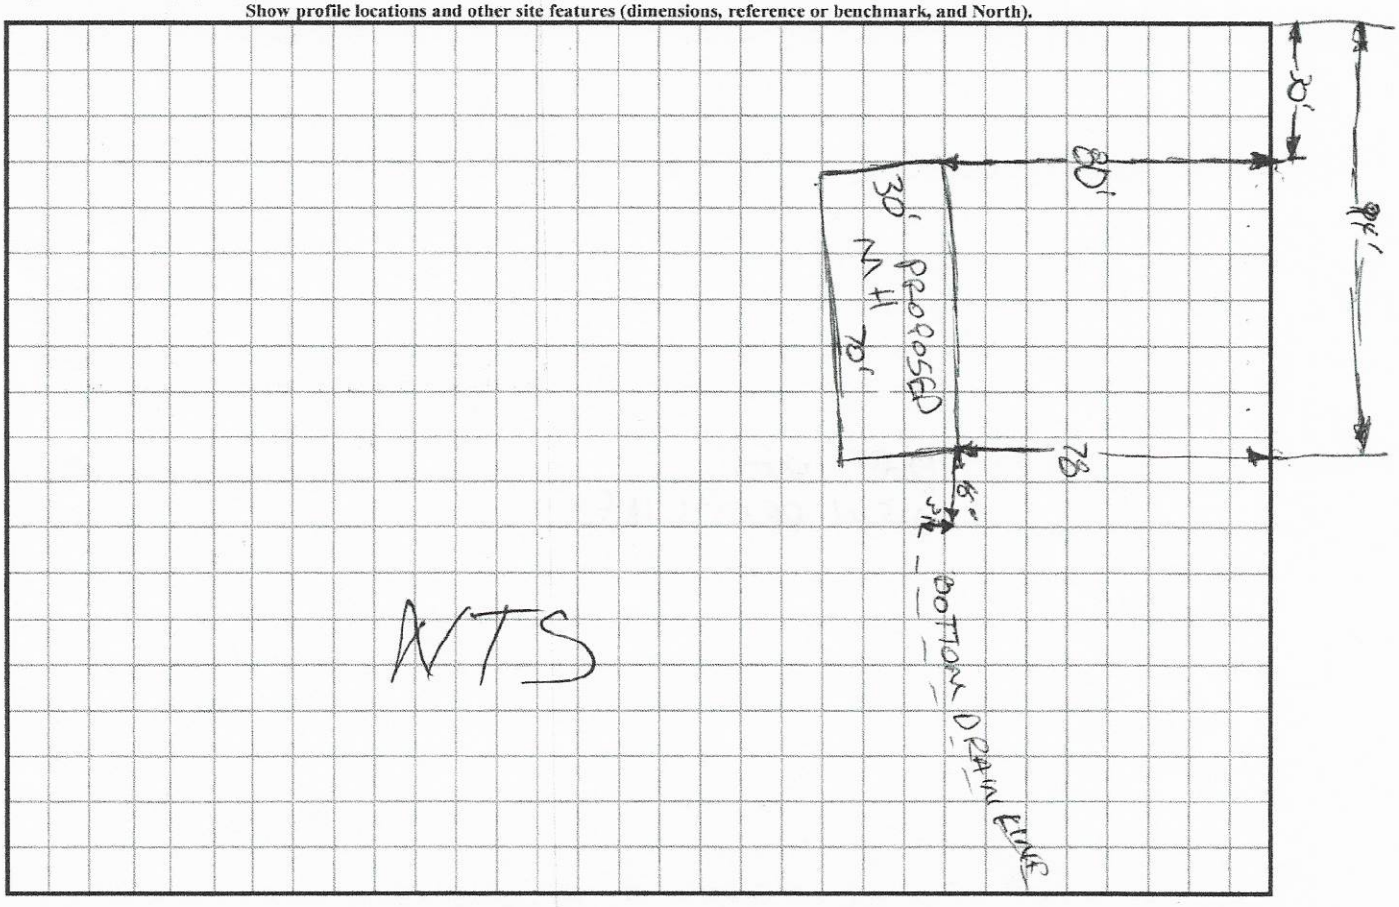

RECEIVED FEB 10 2020

IREDELL COUNTY DEPARTMENT of ENVIRONMENTAL HEALTH

APPLICATION FORM

$320.00
AP-247011

Application For: w Well Permit ( ) Well Repair Permit ( ) Well Abandonment
(X) Septic Improvement Permit (X) Authorization to Construct ( ) Existing System Inspection ( ) Septic System Repair

THE ABOVE PERMIT DOCUMENTS WILL BECOME INVALID IF INFORMATION PROVIDED ON THIS APPLICATION IS FALSIFIED OR CHANGED, OR IF THE SITE IS ALTERED. THE IMPROVEMENT PERMIT IS VALID FOR EITHER 60 MONTHS OR WITHOUT EXPIRATION DEPENDING UPON DOCUMENTATION SUBMITTED. APPLICATION WITH SITE PLAN 60 MONTHS, APPLICATION WITH COMPLETE, SCALED PLAT WITHOUT EXPIRATION. SEE 15A NCAC 18A .1937(f) FOR DETAILS.

Page 2: *Site Plan Worksheet* form MUST accompany this application

The following optional attachments may also be submitted: ( ) Survey Plat, scaled no more than 1 inch = 60 feet
Place an (X) beside whichever is submitted if applicable (X) Custom Site Plan, scaled no more than 1 inch = 60 feet

Applicant Information: (PRINT CLEARLY)

Applicant Name: Freedom Homes / Kimberly Sneed Address: 1124 Charlotte Hwy Troutman NC Zip: 28166

Applicant Email: Kimsneed.Sneed04@gmail.com Phone: 704-881-2326 Alt. Phone: _____

Owner Name: & Windward Sailviews LLC Address: 21313 Catawba Ave Cornelius NC Zip: 28031

Owner Email: _____ Phone: _____ Alt. Phone: _____

Property Information:

Street Address: 208 Clear Springs Rd Mooresville, NC 28115

Subdivision Name: _____ Section/Phase: _____ Lot Number: 208/212

Driving Directions: Coats Shelton Ave, Iredell, Create Clear Springs Rd
- Lot is on Right (Freedom Homes Sign)

Site Development Information: *(check or complete ALL that apply*

CHECK FOUNDATION TYPE

(X) New Single Family Residence — Maximum Number of Bedrooms: 4 — (X) Crawl Space Foundation
( ) New Multi-Family Residence — Maximum Number of Occupants: 2 — ( ) Concrete Slab Foundation
( ) Accessory Building — ( ) Swimming Pool — ( ) Basement with Plumbing
( ) Bedroom(s) Addition — ( ) Other Addition/Structure: _____ — ( ) Basement without Plumbing
( ) Repair to failing septic system ___ Tank ___ Drain lines Describe Problem: _____
Non-Residential Site Development: Type of Business: _____
Square Footage of Building: _____ Max. Number of Employees: _____ Max. Number of Seats/Beds/Other: _____

Water Supply: ( ) Replacement Well – Reason: _____
( ) Multi-connection Well Number of Houses: _____ Number of Persons: _____

(X) New Well ( ) Existing Well ( ) Community Well ( ) City Water ( ) Other Public Water

Desired Septic System Type: *(you may rank in order of preference)* Year existing system installed: _____
( ) No Preference ( ) Alternative (X) Conventional ( ) Innovative ( ) Modified Conventional ( ) Other: _____

Please answer the following to the best of your ability:

( ) Yes (X) No Does the site contain any jurisdictional wetlands?
( ) Yes (X) No Is any non-domestic sewage (i.e. industrial) to be generated?
( ) Yes (X) No Is the site subject to approval by any other public agency?

I have read this application and certify that the information provided herein is true, complete, and correct. Authorized county and state officials are granted right of entry to conduct necessary inspections to determine compliance with applicable laws and rules. I understand that I am solely responsible for the proper identification and labeling of all property lines and corners and making the site accessible so that a complete site evaluation can be performed.

Signature: Kimberly Sneed 2-10-20
Property owner or owner's legal representative signature (SIGNATURE REQUIRED) DATE


IREDELL COUNTY DEPARTMENT of ENVIRONMENTAL HEALTH

SITE PLAN WORKSHEET

SEE THE "SAMPLE SITE PLAN" BELOW. *INCOMPLETE SITE PLANS WILL BE RETURNED TO YOU FOR COMPLETION AND MAY RESULT IN A DELAY IN THE ISSUANCE OF YOUR SEPTIC SYSTEM OR WELL PERMIT!!!*

Place an (X) beside each item as you complete the site plan:

- (X) Property Line measurements are clearly identified
- (X) All proposed structures are indicated
- (X) Front and side setbacks from property line
- (X) Preferred driveway location
- (X) Preferred well location
- (X) Preferred septic system location
- ( ) North arrow, or other sufficient indicator of direction

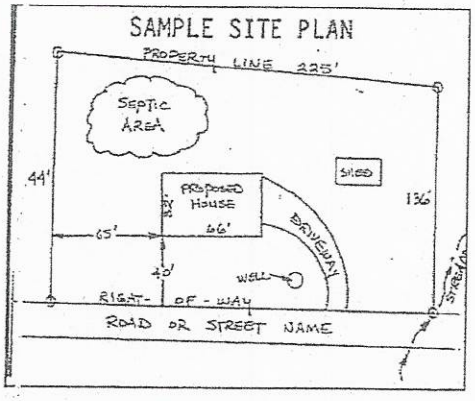

Circle N/A on the following if appropriate:

Location of septic systems and wells within 100' of your property	N/A
Location of easements and rights of ways on your property	N/A
Location of any designated wetlands on the property	N/A

USE THIS SPACE TO DRAW YOUR SITE PLAN

Show: proposed house or business footprint, wells, water lines, patios, pools and decks, and any other item that will occupy space on the site


Attached

Signature: _____

Property owner or owner's legal representative signature (SIGNATURE REQUIRED)

2-10-20

DATE

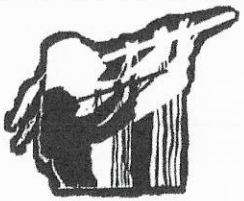



Lot 132
Windward Sailview LLC
DB 2128 pg 104.3
PB 30 pg 4

Lot 132
Windward Sailview LLC
DB 2128 pg 104.3
PB 30 pg 4

Lot 148
Donna L. Janes
DB 1957 pg 995

PB 34 pg 97

N 65°08'05"E 200.02'

S 65°08'05"W 93.13'

S 25°27'43"E 227.56' (Total)
201.56'

N 25°27'43"W 228.60' (Total)

20.00' R/W

DRAINAGE EASEMENT

30' REAR SETBACK

15' SIDEYARD SETBACK

15' SIDEYARD SETBACK

35' FRONT SETBACK

LOT 149 and 150
1.049 Acres Total

Lot 152

Lot 151
John H. White
DB 2445 pg 391

N23°27'43"W

S 25°27'43"E 35.00'

Concrete Drive

Arc 71.91' Rad 2475.00'
S 65°22'12"W 71.81'

S 64°32'17"W 128.20'


Clear Springs Rd. 50' R/W
(SR 3149)

48.42'
S 35°01'22"W

Mag Nail Set

Crois Ct.



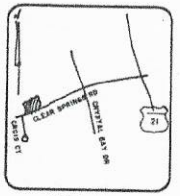

Vicinity Map
Scale None

LEGEND
DB = Deed Book
pg = Page
PB = Power Pole
MN = Mag Nail
MH = Man Hole
EIP = Existing Iron Pipe
EIR = Existing Iron Rod
NIR = New Iron Rod
CM = Concrete Marker
Dwlg = Dwelling
Bldg = Building
C/L = Center Line
R/W = Right of Way
CP = Computer Point

REVISED August 1, 2019
To show Encroachment Area

NORTH CAROLINA PROFESSIONAL SEAL L-2829 LAND SURVEYOR DAVID B. CLARK

I, David S. Clark, PLS certify that this plat was drawn under my supervision from an actual survey made under my supervision deed description, recorded in Book 2595 page 2052; that the boundaries not surveyed are clearly indicated as drawn from information found in Book 34, page 97; that the ratio of precision as calculated is 1: 22000; that this plat was prepared in accordance with Standards of Practice witness my original signature, licensed number and seal this 19th day of July A.D. 2019

David S. Clark, PLS L-2829
Surveyor

30 0 30 60 90
GRAPHIC SCALE - FEET

Survey Plat for
Rebecca Gabriel
208 & 212 Clear Springs Dr, Mooresville NC, 28115
Darringer Township, Iredell County, North Carolina
PIN 4644 95 8988.000 Drawn By DKB
DB 2595 pg 2052 FB 157 pg 42
Date July 19th, 2019 Scale 1"=30'
Windward Pointe Ph 3 PB 34 pg 97 & 98

SURVEYOR
David S. Clark Surveyor
1920 32nd St. NE, Hickory, NC 28601
828-256-6400 www.clarksurveying.com
C-2687

IREDELL COUNTY DEPARTMENT OF ENVIRONMENTAL HEALTH

DOCUMENTATION TO AUTHORIZE AN OWNER'S LEGAL REPRESENTATIVE

Applications for permits require the "signature of the owner or owner's legal representative" (15A NCAC 18A .1937). If the owner does not sign the application himself or herself, they can submit any one of the following documents to designate their legal representative:

Power of Attorney; Real Estate Contract; Estate executor; Bankruptcy trustee; Court ordered guardianship

In the absence of the above documentation, the property owner may provide the local health department with documentation that designates a legal representative. A property owner may:

Complete this form to document his or her legal representative, or provide his or her own form that contains the information in this form.

If there are multiple property owners, then all property owners must sign the form that designates a legal representative.

By signing a form that designates a legal representative for purposes of 15A NCAC 18A .1937, the property owner authorizes that representative to act on their behalf in matters pertaining to the application and permitting process, including signing or receiving any application, document or permit. The owner retains full responsibility to meet all permit conditions specified by the local health department.

I, Winward Sailview LLC, am the legal owner(s) of the property located at 208 & 212 Clear Springs Rd. Mooresville NC 28115, identified as PIN (Parcel Identification Number) 4649-95-8988.000, located in Iredell County, North Carolina.

I do hereby authorize **(print legal representative/company name)** Freedom Homes, _____, to act as an agent on my behalf in applying for/signing/obtaining any of the documents described below.

- Application for Improvement Permit (IP) / Authorization to Construct (AC)
- Improvement Permit (IP) / Authorization to Construct (AC)
- Application for soil-site evaluation (new/repair)
- Application/permit for private drinking water well/well abandonment
- Application for Compliance Inspection

I agree to abide by all decisions and/or conditions between the legal representative acting on my behalf and the Iredell County Department of Public Health, Environmental Health Division.

J. Martin McCoy 7/17/19 Heather Thomason 7/17/19

Signature of Owner(s) Date Signature of Witness Date

Please return this signed form to the appropriate office:


Mooresville - Environmental Health
ronda.hart@co.iredell.nc.us
Fax: 704-662-3239
610 E. Center Avenue, Mooresville, NC 28115

Statesville - Environmental Health
adrienne.shea@co.iredell.nc.us
Fax: 704-871-3483
349 N. Center Street, Statesville, NC 28677

TRU

PRIDE

APPROVED
MHC
CUSTOMER
DATE 2-9-19

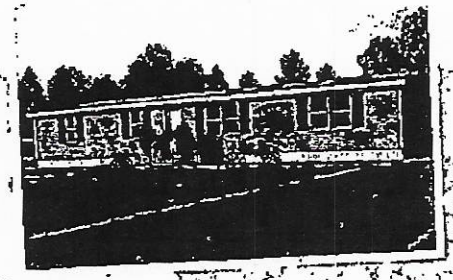


TRU28684R

1,791 sq ft // 4 beds // 2 baths

(28x68)

Meter HP

6x6

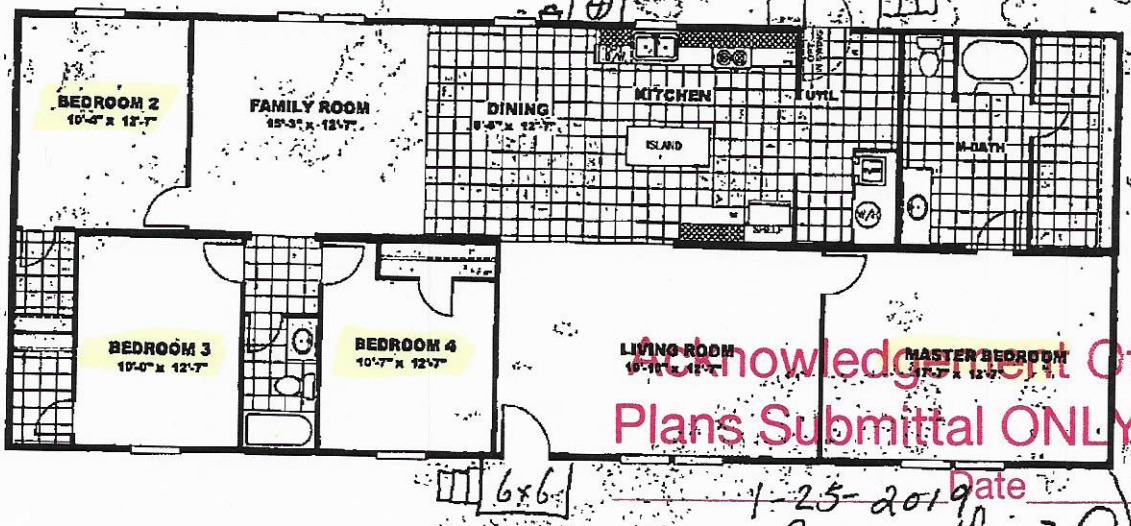

6x6


Acknowledgement Of Plans Submittal ONLY!

1-25-2019 Date

Rebecca Hatch

Brent Gilbert 10-16-19

Driveway

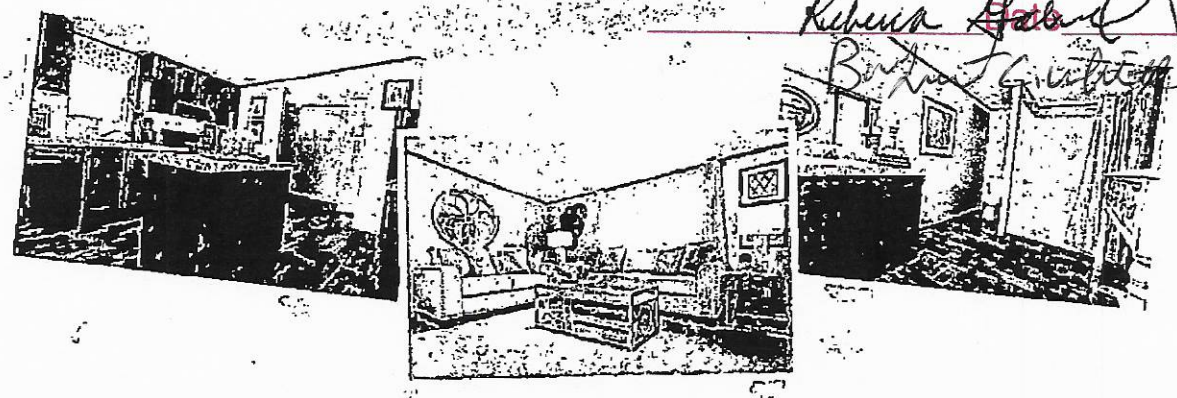

The home series and floor plans shown all have starting prices within the price range indicated. Your local Home Center can quote you specific prices and terms of purchase for specific homes. TRU invests in continuous product and process improvement. All home series, floor plans, specifications, dimensions, features, materials, availability, and starting prices shown are artist's renderings or estimates and are subject to change without notice or obligation. Dimensions are nominal and length and width measurements are from exterior wall to exterior wall. Starting prices include the home only, plus typical delivery and installation. Starting prices do not include other costs such as taxes, title fees, insurance premiums, filing or recording fees, land or improvements to the land, optional home features, optional delivery or installation services, wheels and axles, community or homeowner association fees, or any other items not shown on your Retailer Closing Agreement and related documents (your RCA). Your RCA will show the details of your purchase. 2018 TRU. All rights reserved.