# IREDELL COUNTY HEALTH DEPARTMENT

STATESVILLE 704-878-5305 125.00 Paid MOORESVILLE 704-664-5281

## IMPROVEMENT PERMIT / AUTHORIZATION TO CONSTRUCT / OPERATION PERMIT / EXISTING SYSTEM INSPECTION

PERMIT# 093342 PIN# 4649959337 DATE 0205-01

OWNER OR CONTRACTOR PROFFITT DEV CO, LLC PHONE: Business 704/660/5903 Home

ADDRESS 142 STUTTS RD MOORESVILLE, NC 28117

LOCATION 115 S, R SAILWINDS, L CRYSTAL BAY, R CLEAR SPRINGS, L Crois Circle

SUBDIVISION WINWARD PT BLOCK / SECTION 3 LOT [redacted] LOT AREA .77 ACRE SITE CLASS. PS DESIGN FLOW 360 L.T.A.R. .13

Septic Tank: 1000 Gallons; STB 794 Date 5-13-02
Pump Tank: 1000 Gallons; PT 283 Date 5-24-02
Pump Make: Model Serial No.
Nitrification Field: No. Fields 1 Square Feet EQ=1200 Linear Feet 300
No. Lines 4@70 Trench Width 36" Max Trench Bottom Depth 36" Gravel Depth N/A

☒ New System ☐ Repair System Type: I, II, (III) IV, V, VI
System Description: PUMP 25% REDUCTION
Repair System Description: LPP PANEL
Maintenance Agreement Required: ☐ Yes ☐ No


☐ House/Mod. Home No. Bedrooms 3
☒ Mobile Home No. Bathrooms 2
☐ Business No. Employees
☐ Other
☐ Slab ☒ Crawl Space ☐ Basement w/plumbing ☐ Basement wo/plumbing

Water Supply: ☒ Individual ☐ Public ☐ Community

Comments/Conditions: ① KEEP SYSTEM 5' off house & 10' off property lines ② INSTALL Lineson contours ③ KEEP Well 100' AWAY FROM system.

Comments/Conditions: Grey filter installed 95' to Well Lines 2 & 3 okay Lines 1 & 4 going "uphill" ~2-4 inches OK 7/3/2002

INITIAL SITE SKETCH 1" = 60'

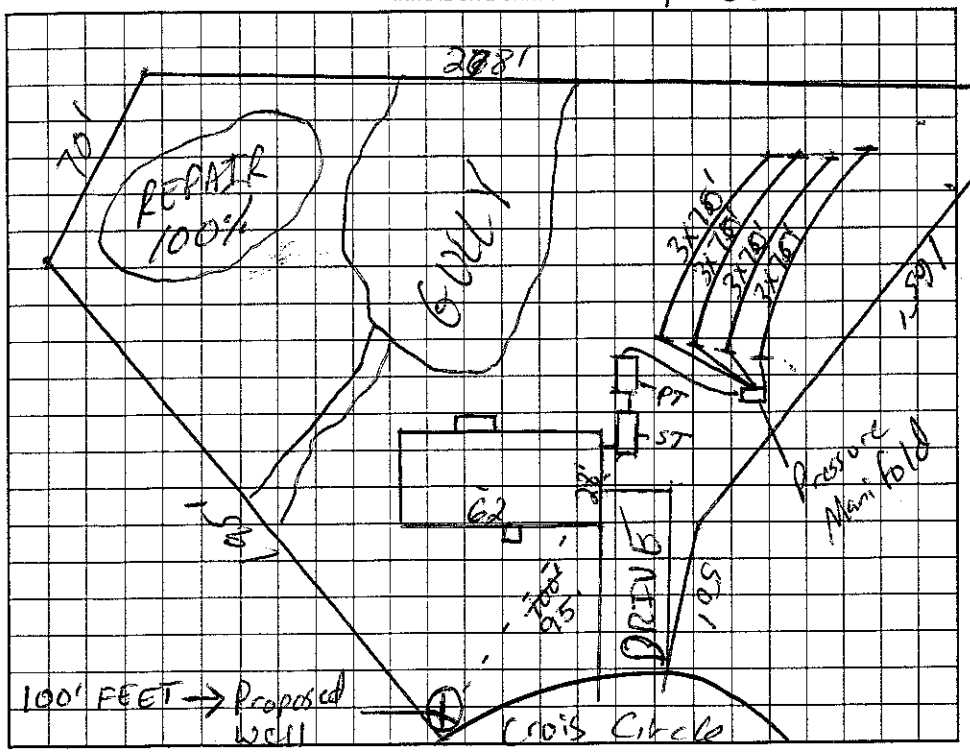


AS BUILT SKETCH

Installed "Plastic Chambers" Drainfield 4@70'

Permit can be suspended or revoked if any false information is supplied toward securing the permit/any unauthorized changes are made to the site/any unauthorized changes are made in the installation of the system. Improvement Permit with plat valid without expiration. Improvement Permit with site plan valid for sixty months. Authorization to Construct is valid for a period equal to that of Improvement Permit – not to exceed sixty months.

Signed: Emily Creed date

Improvement Permit by: Jane Cook RST date 02-05-01

Authorization to Construct by: Jane Cook RST date 0205-01

Installed by: Marty Tucker

Operation Permit by: [signature] RS date 7/8/02

Existing System Inspection by: date

HEALTH DEPT. COPY: WHITE OWNER COPY (FINAL): YELLOW OWNER COPY (INITIAL): PINK