2.00

IREDELL COUNTY HEALTH DEPARTMENT

STATESVILLE 704-878-5305 MOORESVILLE 704-664-5281

IMPROVEMENT PERMIT / AUTHORIZATION TO CONSTRUCT / OPERATION PERMIT / EXISTING SYSTEM INSPECT

PERMIT# 077968 PIN# 4649961801 DATE 12/18/98

OWNER OR CONTRACTOR PRUITT DEV. PHONE: Business 866-9546 Home

ADDRESS 142 STATTS RD - MOORESVILLE NC 28115

LOCATION 21N - TL STILWELLS - 16TH LOT ON LT

SUBDIVISION WINWARD PT BLOCK / SECTION 2 LOT 118 LOT AREA .85AC SITE CLASS. RS DESIGN FLOW 360 L.T.A.R. .25

Septic Tank: 1000 Gallons; STB 1012 Date 12/22/98

Pump Tank: Gallons; PT Date

Pump Make: Model Serial No.

Nitrification Field: No Fields 1 Square Feet 1080 Linear Feet 360

No Lines 6@60' Trench Width 36" Max Trench Bottom Depth 24" Gravel Depth N/A

☑ New System ☐ Repair System Type: I, II, III, IV, V, VI

System Description: GRAVITY CHAMBERS OR HDS

Repair System Description: SAME

Maintenance Agreement Required: ☐ Yes ☑ No

☐ House/Mod. Home ☑ Mobile Home ☐ Business ☐ Other

No. Bedrooms 3 No. Bathrooms 3 No. Employees


☐ Slab ☑ Crawl Space ☐ Basement w/plumbing ☐ Basement wo/plumbing

Water Supply ☑ Individual ☐ Public ☐ Community

Comments:/Conditions: IF DROP BOXES ARE USED - THE DISTRIBUTION SYSTEM WILL BE CHANGED.

Comments:/Conditions:

INITIAL SITE SKETCH 1"=60'

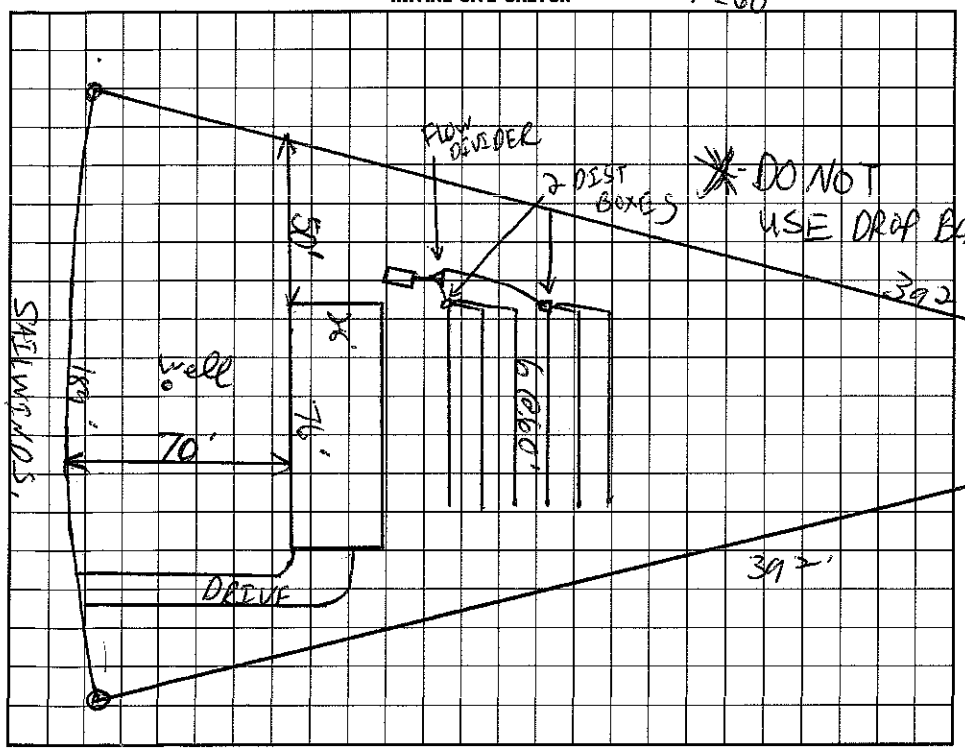

AS BUILT SKETCH

I understand that this permit can be suspended or revoked if any false information is supplied toward securing the permit/any unauthorized changes are made to the site/any unauthorized changes are made in the installation of the system. Improvement Permit with plat valid without expiration. Improvement Permit with site plan valid for sixty months. Authorization to Construct is valid for a period equal to that of Improvement Permit - not to exceed sixty months.

Signed: date 12/18/98 Installed by: A1 BACKHOE

Improvement Permit by: RS date 12/18/98 Operation Permit by: date 1/27/99

Authorization to Construct by: RS date 12/18/98 Existing System Inspection by: date

HEALTH DEPT. COPY: WHITE INSPECTION COPY (FINAL): GREEN OWNER COPY (FINAL): YELLOW INSPECTION COPY (INITIAL): PINK OWNER COPY (INITIAL): GOLD