(4.00)

IREDELL COUNTY HEALTH DEPARTMENT

STATESVILLE 704-878-5305 MOORESVILLE 704-664-5281

IMPROVEMENT PERMIT / AUTHORIZATION TO CONSTRUCT / OPERATION PERMIT / EXISTING SYSTEM INSPECTION

PERMIT# 77470 PIN# 4649963833 DATE 4/30/99

OWNER OR CONTRACTOR PRUITT DEV. PHONE: Business _____ Home _____

ADDRESS 142 STUTTS RD MOORESVILLE 28115

LOCATION 21/85N - TL SAILMINOS 14th LOT ON LT

SUBDIVISION WINNAROFT BLOCK / SECTION 2 LOT 120 LOT AREA .834C SITE CLASS. 1S DESIGN FLOW 360 L.T.A.R. .3

Septic Tank: 1000 Gallons; STB 10/2 Date 5/28/99
Pump Tank: 1000 Gallons; PT 17 Date 5/24/99
Pump Make: HYDROMATIC Model SK50 A1 Serial No. 5199
Nitrification Field: No Fields 1 Square Feet 900 Linear Feet 300
No Lines 4 @ 75' Trench Width 36" Max Trench Bottom Depth 36" Gravel Depth _____

☑ New System ☐ Repair System Type: I, II, III, IV, V, VI
System Description: PUMP 25% Reduction
Repair System Description: PUMP PANEL
Maintenance Agreement Required: ☐ Yes ☑ No

☐ House/Mod. Home No. Bedrooms 3
☑ Mobile Home No. Bathrooms 2
☐ Business No. Employees _____
☐ Other _____


☐ Slab ☑ Crawl Space ☐ Basement w/plumbing ☐ Basement wo/plumbing

Water Supply: ☑ Individual ☐ Public ☐ Community


Comments:/Conditions:

Comments:/Conditions:

INITIAL SITE SKETCH

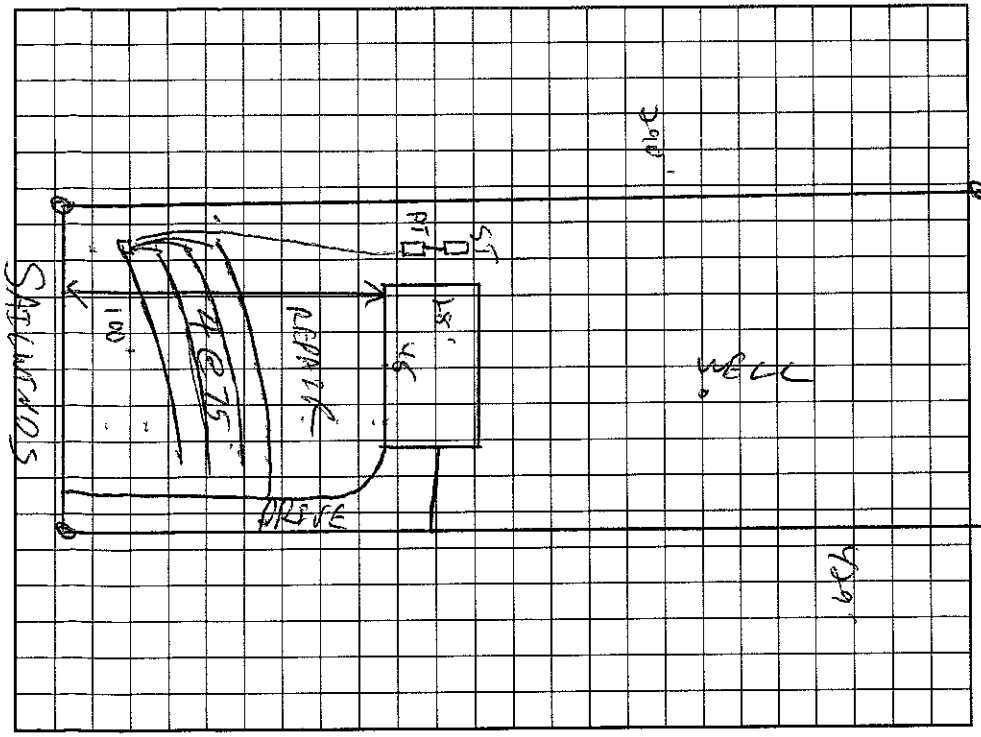

AS BUILT SKETCH

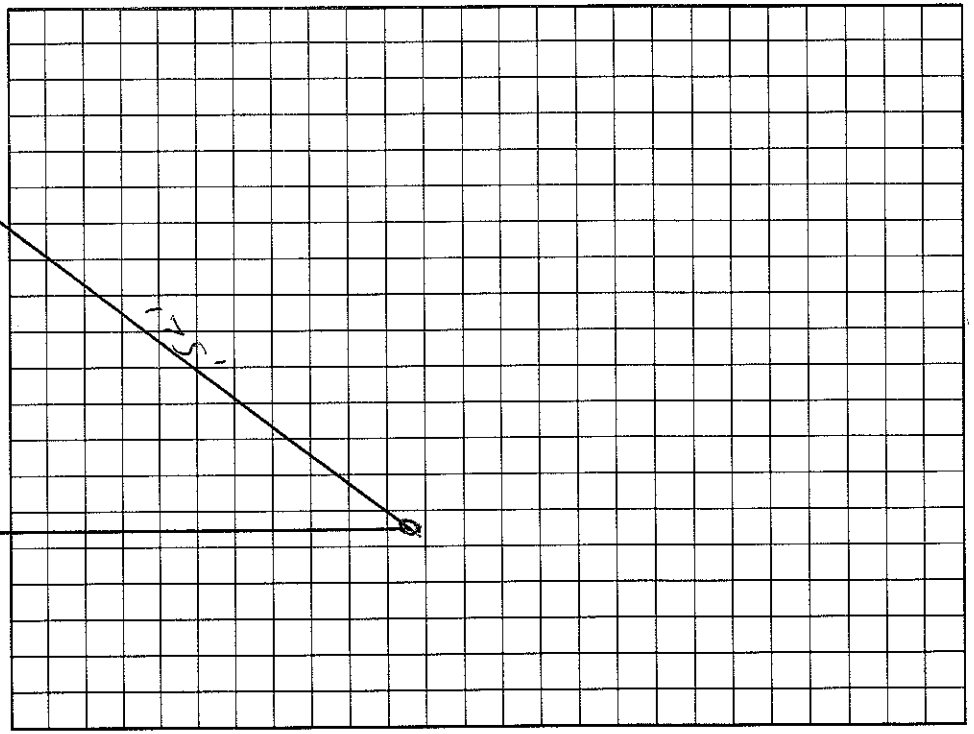

Permit can be suspended or revoked if any false information is supplied toward securing the permit/any unauthorized changes are made to the site/any unauthorized changes are made in the installation of the system. Improvement Permit with plat valid without expiration. Improvement Permit with site plan valid for sixty months. Authorization to Construct is valid for a period equal to that of Improvement Permit – not to exceed sixty months.

Signed: _____ date 5/4/99 Installed by: A1 BACKHOE

Improvement Permit by: C. [signature] RS date 4/30/99 Operation Permit by: C. [signature] RS date _____

Authorization to Construct by: C. [signature] RS date 4/30/99 Existing System Inspection by: [signature] RS. date 8/31/99

HEALTH DEPT. COPY: WHITE OWNER COPY (FINAL): YELLOW OWNER COPY (INITIAL): PINK