IREDELL COUNTY HEALTH DEPARTMENT

STATESVILLE 704-878-5305 MOORESVILLE 704-664-5281

IMPROVEMENT PERMIT / AUTHORIZATION TO CONSTRUCT / OPERATION PERMIT / EXISTING SYSTEM INSPECTION

PERMIT# ~~14882320481~~ 7 PIN# 4049964329 DATE 3-10-08

OWNER OR APPLICANT LPD Windward LLC PHONE: Business 704-731-0150 Home

ADDRESS 110 West Fayett St. Suite 990 Syracuse NY 13202

LOCATION 115 N. TL Sailwinds, TL Tradewinds, on Rin Culdesac

SUBDIVISION Windward Point BLOCK / SECTION LOT 127 LOT AREA .76AC SITE CLASS. PS DESIGN FLOW 480 L.T.A.R. .3

Septic Tank: 1000 Gallons: STB 760 Date 3/17

Pump Tank: Gallons: PT Date

Pump Make: Model Serial No.

Nitrification Field: No Fields 1 Square Feet 1200' Linear Feet 400'

No Lines 5@80' Trench Width 36" Max Trench Bottom Depth 36" Gravel Depth —

☒ New System ☐ Repair ☐ Expansion System Type: I II (III) IV V VI

System Description: Gravity 25% Red

Repair System Description: 3 PVP15

Maintenance Agreement Required: ☐ Yes ☒ No

☒ House/Mod. Home ☐ Mobile Home ☐ Business ☐ Other

No. Bedrooms 4 No. Persons No. Employees

Water Supply: ☒ Individual ☐ Public ☐ Community

☒ Gravity ☐ Pressure ☐ Slab ☒ Crawl Space ☐ Basement w/plumbing ☐ Basement wo/plumbing


Comments/Conditions: The area of old fill must be removed
Use drop box distribution

Comments/Conditions: Essentially Installed As Shown.

INITIAL SITE SKETCH

SEE PLAN
FROM
MICHAEL ATHANAS
+
ASSOCIATES

AS BUILT SKETCH

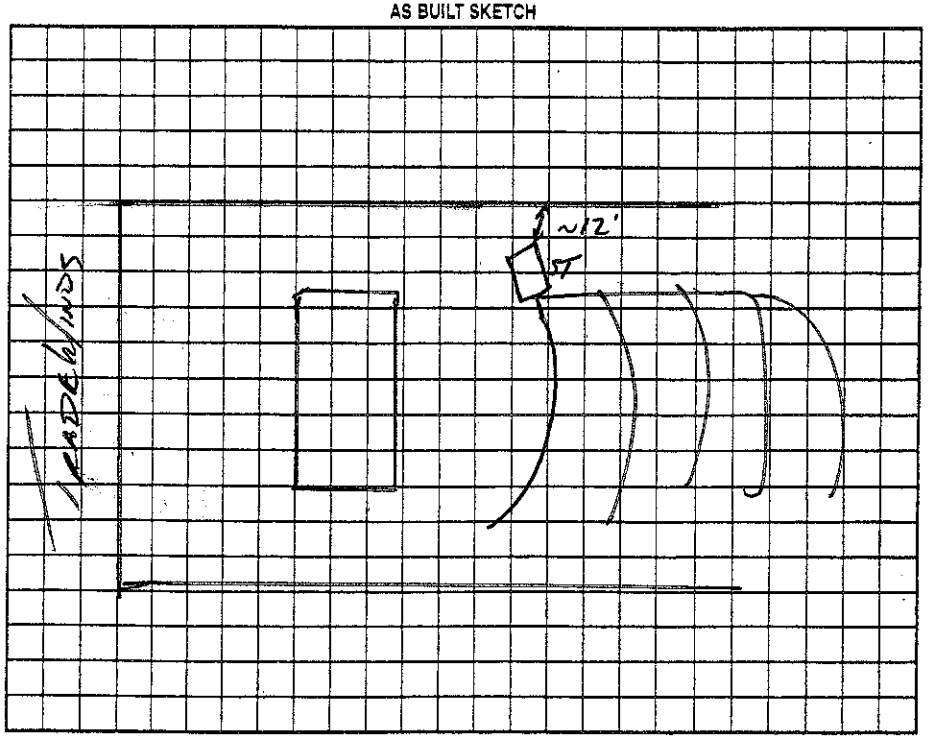

Permit can be suspended or revoked if any false information is supplied toward securing the permit/any unauthorized changes are made to the site/any unauthorized changes are made in the installation of the system. Improvement Permit with plan valid without expiration ☐ Improvement Permit with site plan valid for sixty months ☒ Authorization to Construct is valid for a period equal to that of Improvement Permit – not to exceed sixty months.

Signed: date

Improvement Permit by: date 3-10-08


Authorization to Construct by: APPROVED MAY 18 2015 date

Installed by Ground Breakers

Operation Permit by: date APPROVED AUG 18 2015

Existing System Inspection by: date

HEALTH DEPT. COPY: WHITE OWNER COPY (FINAL): YELLOW OWNER COPY (INITIAL): PINK

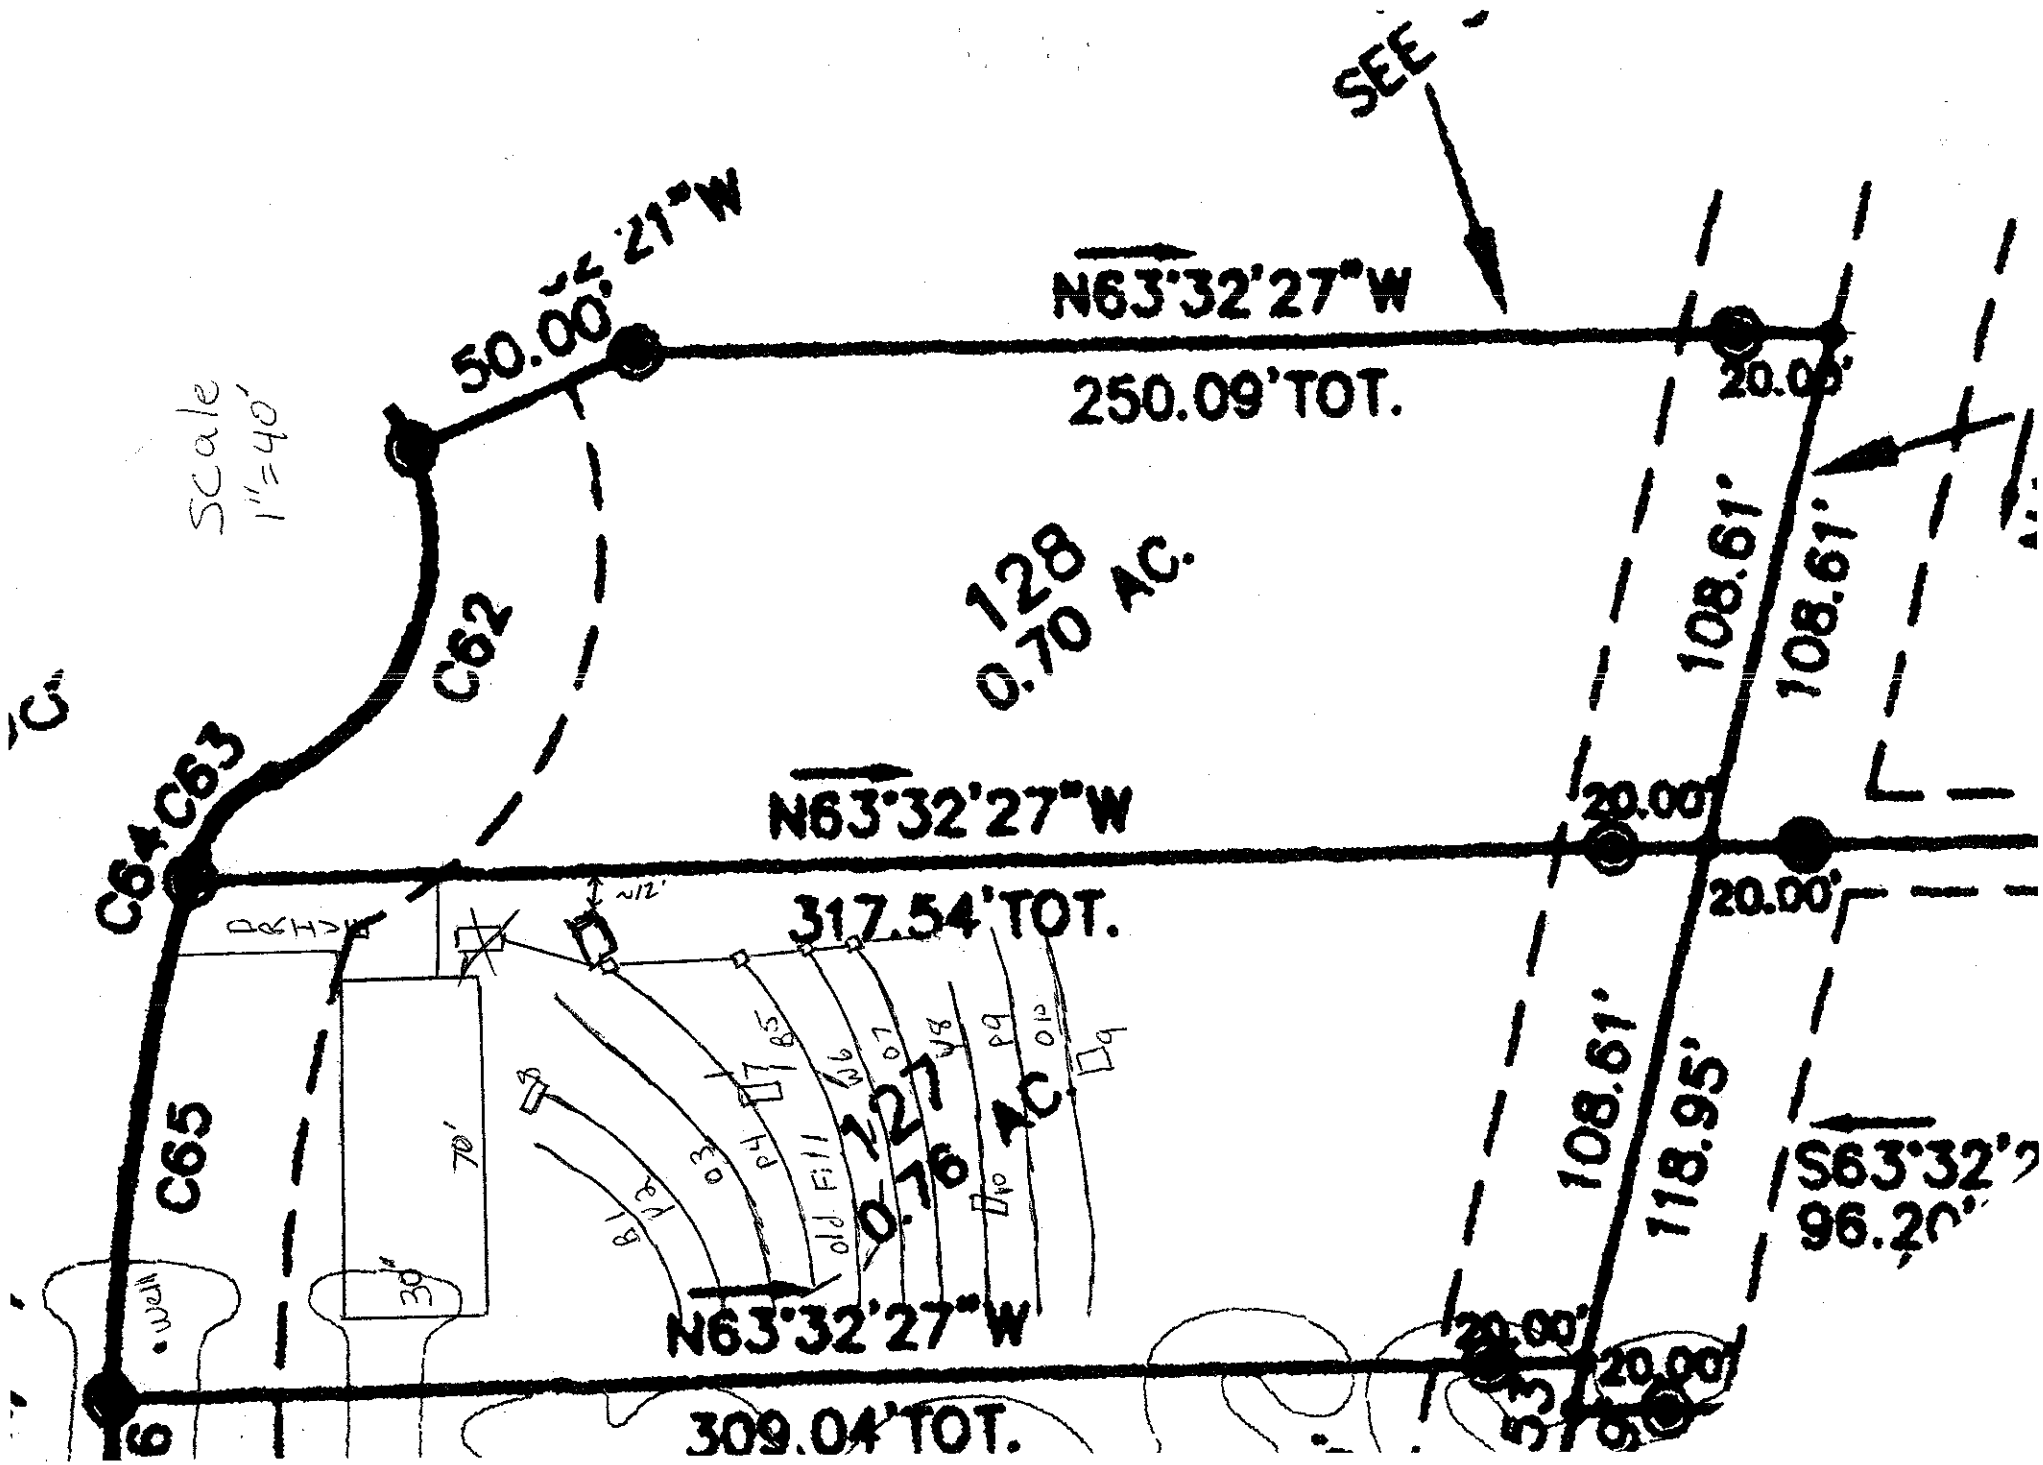
SEE
N63°32'27"W
250.09'TOT.
50.00'
21"W
20.00'
108.61'
108.61'
Scale
1"=40'
C62
128
0.70 AC.
C64 C63
N63°32'27"W
317.54'TOT.
20.00'
20.00'
20.00'
PRHSE
w/12'
C65
70'
30'
well
old Fill
127
0.76 AC.
108.61'
118.95'
S63°32'2
96.20'
N63°32'27"W
309.04'TOT.
20.00'
20.00'
6