IREDELL COUNTY HEALTH DEPARTMENT

STATESVILLE 704-878-5305 MOORESVILLE 704-664-5281

IMPROVEMENT PERMIT / AUTHORIZATION TO CONSTRUCT / OPERATION PERMIT / EXISTING SYSTEM INSPECTION

PERMIT# 07463 PIN# 4649 96 4488 DATE 9/14/98

OWNER OR CONTRACTOR PRUITT DEV. PHONE: Business Home 660-5900

ADDRESS 142 STUTTS RD MOORESVILLE - NC 28115

LOCATION 21/115 N - TL SAILWINDS - TL TRADEWINDS - ON RT

SUBDIVISION WINWARD PT BLOCK / SECTION LOT 126 LOT AREA .73AC SITE CLASS. RS DESIGN FLOW 360GPD L.T.A.R. .30/.30

Septic Tank: 1000 Gallons; STB 1012 Date 10/2/98

Pump Tank: Gallons; PT Date

Pump Make: Model Serial No.

Nitrification Field: No Fields 1 Square Feet 900 Linear Feet 300

No Lines 4@75 Trench Width 36" Max Trench Bottom Depth 36" Gravel Depth N/A

☒ New System ☐ Repair System Type: I, II, III, IV, V, VI

System Description: GRAVITY CHAMBERS OR HDS

Repair System Description: SAME

Maintenance Agreement Required: ☐ Yes ☒ No

☐ House/Mod. Home ☒ Mobile Home ☐ Business ☐ Other

No. Bedrooms 3 No. Bathrooms 2 No. Employees


☐ Slab ☒ Crawl Space ☐ Basement w/plumbing ☐ Basement wo/plumbing

Water Supply: ☒ Individual ☐ Public ☐ Community


Comments:/Conditions:

Comments:/Conditions:

INITIAL SITE SKETCH

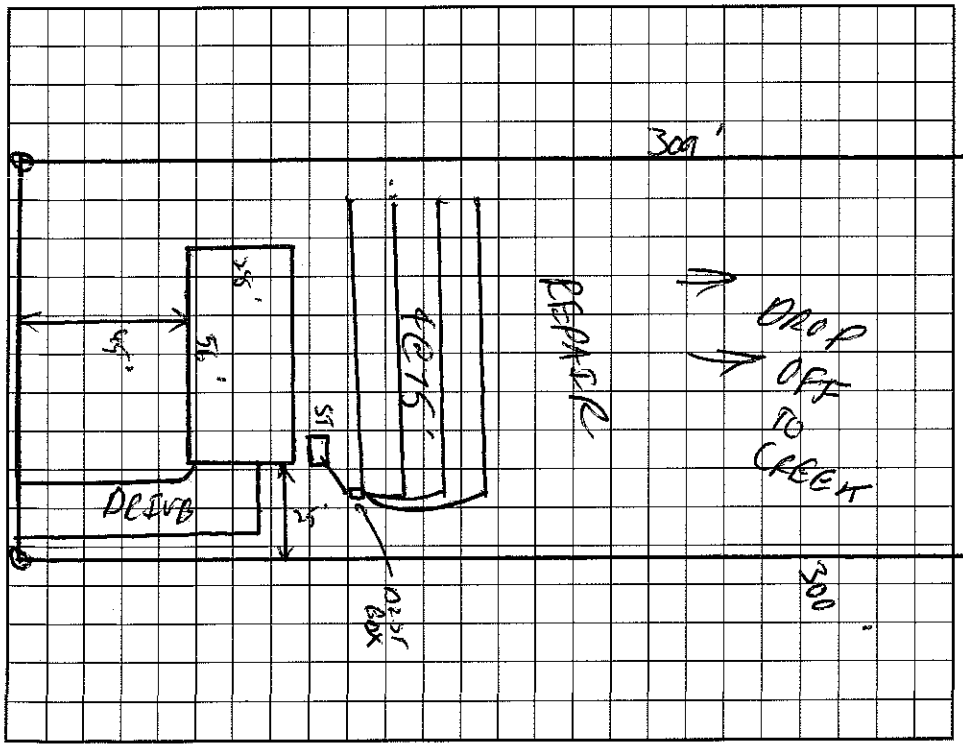

AS BUILT SKETCH

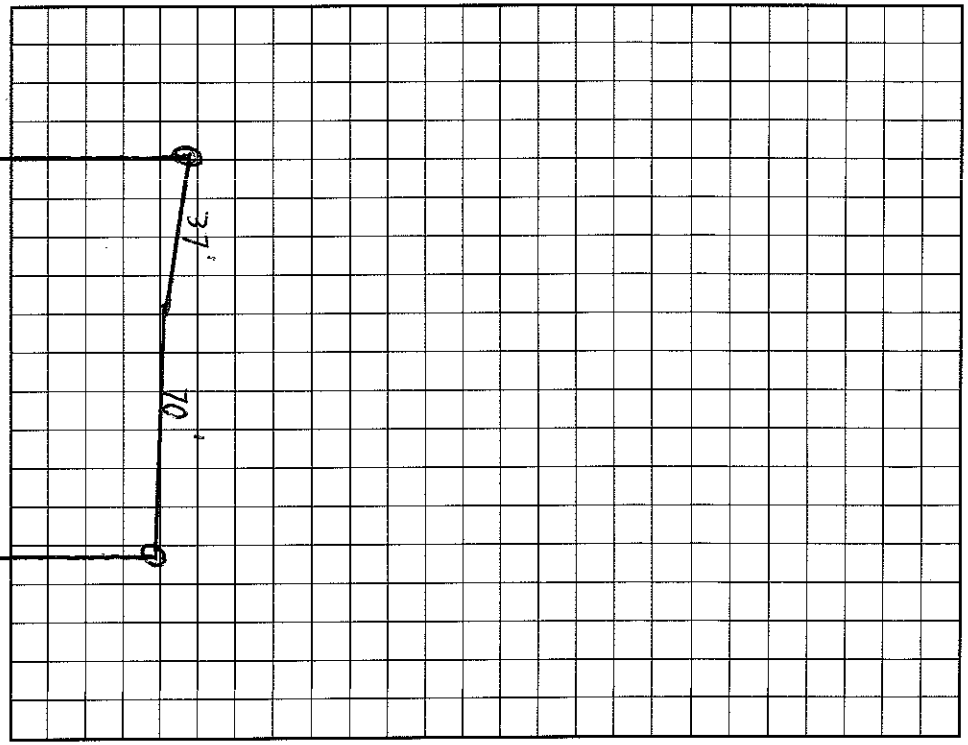

I understand that this permit can be suspended or revoked if any false information is supplied toward securing the permit/any unauthorized changes are made to the site/any unauthorized changes are made in the installation of the system. Improvement Permit with plat valid without expiration. Improvement Permit with site plan valid for sixty months. Authorization to Construct is valid for a period equal to that of Improvement Permit – not to exceed sixty months.

Signed: date 9/17/98 Installed by: A-1 BACKHOE

Improvement Permit by: C. [illegible] RS date 9/14/98 Operation Permit by: C. [illegible] RS date 12/7/98

Authorization to Construct by: C. [illegible] RS date 9/14/98 Existing System Inspection by: date

HEALTH DEPT. COPY: WHITE INSPECTION COPY (FINAL): GREEN OWNER COPY (FINAL): YELLOW INSPECTION COPY (INITIAL): PINK OWNER COPY (INITIAL): GOLD