(9.30)

IREDELL COUNTY HEALTH DEPARTMENT

STATESVILLE 704-878-5305 MOORESVILLE 704-664-5281

IMPROVEMENT PERMIT / AUTHORIZATION TO CONSTRUCT / OPERATION PERMIT / EXISTING SYSTEM INSPECTI

PERMIT# 071371 PIN# 4659 06 5262 PT 4649 96 5012 DATE 1/13/98

OWNER OR CONTRACTOR PRUITT DEV. CO. PHONE: Business 875-1081 Home

ADDRESS 124 KIRKWALL PL - MOORESVILLE NC - 28115

LOCATION 21/115 N - TL SAILWINDS - TL TRADEWINDS AT END

SUBDIVISION WINWARD PT BLOCK / SECTION LOT 131 LOT AREA .95AC SITE CLASS. RS DESIGN FLOW 360 L.T.A.R. .3

Septic Tank: 1000 Gallons; STB 1012 Date 6/22/98

Pump Tank: 1000 Gallons; PT 17 Date 7/16/98

Pump Make: Model Serial No.

Nitrification Field: No Fields 1 Square Feet 900 Linear Feet 300

No Lines 5 @ 60' Trench Width 36" Max Trench Bottom Depth 36" Gravel Depth N/A

☐ New System ☐ Repair System Type: I, II, III, IV, V, VI

System Description: PUMP CHAMBERED OR HDS

Repair System Description: SEE PUMP PANEL

Maintenance Agreement Required: ☐ Yes ☒ No

☐ House/Mod. Home No. Bedrooms 3

☑ Mobile Home No. Bathrooms 2

☐ Business No. Employees

☐ Other


☐ Slab ☑ Crawl Space ☐ Basement w/plumbing ☐ Basement wo/plumbing

Water Supply: ☑ Individual ☐ Public ☐ Community

Comments:/Conditions:

Comments:/Conditions:

INITIAL SITE SKETCH 1"=100'

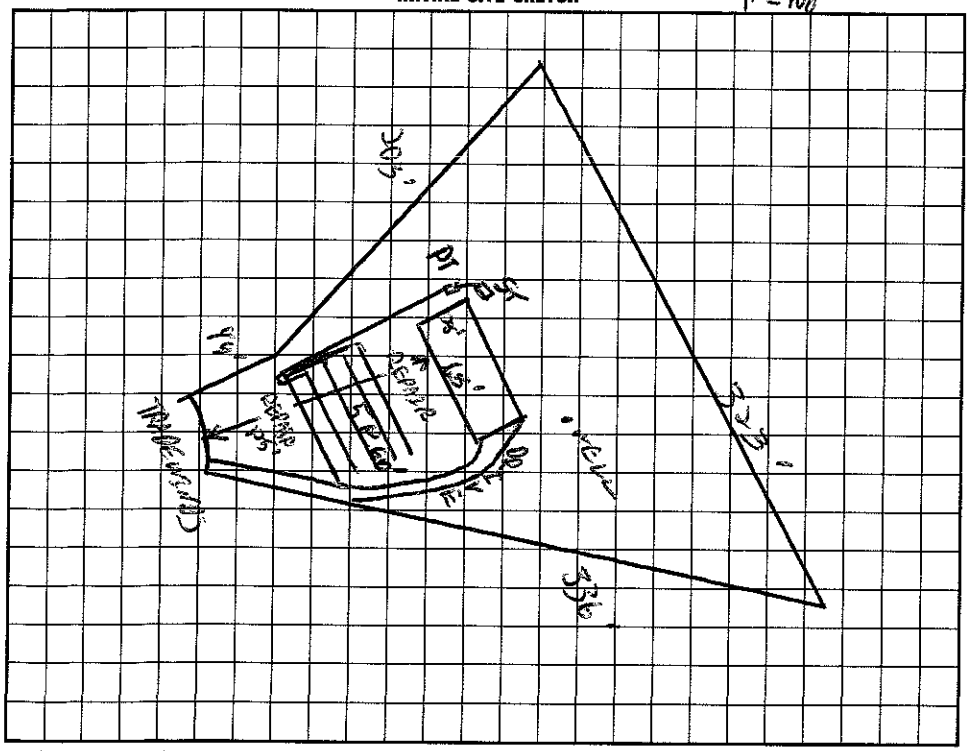

AS BUILT SKETCH

I understand that this permit can be suspended or revoked if any false information is supplied toward securing the permit/any unauthorized changes are made to the site/any unauthorized changes are made in the installation of the system. Improvement Permit with plat valid without expiration. Improvement Permit with site plan valid for sixty months. Authorization to Construct is valid for a period equal to that of Improvement Permit – not to exceed sixty months.

Signed: date

Improvement Permit by: C. Ray Thomas date 1/13/98

Authorization to Construct by: C. Ray Thomas date 1/13/98

Installed by: Al Brackett

Operation Permit by: C. Ray Thomas RS date 10/15/98

Existing System Inspection by: date

HEALTH DEPT. COPY: WHITE INSPECTION COPY (FINAL): GREEN OWNER COPY (FINAL): YELLOW INSPECTION COPY (INITIAL): PINK OWNER COPY (INITIAL): GOLD