2:00

# IREDELL COUNTY HEALTH DEPARTMENT

STATESVILLE 704-878-5305 MOORESVILLE 704-664-5281

## IMPROVEMENT PERMIT / AUTHORIZATION TO CONSTRUCT / OPERATION PERMIT / EXISTING SYSTEM INSPECTION

PERMIT# 074462 PIN# 4649965537 DATE 9/10/98

OWNER OR CONTRACTOR PRUITT DEV. PHONE: Business Home 660-5900

ADDRESS 21/115 N; TL SAILWINDS - TL; TRADEWINDS - ON RT

LOCATION

SUBDIVISION WINWARD PT BLOCK / SECTION 2 LOT 125 LOT AREA .72AC SITE CLASS. RS DESIGN FLOW 360GPD L.T.A.R. .30GPD/FT²

Septic Tank: 1000 Gallons; STB 1012 Date 9/23/98
Pump Tank: Gallons; PT Date
Pump Make: Model Serial No.
Nitrification Field: No Fields 1 Square Feet 900 Linear Feet 300
No Lines 4@75' Trench Width 36" Max Trench Bottom Depth 36" Gravel Depth N/A

☑ New System ☐ Repair System Type: I, II, III, IV, V, VI
System Description: GRAVITY CHAMBERS
Repair System Description: SAME
Maintenance Agreement Required: ☐ Yes ☑ No


☐ House/Mod. Home No. Bedrooms 3
☑ Mobile Home No. Bathrooms 2
☐ Business No. Employees
☐ Other
☐ Slab ☑ Crawl Space ☐ Basement w/plumbing ☐ Basement wo/plumbing

Water Supply: ☑ Individual ☐ Public ☐ Community


Comments:/Conditions: Well not installed at time of inspection.
1st line feed 1st, next 3 lines feed equal.

Comments:/Conditions:

**INITIAL SITE SKETCH** 1"=50'

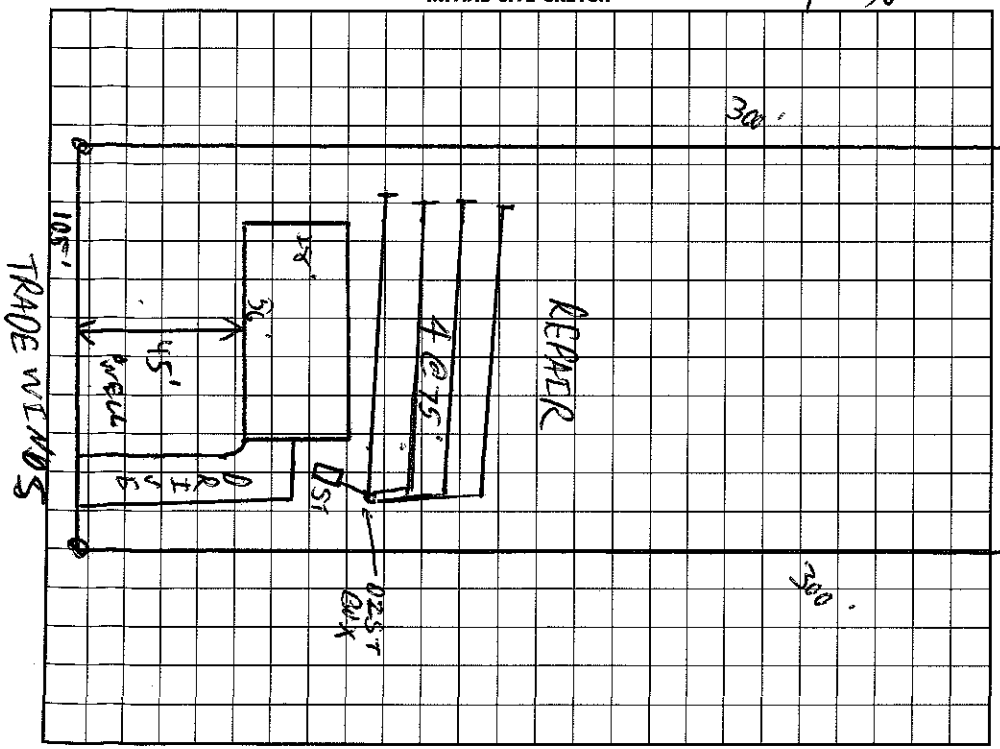


**AS BUILT SKETCH**

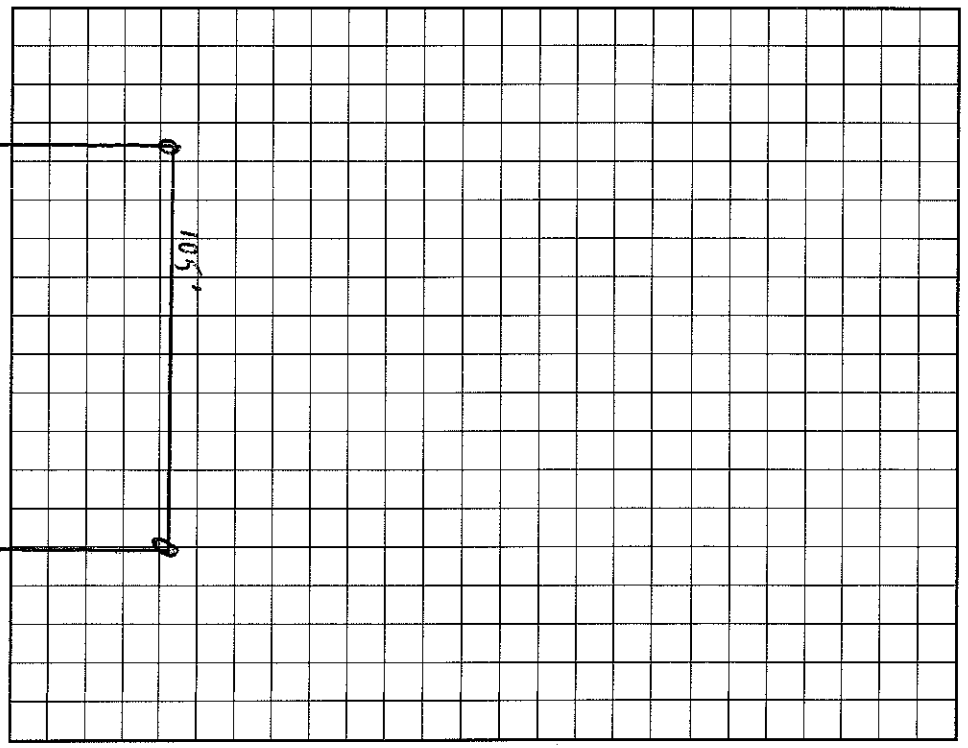


I understand that this permit can be suspended or revoked if any false information is supplied toward securing the permit/any unauthorized changes are made to the site/any unauthorized changes are made in the installation of the system. Improvement Permit with plat valid without expiration. Improvement Permit with site plan valid for sixty months. Authorization to Construct is valid for a period equal to that of Improvement Permit – not to exceed sixty months.

Signed: date 9/11/98
Improvement Permit by: C. M. Thomas RS date 9/10/98
Authorization to Construct by: C. M. Thomas RS date 9/10/98

Installed by: A-1 Backhoe R.S.
Operation Permit by: Marie H. Watson date 12/4/98
Existing System Inspection by: date

HEALTH DEPT. COPY: WHITE INSPECTION COPY (FINAL): GREEN OWNER COPY (FINAL): YELLOW INSPECTION COPY (INITIAL): PINK OWNER COPY (INITIAL): GOLD