(4:00)

IREDELL COUNTY HEALTH DEPARTMENT

STATESVILLE 704-878-5305 MOORESVILLE 704-664-5281

IMPROVEMENT PERMIT / AUTHORIZATION TO CONSTRUCT / OPERATION PERMIT / EXISTING SYSTEM INSPECTION

PERMIT# 074458 PIN# 4649 966755 DATE 7/15/98

OWNER OR CONTRACTOR PRUITT DEV. PHONE: Business 660-5900 Home

ADDRESS 142 STUTTS RD. MOORESVILLE NC 28115

LOCATION 21/115 N/- TL SALLWINDS - T L TRADEWINDS - 2nd ON RT

SUBDIVISION WINWARD PT BLOCK / SECTION 2 LOT 123 LOT AREA .8 AC SITE CLASS. RS DESIGN FLOW 360GPD L.T.A.R. .30PD/FT

Septic Tank: 1000 Gallons; STB ~~1000~~ 1050 Date 1/4/99

Pump Tank: 1000 Gallons; PT 17 Date 1/27/99

Pump Make: HYDROMATIC Model SK50 Serial No.

Nitrification Field: No Fields 1 Square Feet 900 Linear Feet 300

No Lines 3@100' Trench Width 36" Max Trench Bottom Depth 36" Gravel Depth NA

☑ ~~New System~~ ☐ Repair System Type: I, II, III, IV, V, VI

System Description: PUMP CHAMBERS OR HDS

Repair System Description: SAME

Maintenance Agreement Required: ☐ Yes ☑ ~~No~~

☐ House/Mod. Home ☑ ~~Mobile Home~~ ☐ Business ☐ Other

No. Bedrooms 3 No. Bathrooms 2 No. Employees

Water Supply: ☑ ~~Individual~~ ☐ Public ☐ Community


☐ Slab ☑ ~~Crawl Space~~ ☐ Basement w/plumbing ☐ Basement wo/plumbing

Comments:/Conditions: MAY CHANGE TANKS TO OTHER SOON


(NO FLOAT TREE) TANKS CHANGED TO OTHER SOON.

Comments:/Conditions:

INITIAL SITE SKETCH 1"=50'

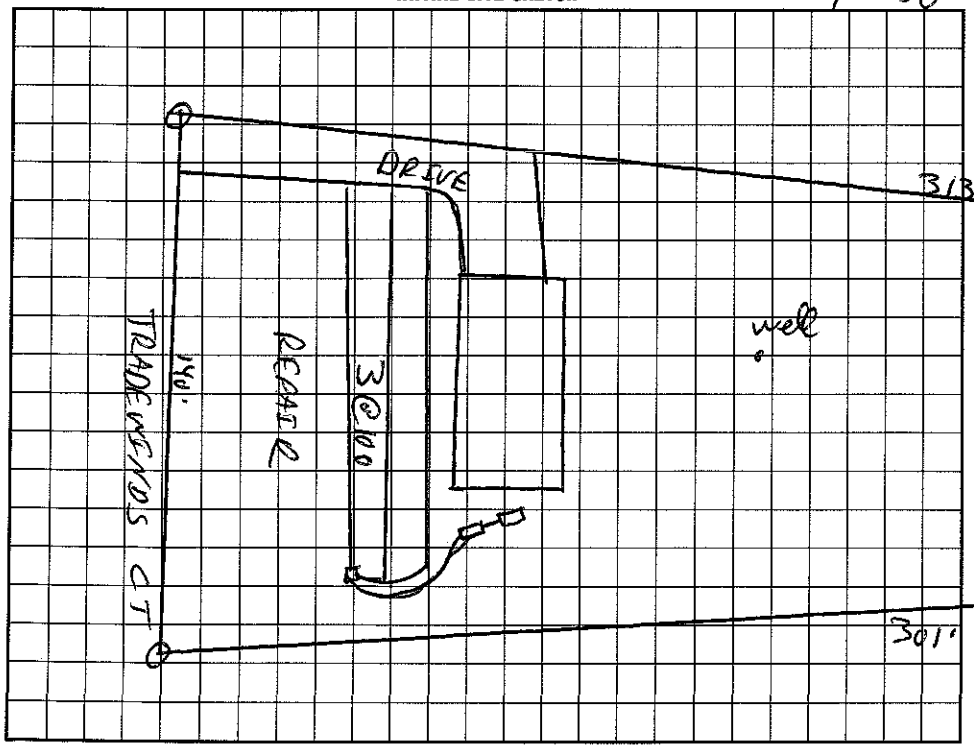

AS BUILT SKETCH

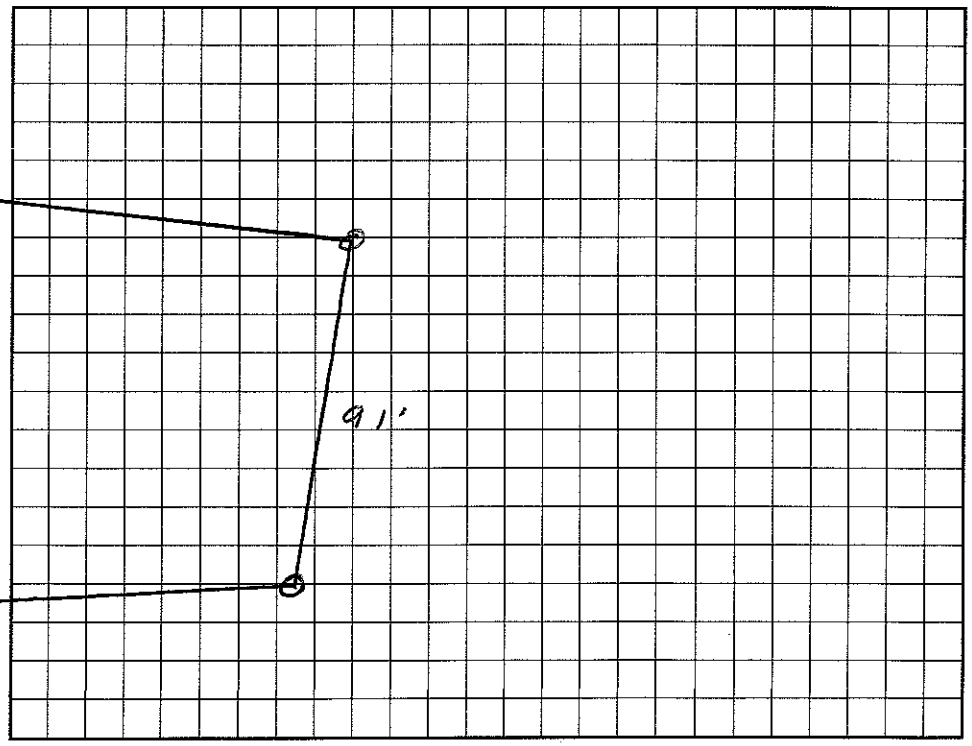

I understand that this permit can be suspended or revoked if any false information is supplied toward securing the permit/any unauthorized changes are made to the site/any unauthorized changes are made in the installation of the system. Improvement Permit with plat valid without expiration. Improvement Permit with site plan valid for sixty months. Authorization to Construct is valid for a period equal to that of Improvement Permit – not to exceed sixty months.

Signed: date 7/21/98 Installed by: A1 BACKHOE

Improvement Permit by: C. Tom RS date 7/18/98 Operation Permit by: C. Tom RS date 4/1/99

Authorization to Construct by: C. Tom RS date 7/15/98 Existing System Inspection by: date

HEALTH DEPT. COPY: WHITE INSPECTION COPY (FINAL): GREEN OWNER COPY (FINAL): YELLOW INSPECTION COPY (INITIAL): PINK OWNER COPY (INITIAL): GOLD