9:45

IREDELL COUNTY HEALTH DEPARTMENT

STATESVILLE 704-878-5305 MOORESVILLE 704-664-5281

IMPROVEMENT PERMIT / AUTHORIZATION TO CONSTRUCT / OPERATION PERMIT / EXISTING SYSTEM INSPECTION

DATE 6/29/98

PERMIT# 073640 PIN# 4649 96 7221

OWNER OR CONTRACTOR Pruitt Development PHONE: Business 875-0081 Home

ADDRESS 124 Kirkwall Pl. Mooresville, NC. 28115

LOCATION 141 Tradewinds Ct., 115 NTL Saikwinds TL Tradewinds, to 8th lot on (L)

SUBDIVISION Windward Point BLOCK / SECTION 2 LOT 133 LOT AREA .94 SITE CLASS. RS DESIGN FLOW 360 L.T.A.R. .3

Septic Tank: 1000 Gallons; STB 1012 Date 9/1/98

Pump Tank: 1000 Gallons; PT Date

Pump Make: Model Serial No.

Nitrification Field: No Fields 1 Square Feet 630 Linear Feet 210

No Lines 3 Trench Width 36" Max Trench Bottom Depth 36" Gravel Depth SAND.

☒ New System ☐ Repair System Type: I, II, III, IV, V, VI

System Description: ~~Gravity~~ Pressure Panel

Repair System Description: Pressure Panel

Maintenance Agreement Required: ☐ Yes ☑ No

☐ House/Mod. Home ☒ Mobile Home ☐ Business ☐ Other

No. Bedrooms 3 No. Bathrooms 3 No. Employees

☐ Slab ☒ Crawl Space ☐ Basement w/plumbing ☐ Basement wo/plumbing


Water Supply: ☒ Individual ☐ Public ☐ Community

Comments:/Conditions:


Comments:/Conditions:

Changed to gravity Panels by Betty Zee 11/2/98

INITIAL SITE SKETCH

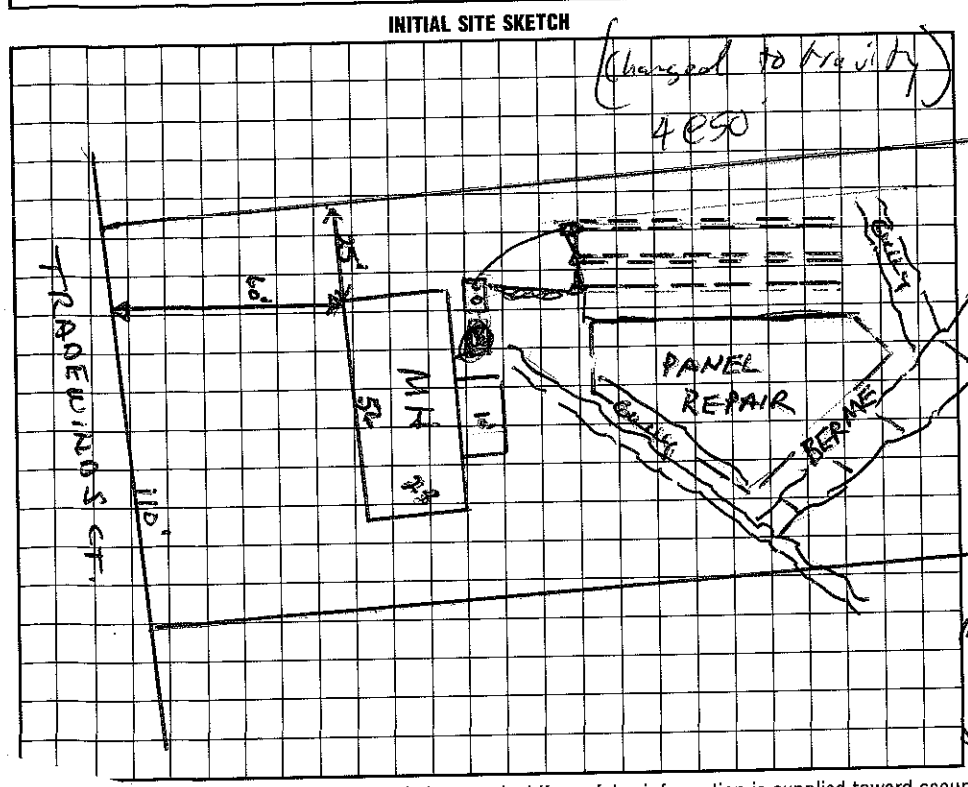

AS BUILT SKETCH

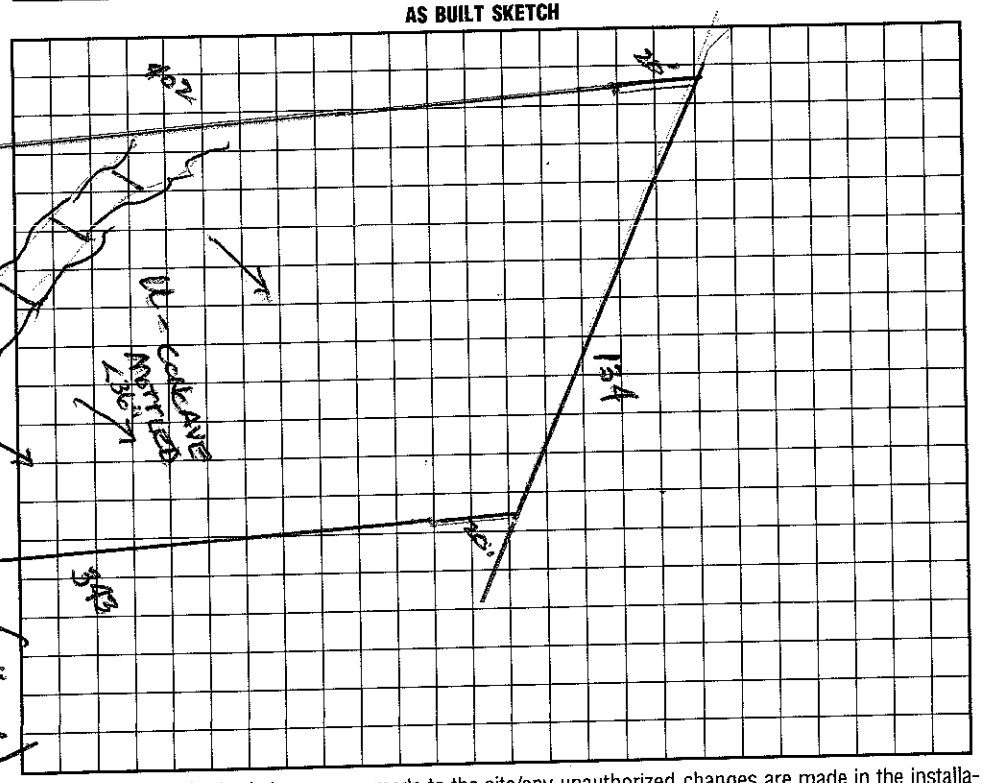

This permit can be suspended or revoked if any false information is supplied toward securing the permit/any unauthorized changes are made to the site/any unauthorized changes are made in the installation. Permit with plat valid without expiration. Improvement Permit with site plan valid for sixty months. Authorization to Construct is valid for a period equal to that of Improvement Permit – not

date 6/30/98

date 6/29/98

Installed by: A1 Backhoe

Operation Permit by: date 11/3/98

Existing System Inspection by: date

YELLOW INSPECTION COPY (INITIAL): PINK OWNER COPY (INITIAL): GOLD