IREDELL COUNTY HEALTH DEPARTMENT

STATESVILLE 704-878-5305 MOORESVILLE 704-664-5281

IMPROVEMENT PERMIT / AUTHORIZATION TO CONSTRUCT / OPERATION PERMIT / EXISTING SYSTEM INSPECTION

PERMIT# 072860 PIN# 4659 06 5262 (pt) 4649 91 8218 DATE May 19, 1998

OWNER OR CONTRACTOR Pruitt Dev. Co. PHONE: Business 875-0081 Home

ADDRESS 124 Kirkwall Pl. Mooresville

LOCATION 115-21 N. TL Sailwinds TL Tradewinds Ct. on left NEAR END

SUBDIVISION Windward Pt. BLOCK / SECTION II LOT 134 LOT AREA ~1 Ac. SITE CLASS PS DESIGN FLOW 360gpd L.T.A.R. ~.25-.3

Septic Tank: 1000 Gallons; STB 1612 Date 3/27/98
Pump Tank: Gallons; PT Date
Pump Make: Model Serial No.
Nitrification Field: No Fields 1 Square Feet 960 Linear Feet 320
No Lines 4 Trench Width 36" Max Trench Bottom Depth 36"

☑ New System ☐ Repair System Type: I, II, III, IV, V, VI
System Description: Gravity MODified 25% Red.
Repair System Description: Pumped MODified
Maintenance Agreement Required: ☐ Yes ☑ No
Gravel Depth NA

☐ House/Mod. Home No. Bedrooms 3
☑ Mobile Home No. Bathrooms 2
☐ Business No. Employees
☐ Other
☐ Slab ☑ Crawl Space ☐ Basement w/plumbing ☐ Basement wo/plumbing


Water Supply: ☑ Individual ☐ Public ☐ Community

Comments:/Conditions: ONE inspection/observation port per LATERAL
Can USE either D-box w/ spreader levelers OR Drop Boxes


Comments:/Conditions: 52 L.25

1"=60'

INITIAL SITE SKETCH

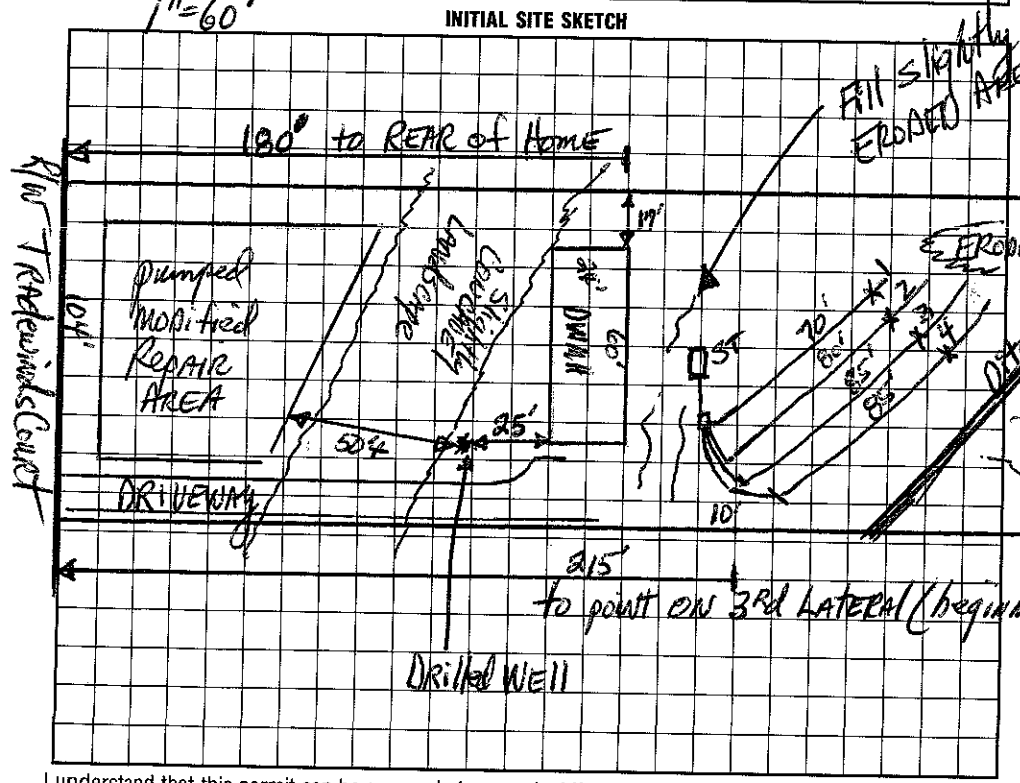

AS BUILT SKETCH

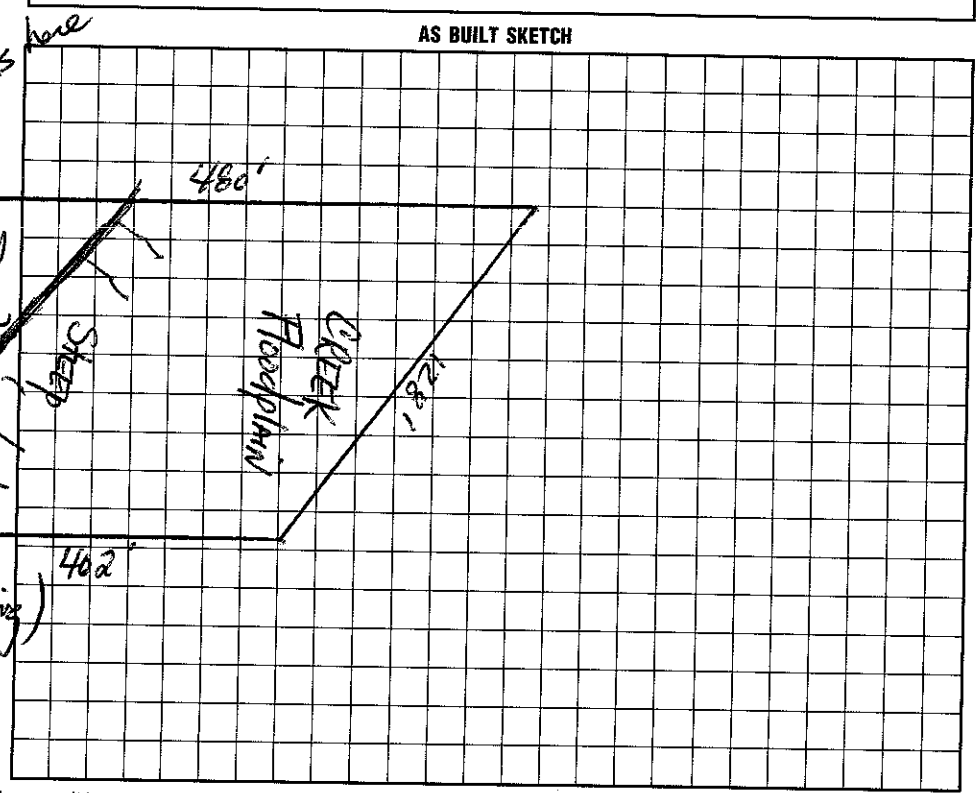

I understand that this permit can be suspended or revoked if any false information is supplied toward securing the permit/any unauthorized changes are made to the site/any unauthorized changes are made in the installation of the system. Improvement Permit with plat valid without expiration. Improvement Permit with site plan valid for sixty months. Authorization to Construct is valid for a period equal to that of Improvement Permit – not to exceed sixty months.

Signed:

Improvement Permit by: RS date

Authorization to Construct by: RS date 5-19-98

Installed by: A1 Backhoe

Operation Permit by: Wesley Sparks RS date 5/28/98

Existing System Inspection by: Wesley Sparks RS date 5/29/98

HEALTH DEPT. COPY: WHITE INSPECTION COPY (FINAL): GREEN OWNER COPY (FINAL): YELLOW INSPECTION COPY (INITIAL): PINK OWNER COPY (INITIAL): GOLD