IREDELL COUNTY HEALTH DEPARTMENT

STATESVILLE 704-878-5305 MOORESVILLE 704-664-5281

IMPROVEMENT PERMIT / AUTHORIZATION TO CONSTRUCT / OPERATION PERMIT / EXISTING SYSTEM INSPECTION

PERMIT# 072860 PIN# 4659 06 3262 (pt) 4649 96 8218 DATE May 19, 98

OWNER OR CONTRACTOR Pruitt Dev. Co. PHONE: Business 875-0281 Home

ADDRESS 124 Kirkwall Pl. Mooresville

LOCATION 115-21 N. TL Sailwinds TL Tradewinds Ct. on left near End

SUBDIVISION Whitehurst Pt. BLOCK / SECTION 2 LOT 134 LOT AREA n/a SITE CLASS PS DESIGN FLOW 360gpd L.T.A.R. n.25-.3

Septic Tank: 1060 Gallons; STB 1612 Date 3/27/98
Pump Tank: Gallons; PT Date
Pump Make: Model Serial No.
Nitrification Field: No Fields 1 Square Feet 960 Linear Feet 320
No Lines 4 Trench Width 36" Max Trench Bottom Depth 36" Gravel Depth N/A

☒ New System ☐ Repair System Type: I, II, III, IV, V, VI
System Description: Gravity Modified 25% Red.
Repair System Description: Pumped Modified
Maintenance Agreement Required: ☐ Yes ☒ No

☐ House/Mod. Home ☒ Mobile Home ☐ Business ☐ Other
No. Bedrooms 3 No. Bathrooms 2 No. Employees


Water Supply: ☒ Individual ☐ Public ☐ Community

☐ Slab ☒ Crawl Space ☐ Basement w/plumbing ☐ Basement wo/plumbing


Comments/Conditions: DHE inspection/observation part per Lateral
Can USE either Drop w/ Speed levelers or Deep Bofas

Comments/Conditions: 52
L.25

INITIAL SITE SKETCH 1"=60'

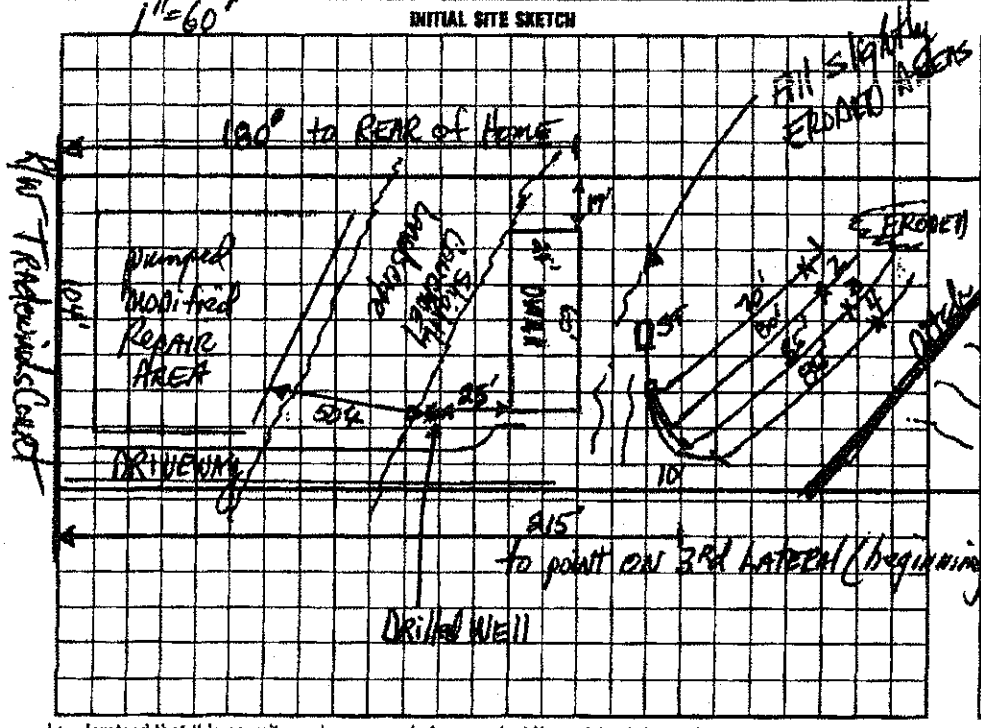

AS BUILT SKETCH

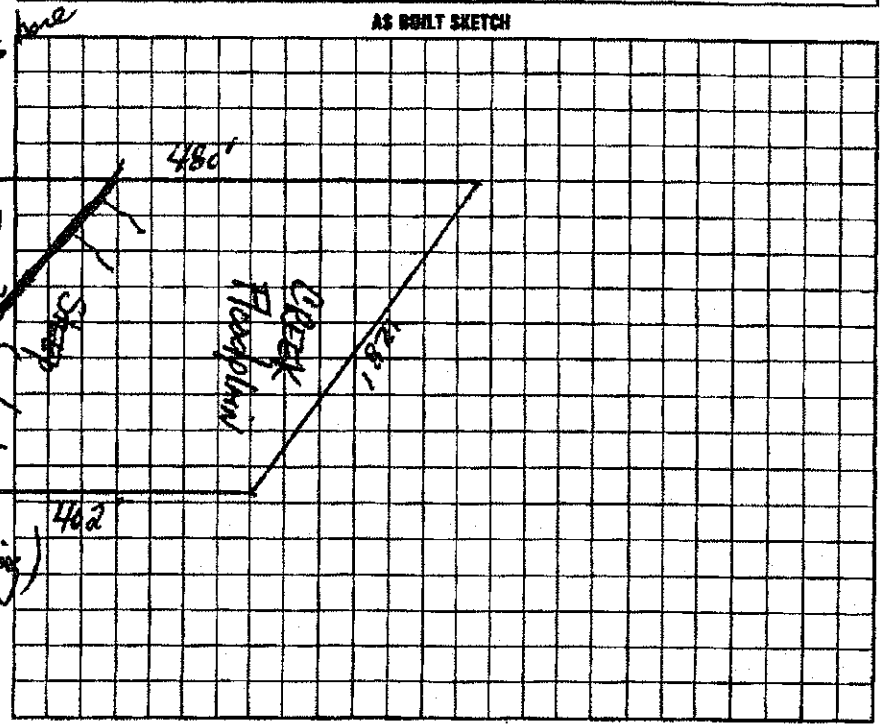

I understand that this permit can be suspended or revoked if any false information is supplied toward securing the permit/any unauthorized changes are made to the site/any unauthorized changes are made in the installation of the system. Improvement Permit with plat valid without expiration. Improvement Permit with site plan valid for sixty months. Authorization to Construct is valid for a period equal to that of Improvement Permit – not to exceed sixty months.

Signed: date

Improvement Permit by: RS date 5-19-98

Authorization to Construct by: RS date 5-14-98

Installed by: Al Backhoe

Operation Permit by: RS date 5/29/98

Existing System Inspection by: RS date 5/29/98

HEALTH DEPT. COPY: WHITE INSPECTION COPY (FINAL): GREEN OWNER COPY (FINAL): YELLOW INSPECTION COPY (INITIAL): PINK OWNER COPY (INITIAL): GOLD