IREDELL COUNTY HEALTH DEPARTMENT

STATESVILLE 704-878-5305 MOORESVILLE 704-664-5281

IMPROVEMENT PERMIT / AUTHORIZATION TO CONSTRUCT / OPERATION PERMIT / EXISTING SYSTEM INSPECTION

PERMIT# 074728 PIN# 4649 96 8497 DATE 10/7/98

OWNER OR CONTRACTOR Pruitt Development PHONE: Business Home 660-5900

ADDRESS 142 Hutts Rd. Mooresville, NC. 28115

LOCATION 21/115 TL SAILWINDS CT TL TRADEWINDS ON (L) BEFORE CUL DE SAC

SUBDIVISION WINWARD PT. BLOCK / SECTION 2 LOT 136 LOT AREA .99 AC SITE CLASS. RS DESIGN FLOW 360 L.T.A.R. .3

Septic Tank: 1000 Gallons; STB 1012 Date 8/4/98
Pump Tank: Gallons; PT Date
Pump Make: Model Serial No.
Nitrification Field: No Fields 1 Square Feet 1200 Linear Feet 400
No Lines 4 Trench Width 36" Max Trench Bottom Depth 36" Gravel Depth SAND.

[X] New System [ ] Repair System Type: I, II, (III) IV, V, VI
System Description: GR-CH PLASTIC
Repair System Description: SAME
Maintenance Agreement Required: [ ] Yes [X] No


[X] House/Mod. Home No. Bedrooms 4
[ ] Mobile Home No. Bathrooms 3
[ ] Business No. Employees
[ ] Other
[ ] Slab [X] Crawl Space [ ] Basement w/plumbing [ ] Basement wo/plumbing

Water Supply: [X] Individual [ ] Public [ ] Community


Comments:/Conditions:

Comments:/Conditions:

INITIAL SITE SKETCH

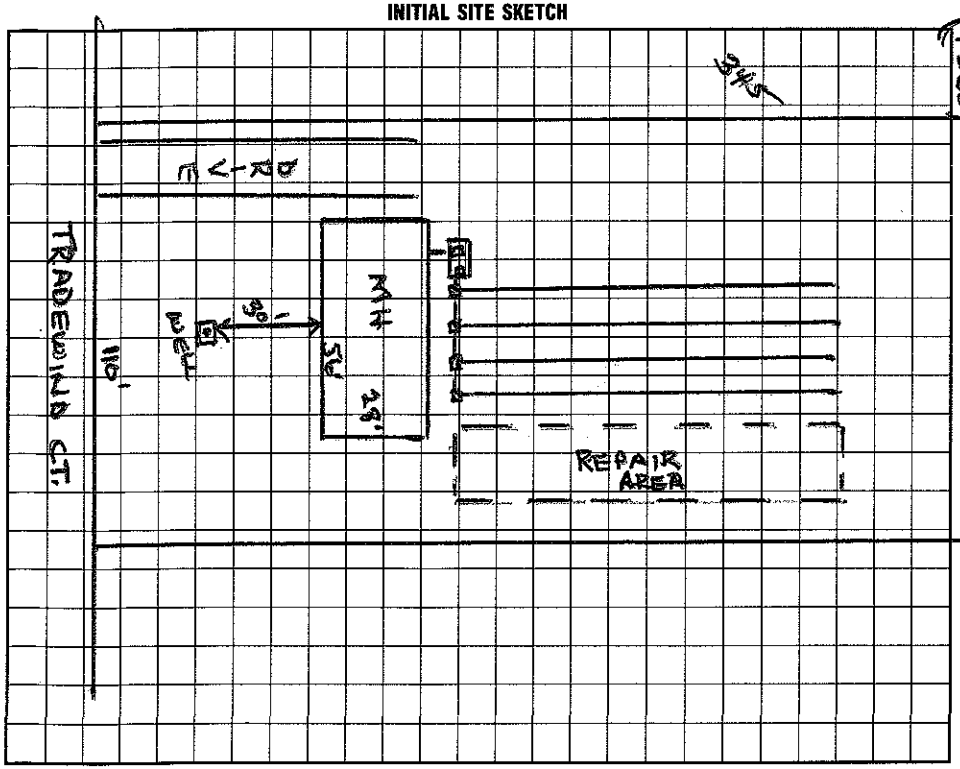

AS BUILT SKETCH

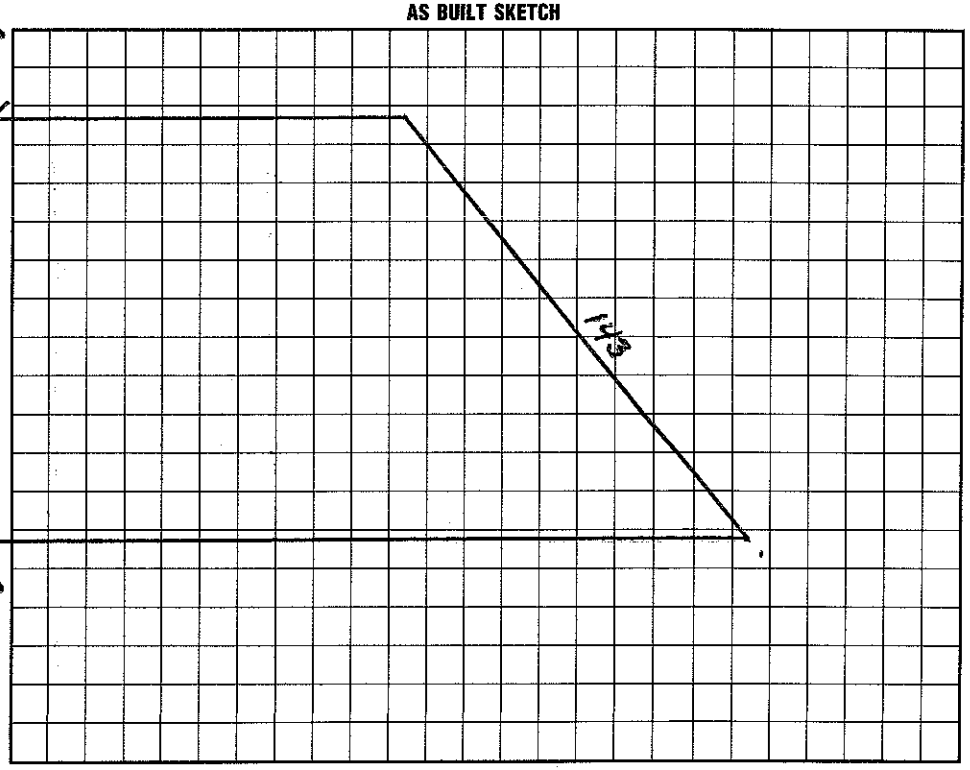

I understand that this permit can be suspended or revoked if any false information is supplied toward securing the permit/any unauthorized changes are made to the site/any unauthorized changes are made in the installation of the system. Improvement Permit with plat valid without expiration. Improvement Permit with site plan valid for sixty months. Authorization to Construct is valid for a period equal to that of Improvement Permit – not to exceed sixty months.

Signed: X date 10/9/98 Installed by: A-1 BACKHOE

Improvement Permit by: date Operation Permit by: Wesley Sparks RS. date 10/7/98

Authorization to Construct by: date Existing System Inspection by: date

HEALTH DEPT. COPY: WHITE INSPECTION COPY (FINAL): GREEN OWNER COPY (FINAL): YELLOW INSPECTION COPY (INITIAL): PINK OWNER COPY (INITIAL): GOLD

IREDELL COUNTY HEALTH DEPARTMENT

STATESVILLE 704-878-5305 (Piedmont) MOORESVILLE 704-664-5281 (3;30)

IMPROVEMENT PERMIT / AUTHORIZATION TO CONSTRUCT / OPERATION PERMIT / EXISTING SYSTEM INSPECTION

PERMIT# 074736 PIN# 4649968497 DATE 8/6/98

OWNER OR CONTRACTOR PRUITT DEV PHONE: Business Home 660-5900

ADDRESS 142 SPRUCE RD. MOORESVILLE NC 28115

LOCATION 21/115 N. TO SAILINGS. TL TRADEWINDS ON LT

SUBDIVISION IRONWORKS PT BLOCK / SECTION 2 LOT 136 LOT AREA .994c SITE CLASS. RS DESIGN FLOW 360 L.T.A.R. - 3

Septic Tank: 1000 Gallons; STB 1012 Date 8/4/98
Pump Tank: Gallons; PT Date
Pump Make: Model Serial No.
Nitrification Field: No Fields 1 Square Feet 900 Linear Feet 300
No Lines 4@75' Trench Width 36" Max Trench Bottom Depth 36" Gravel Depth N/A

☑ New System ☐ Repair System Type: I, II, III, IV, V, VI
System Description: GRAVITY CONVENTIONAL
Repair System Description: SAME
Maintenance Agreement Required: ☐ Yes ☑ No


☐ House/Mod. Home ☐ Mobile Home ☐ Business ☐ Other
No. Bedrooms 4 (3) No. Bathrooms 3 2 No. Employees
☐ Slab ☑ Crawl Space ☐ Basement w/plumbing ☐ Basement wo/plumbing

Water Supply: ☑ Individual ☐ Public ☐ Community


Comments:/Conditions:

Comments:/Conditions:

INITIAL SITE SKETCH 1"=50'

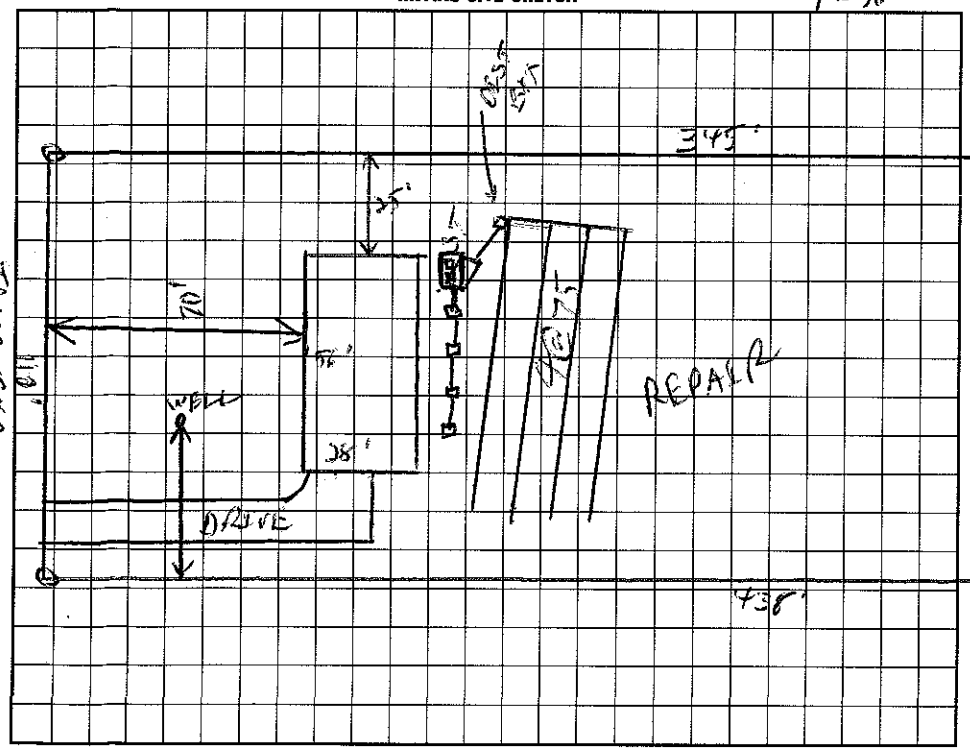

AS BUILT SKETCH

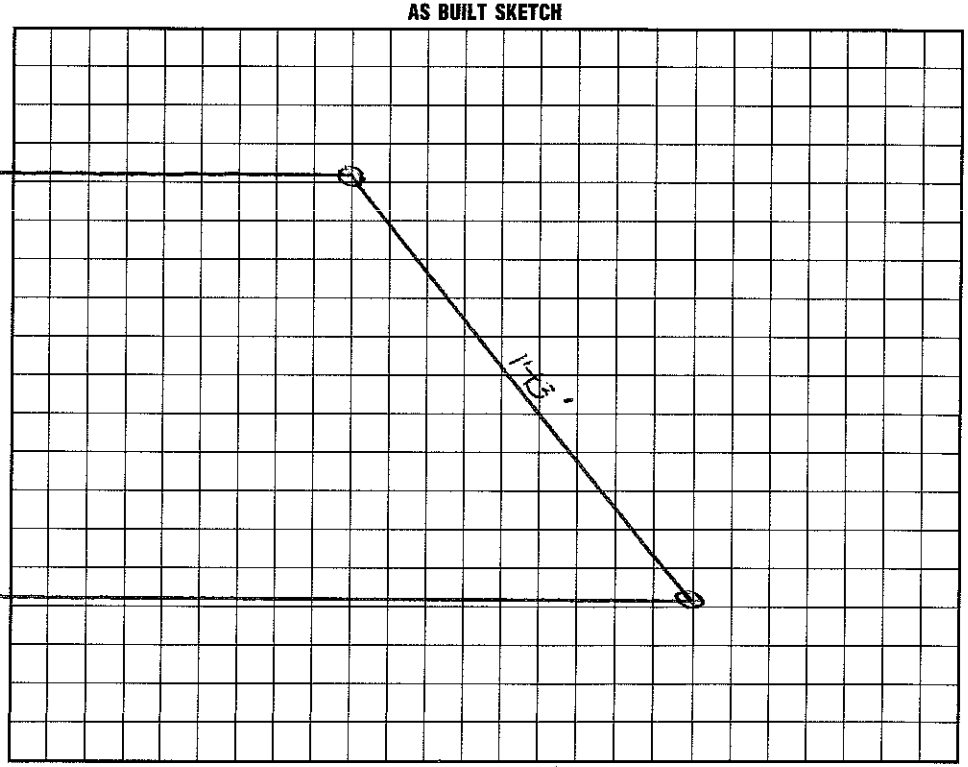

I understand that this permit can be suspended or revoked if any false information is supplied toward securing the permit/any unauthorized changes are made to the site/any unauthorized changes are made in the installation of the system. Improvement Permit with plat valid without expiration. Improvement Permit with site plan valid for sixty months. Authorization to Construct is valid for a period equal to that of Improvement Permit – not to exceed sixty months.

Signed: date

Improvement Permit by: C. B. Freeman RS date 8/6/98

Authorization to Construct by: C. B. Freeman RS date 8/6/98

Installed by: Art Buckhow

Operation Permit by: Wesley Apenbrink RS. date 10/7/98

Existing System Inspection by: date

HEALTH DEPT. COPY: WHITE INSPECTION COPY (FINAL): GREEN OWNER COPY (FINAL): YELLOW INSPECTION COPY (INITIAL): PINK OWNER COPY (INITIAL): GOLD