COUNTY HEALTH DEPARTMENT

STATESVILLE 704-878-5305 MOORESVILLE 704-664-5281

IMPROVEMENT PERMIT / AUTHORIZATION TO CONSTRUCT / OPERATION PERMIT / EXISTING SYSTEM INSPECTION

PERMIT# 073508 PIN# 4649969711 DATE 6/23/98

OWNER OR CONTRACTOR PRUITT DEV. PHONE: Business Home 660-5900

ADDRESS 142 STUITS RD - MOORESVILLE NC 28115

LOCATION HWY 21/115 N. TL SALUDA - TL TRADEWINDS - ON LT

SUBDIVISION WENWART DR BLOCK / SECTION LOT 138 LOT AREA .93 AC SITE CLASS. RS DESIGN FLOW 360 GPD L.T.A.R. .36 GPD/FT

Septic Tank: 1000 Gallons; STB 1012 Date 5-10-98

Pump Tank: Gallons; PT Date

Pump Make: Model Serial No.

Nitrification Field: No Fields 1 Square Feet 900 Linear Feet 300

No Lines 4 @ 75' Trench Width 36" Max Trench Bottom Depth 36" Gravel Depth N/A

☑ New System ☐ Repair System Type: I, II, III, IV, V, VI

System Description: GRAVITY CHAMBERS OR HOS

Repair System Description: GRAVITY PVC

Maintenance Agreement Required: ☐ Yes ☑ No

☑ House/Mod. Home No. Bedrooms 3

☐ Mobile Home No. Bathrooms 2

☐ Business No. Employees

☐ Other


☐ Slab ☑ Crawl Space ☐ Basement w/plumbing ☐ Basement wo/plumbing

Water Supply: ☑ Individual ☐ Public ☐ Community

Comments:/Conditions:

Comments:/Conditions:

INITIAL SITE SKETCH 1" = 50'

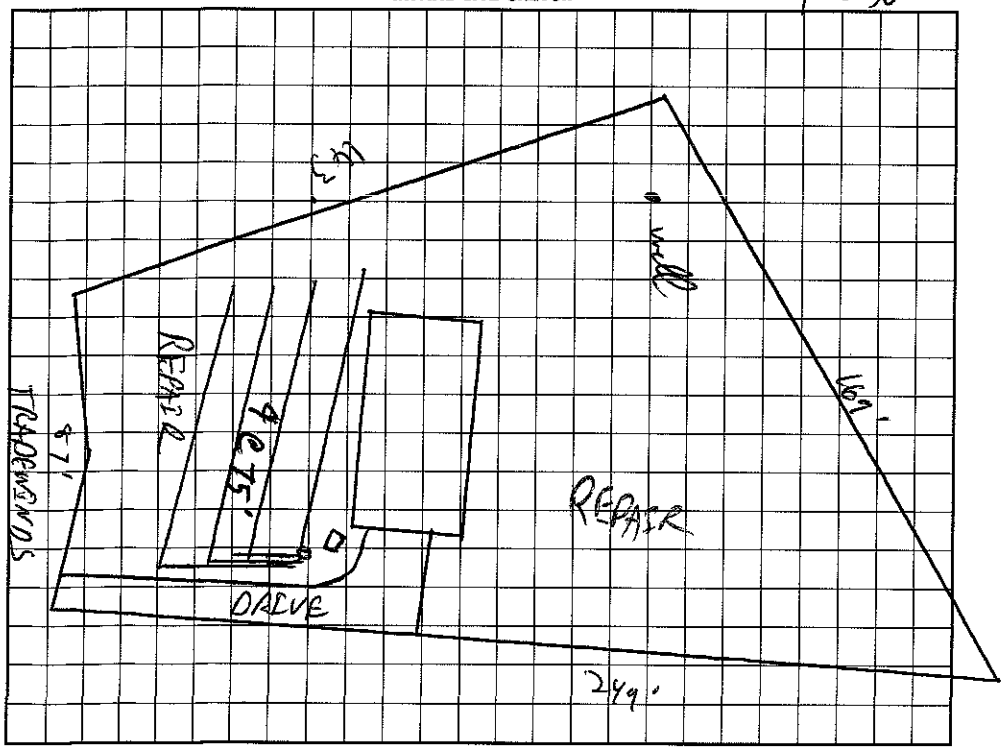

AS BUILT SKETCH

I understand that this permit can be suspended or revoked if any false information is supplied toward securing the permit/any unauthorized changes are made to the site/any unauthorized changes are made in the installation of the system. Improvement Permit with plat valid without expiration. Improvement Permit with site plan valid for sixty months. Authorization to Construct is valid for a period equal to that of Improvement Permit – not to exceed sixty months.

Signed: date

Improvement Permit by: C. KS date 6/23/98

Authorization to Construct by: C. KS date 6/23/98

Installed by: A-1 BACK HOE

Operation Permit by: C. date 9/21/98

Existing System Inspection by: date

HEALTH DEPT. COPY: WHITE INSPECTION COPY (FINAL): GREEN OWNER COPY (FINAL): YELLOW INSPECTION COPY (INITIAL): PINK OWNER COPY (INITIAL): GOLD