IREDELL COUNTY HEALTH DEPARTMENT

STATESVILLE 704-878-5305 MOORESVILLE 704-664-5281

IMPROVEMENT PERMIT / AUTHORIZATION TO CONSTRUCT / OPERATION PERMIT / EXISTING SYSTEM INSPECTION

PERMIT# 073436 PIN# 4649969823 DATE 6/3/98

OWNER OR CONTRACTOR PRUITT DEV. CORP PHONE: Business Home 875-0081

ADDRESS 124 KIRKWALL PL MOORESVILLE NC 28115

LOCATION CHARLOTTE HWY - HWY 21 - TL SAILWINDS - TL TRADEWINDS, 2nd ON LT

SUBDIVISION WYNWARD PT BLOCK / SECTION 2 LOT 139 LOT AREA .46AC SITE CLASS. PS1 DESIGN FLOW 360GPD L.T.A.R. .36GPD/FT2

Septic Tank: 1000 Gallons; STB 1017 Date 3/30/98

Pump Tank: Gallons; PT Date

Pump Make: Model Serial No.

Nitrification Field: No Fields 1 Square Feet 900 Linear Feet 300

No Lines 4@75' Trench Width 36" Max Trench Bottom Depth 36" Gravel Depth N/A

☑ New System ☐ Repair System Type: I, II, (III) IV, V, VI

System Description: GRAVITY CHAMBERS OR HDS

Repair System Description: GRAVITY PANEL

Maintenance Agreement Required: ☐ Yes ☑ No

☐ House/Mod. Home ☑ Mobile Home ☐ Business ☐ Other

No. Bedrooms 3 No. Bathrooms 2 No. Employees


☐ Slab ☑ Crawl Space ☐ Basement w/plumbing ☐ Basement wo/plumbing

Water Supply: ☑ Individual ☐ Public ☐ Community


Comments:/Conditions:

Comments:/Conditions: NO WELL ON SITE - FOOTINGS FOR HOME POURED -

INITIAL SITE SKETCH 1"=50'

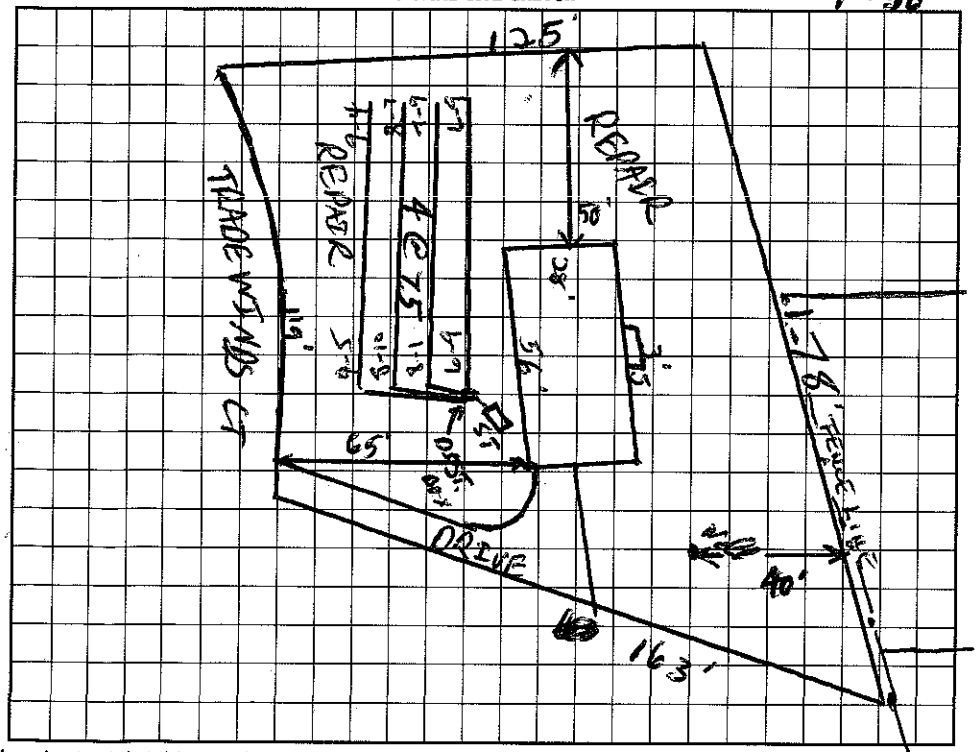

AS BUILT SKETCH

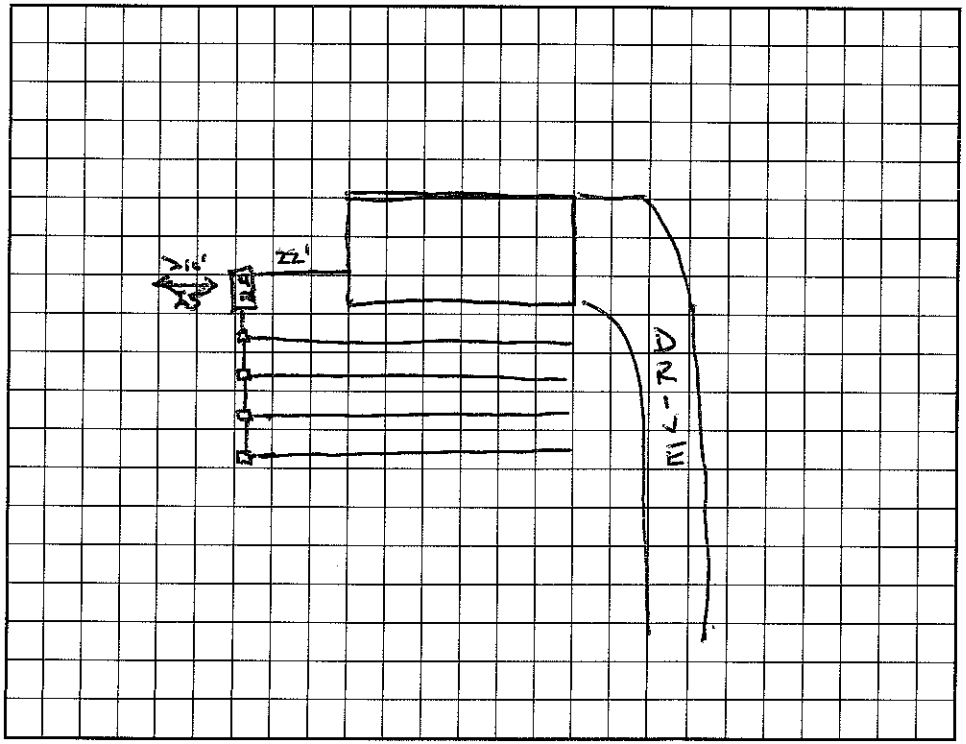

I understand that this permit can be suspended or revoked if any false information is supplied toward securing the permit/any unauthorized changes are made to the site/any unauthorized changes are made in the installation of the system. Improvement Permit with plat valid without expiration. Improvement Permit with site plan valid for sixty months. Authorization to Construct is valid for a period equal to that of Improvement Permit – not to exceed sixty months.

Signed: date

Improvement Permit by: C. [illegible] RS date 6/3/98

Authorization to Construct by: C. [illegible] RS date 6/3/98

Installed by: A-1 Backhoe Svcs.

Operation Permit by: Wesley Sparks RS. date 6/9/98

Existing System Inspection by: Wesley Sparks RS. date 6/9/98

HEALTH DEPT. COPY: WHITE INSPECTION COPY (FINAL): GREEN OWNER COPY (FINAL): YELLOW INSPECTION COPY (INITIAL): PINK OWNER COPY (INITIAL): GOLD