IREDELL COUNTY HEALTH DEPARTMENT

STATESVILLE 704-878-5305 MOORESVILLE 70[illegible]

IMPROVEMENT PERMIT / AUTHORIZATION TO CONSTRUCT / OPERATION PERMIT / EXISTING SYSTEM INS.

DATE 5/11/99

PERMIT# 77964 PIN# 4649970075 PHONE: Business Home

OWNER OR CONTRACTOR PRUITT DEV.

ADDRESS 142 STUTTS RD MOORESVILLE 28117

LOCATION 21/15 N/- TL SADDLEWOOD 1/4 mi LOT ON RT SITE CLASS. PS DESIGN FLOW 360 L.T.A.R. .3

SUBDIVISION WINDWARD DT BLOCK / SECTION 2 LOT 95 LOT AREA .50AC

Septic Tank: 1000 Gallons; STB IP1012 Date 6/21/99

Pump Tank: Gallons; PT Date

Pump Make: Model Serial No.

Nitrification Field: No Fields 1 Square Feet 400 Linear Feet 300

No Lines 5@60' Trench Width 36" Max Trench Bottom Depth 36" Gravel Depth N/A

☑ New System ☐ Repair System Type: I, II, (III), IV, V, VI

System Description: GRAVITY CHAMBERS OR HS

Repair System Description: PANEL

Maintenance Agreement Required: ☐ Yes ☑ No

☐ House/Mod. Home ☐ Mobile Home ☐ Business ☐ Other

No. Bedrooms 3 No. Bathrooms 2 No. Employees


Water Supply: ☑ Individual ☐ Public ☐ Community

☐ Slab ☑ Crawl Space ☐ Basement w/plumbing ☐ Basement wo/plumbing

Comments:/Conditions: Well Not installed at time of inspection
Drop boxes used.
Riser & filter installed

Comments:/Conditions:

INITIAL SITE SKETCH

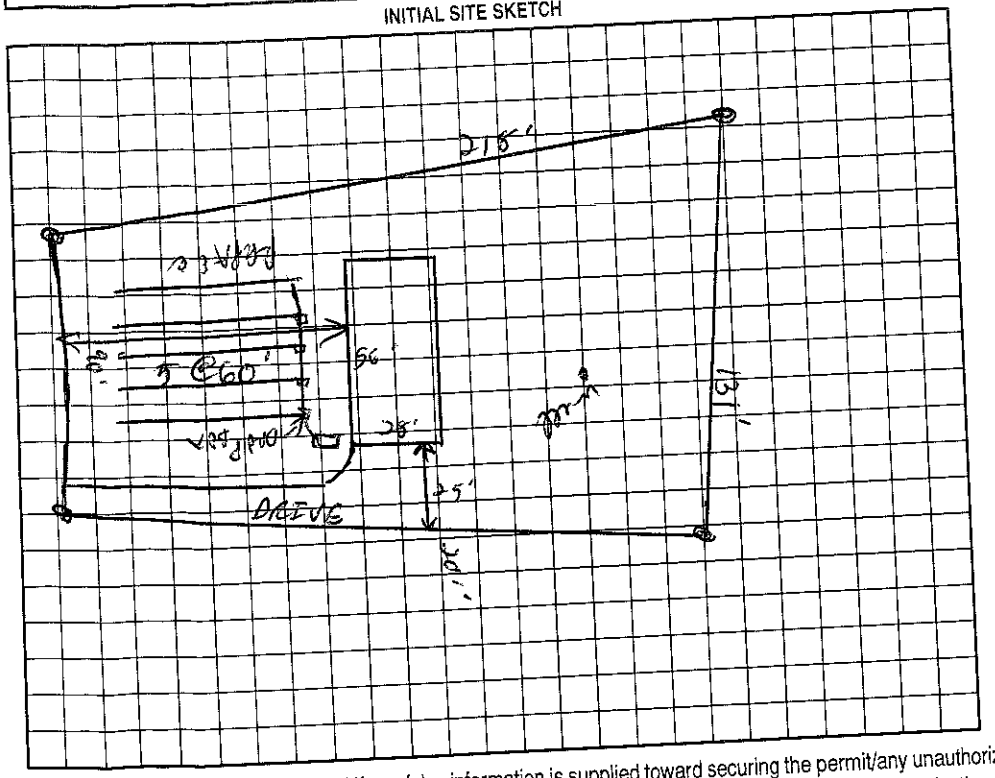

AS BUILT SKETCH

Installed as Drawn

Permit can be suspended or revoked if any false information is supplied toward securing the permit/any unauthorized changes are made to the site/any unauthorized changes are made in the installation of the system. Improvement Permit with plat valid without expiration. Improvement Permit with site plan valid for sixty months. Authorization to Construct is valid for a period equal to that of Improvement Permit – not to exceed sixty months.

Signed: date 6/18/99

date 5/11/99 5/11/99

Installed by: A-1 Backhoe & Dozer RS date 8/23/99

Operation Permit by: Maina H. Dotson date

Existing System Inspection by:

OWNER COPY (INITIAL): PINK