IREDELL COUNTY HEALTH DEPARTMENT

STATESVILLE 704-878-5305 MOORESVILLE 704-664-5281

IMPROVEMENT PERMIT / AUTHORIZATION TO CONSTRUCT / OPERATION PERMIT / EXISTING SYSTEM INSPECTION

PERMIT# 091665 PIN# 4L49970660 DATE 8/31/00

OWNER OR CONTRACTOR Ray Blankenship PHONE: Business Troutman, NC 28166 Home 528-0974

ADDRESS 215 Sacred Ln LOCATION Hwy 115 N TL Flower House TL Rankin Hill TL Thoroughbred TL Sacred

SUBDIVISION Palomino Pk BLOCK / SECTION LOT 44 LOT AREA SITE CLASS PS DESIGN FLOW 360 L.T.A.R.

Septic Tank: 1000 existing Gallons: STB Date

Pump Tank: Gallons: PT Date

Pump Make: Model Exist Serial No.

Nitrification Field: No Fields Square Feet 900 Linear Feet 300

No Lines 3 Trench Width 36" Max Trench Bottom Depth Gravel Depth 12"

☒ New System ☐ Repair System Type: I, II, III, IV, V, VI

System Description: Existing Gravity-Conventional

Repair System Description: Same

Maintenance Agreement Required: ☐ Yes ☒ No

☐ House/Mod. Home ☒ Mobile Home ☐ Business ☐ Other

No. Bedrooms 3 No. Bathrooms 2 No. Employees


☐ Slab ☐ Crawl Space ☐ Basement w/plumbing ☐ Basement wo/plumbing

Water Supply: ☒ Individual ☐ Public ☐ Community


Comments/Conditions: Existing Septic System appears to be functioning okay at the of inspection, No problems Noticed

Comments/Conditions: Addition to home will include 1 bedroom, DEN & study. Septic System permitted for 3 Bedrooms (existing MH only last 2 Bedrooms Now)

INITIAL SITE SKETCH

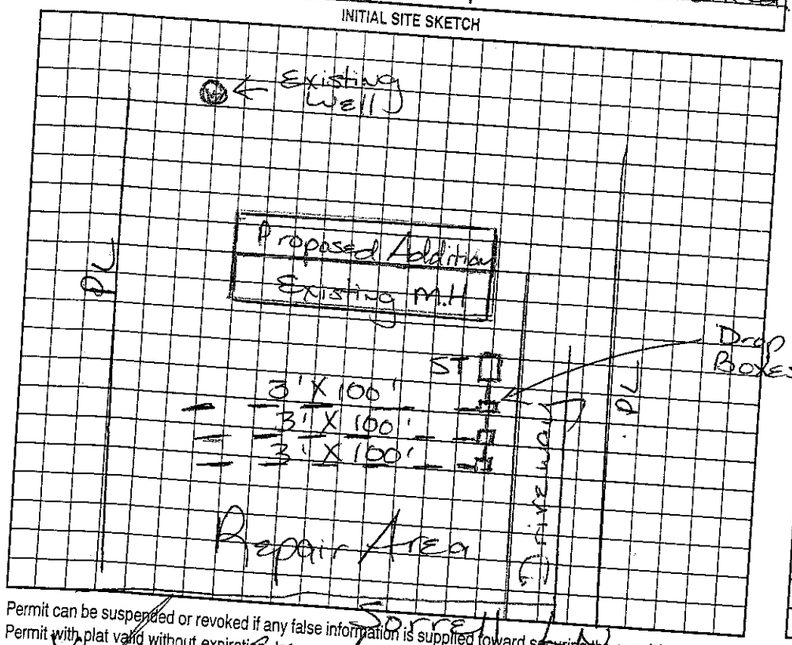

AS BUILT SKETCH

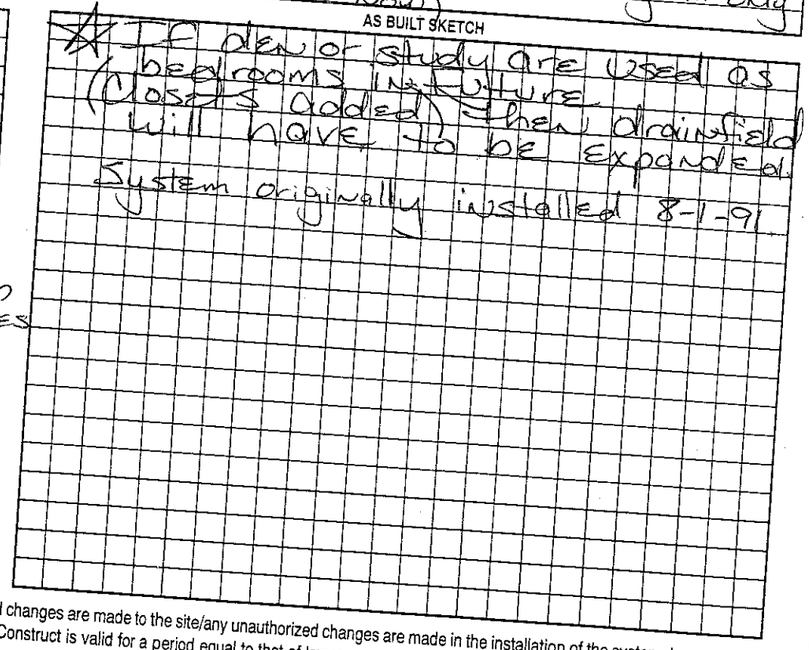

If den or study are used as bedrooms in future, (closets added) then drainfield will have to be expanded.

System originally installed 8-1-91

Permit can be suspended or revoked if any false information is supplied toward securing the permit/any unauthorized changes are made to the site/any unauthorized changes are made in the installation of the system. Improvement Permit with plat valid without expiration. Improvement Permit with site plan valid for sixty months. Authorization to Construct is valid for a period equal to that of Improvement Permit – not to exceed sixty months.

Signed: Ray Blankenship date 8-31-00

Improvement Permit by: Maria H Dobson RS date 8/31/00

Authorization to Construct by: date

Installed by:

Operation Permit by:

Existing System Inspection by: Maria H Dobson RS date 8/31/00

HEALTH DEPT. COPY: WHITE OWNER COPY (FINAL): YELLOW OWNER COPY (INITIAL): PINK