IREDELL COUNTY HEALTH DEPARTMENT

STATESVILLE 704-878-5305 MOORESVILLE 704-664-5281

IMPROVEMENT PERMIT / AUTHORIZATION TO CONSTRUCT / OPERATION PERMIT / EXISTING SYSTEM INSPECTI

PERMIT# 073507 PIN# 4649971086 DATE 6/3/98

OWNER OR CONTRACTOR PRUITT DEV. PHONE: Business Home 660-6 5900

ADDRESS 142 STUTTS RD. MOORESVILLE NC 28115

LOCATION 21/115 N- TL SAILWINDS ON RT

SUBDIVISION WINWARD PT BLOCK / SECTION LOT 94 LOT AREA 1.55AC SITE CLASS. PS DESIGN FLOW 360GPD T.A.R. .30-PO/FO2

Septic Tank: 1000 Gallons; STB 1012 TP Date 5-11-98
Pump Tank: Gallons; PT Date
Pump Make: Model Serial No.
Nitrification Field: No Fields 1 Square Feet 900 Linear Feet 300
No Lines 5C60' Trench Width 36" Max Trench Bottom Depth 26" Gravel Depth N/A

☑ New System ☐ Repair System Type: I, II, III, IV, V, VI
System Description: GRAVITY CHAMBERS OR EQUIV
Repair System Description: PUMP PANEL
Maintenance Agreement Required: ☐ Yes ☑ No


☐ House/Mod. Home ☑ Mobile Home ☐ Business ☐ Other
No. Bedrooms 3 No. Bathrooms 2 No. Employees
☐ Slab ☑ Crawl Space ☐ Basement w/plumbing ☐ Basement wo/plumbing

Water Supply: ☑ Individual ☐ Public ☐ Community


Comments:/Conditions:

Comments:/Conditions: TANK SET ON upper END to facilitate Gravity flow.

INITIAL SITE SKETCH 1"=50'

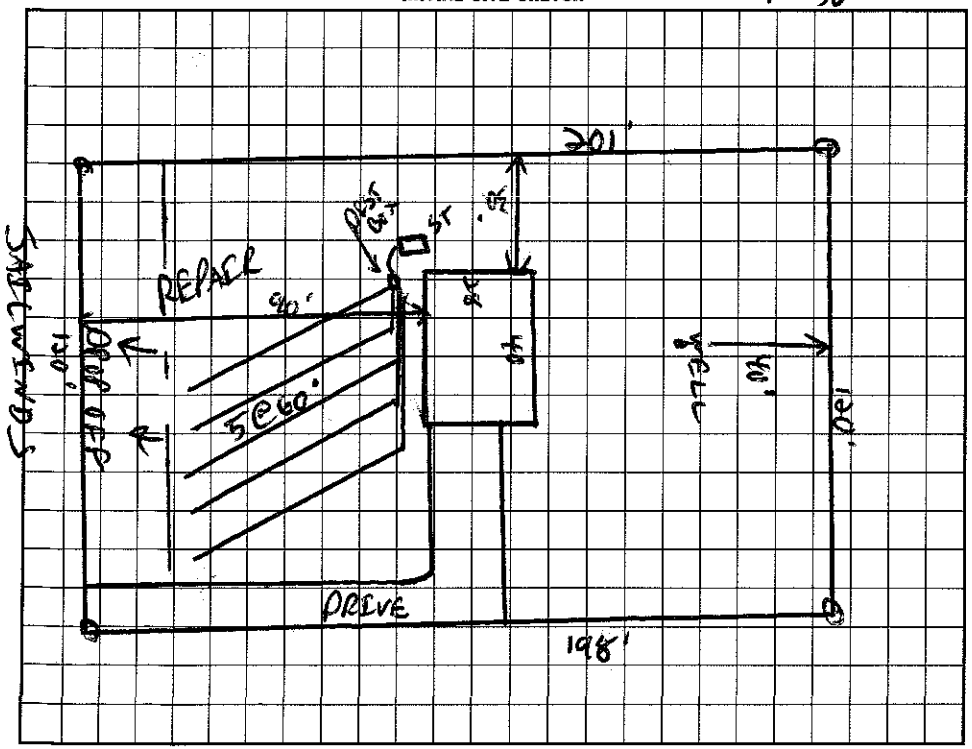

AS BUILT SKETCH

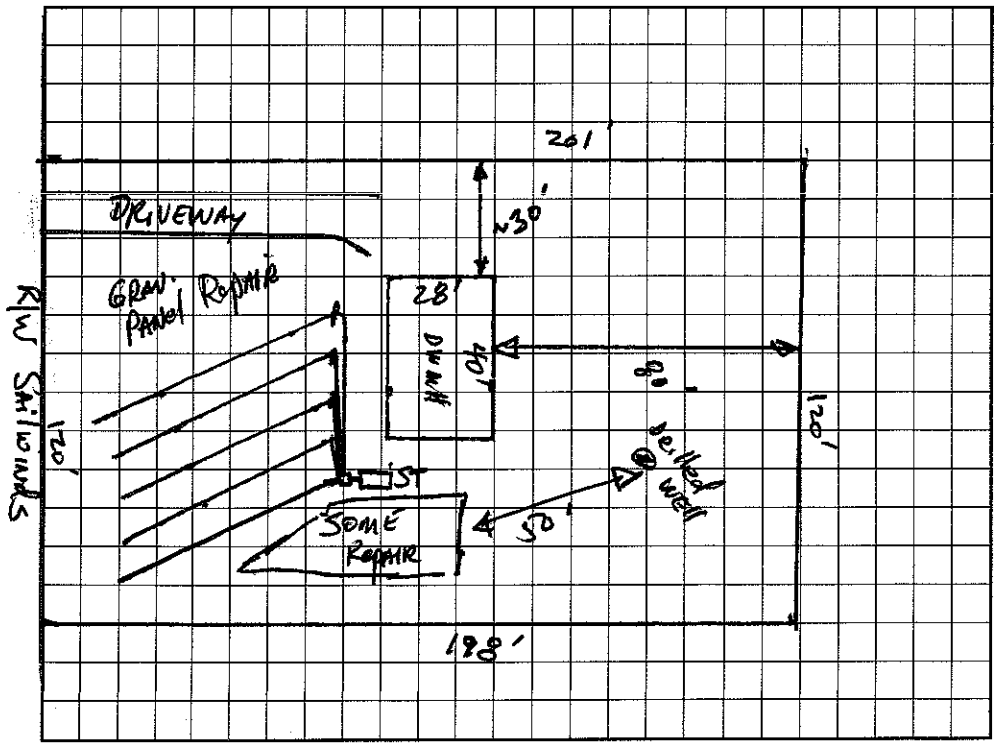

I understand that this permit can be suspended or revoked if any false information is supplied toward securing the permit/any unauthorized changes are made to the site/any unauthorized changes are made in the installation of the system. Improvement Permit with plat valid without expiration. Improvement Permit with site plan valid for sixty months. Authorization to Construct is valid for a period equal to that of Improvement Permit – not to exceed sixty months.

Signed: date

Improvement Permit by: C. Ray Thomas RS date 6/3/98

Authorization to Construct by: C. Ray Thomas RS date 6/3/98

Installed by: A-1 Backhoe

Operation Permit by: Daniel R. Thomas RS date 7-13-98

Existing System Inspection by: date

HEALTH DEPT. COPY: WHITE INSPECTION COPY (FINAL): GREEN OWNER COPY (FINAL): YELLOW INSPECTION COPY (INITIAL): PINK OWNER COPY (INITIAL): GOLD