IREDELL COUNTY HEALTH DEPARTMENT

STATESVILLE 704-878-5305 MOORESVILLE 704-664-5281

IMPROVEMENT PERMIT / AUTHORIZATION TO CONSTRUCT / OPERATION PERMIT / EXISTING SYSTEM INSPECTION

PERMIT# 074842 PIN# 4649972538 DATE 7/17/98

OWNER OR CONTRACTOR Jeffrey & Nicki Webster PHONE: Business — Home 528-5674

ADDRESS 227 Sorrel Lane Troutman NC 28166

LOCATION Flower house Loop Rankin Hill Rd Sorrel in Curve #227

SUBDIVISION Palomino Pk BLOCK / SECTION — LOT 43 LOT AREA .93Acre SITE CLASS. D5 DESIGN FLOW 360gpd T.A.R. Existing

Septic Tank: 1000 Gallons; STB — Date —

Pump Tank: 1000 Gallons; PT Existing Date —

Pump Make: — Model — Serial No. NG

Nitrification Field: No Fields — Square Feet — Linear Feet —

No Lines Existing Trench Width NG Max Trench Bottom Depth — Gravel Depth —

☐ New System ☐ Repair System Type: I, II, III, IV, V, VI

System Description: Pump to Conventional

Repair System Description: Existing

Maintenance Agreement Required: ☐ Yes ☐ No

☐ House/Mod. Home ☒ Mobile Home ☐ Business ☐ Other — No. Bedrooms 3 No. Bathrooms 2 No. Employees —


☐ Slab ☒ Crawl Space ☐ Basement w/plumbing ☐ Basement wo/plumbing

Water Supply: ☒ Individual ☐ Public ☐ Community

Comments:/Conditions: Existing Septic System appears to be functioning okay, NO problems Noticed ★ Keep Name MH at least 5' from Septic

Comments:/Conditions: Changing out MH for 3Bdrm MH; Septic System Originally sized for 3 Bedroom Originally installed 5/91

Not to Scale **INITIAL SITE SKETCH**

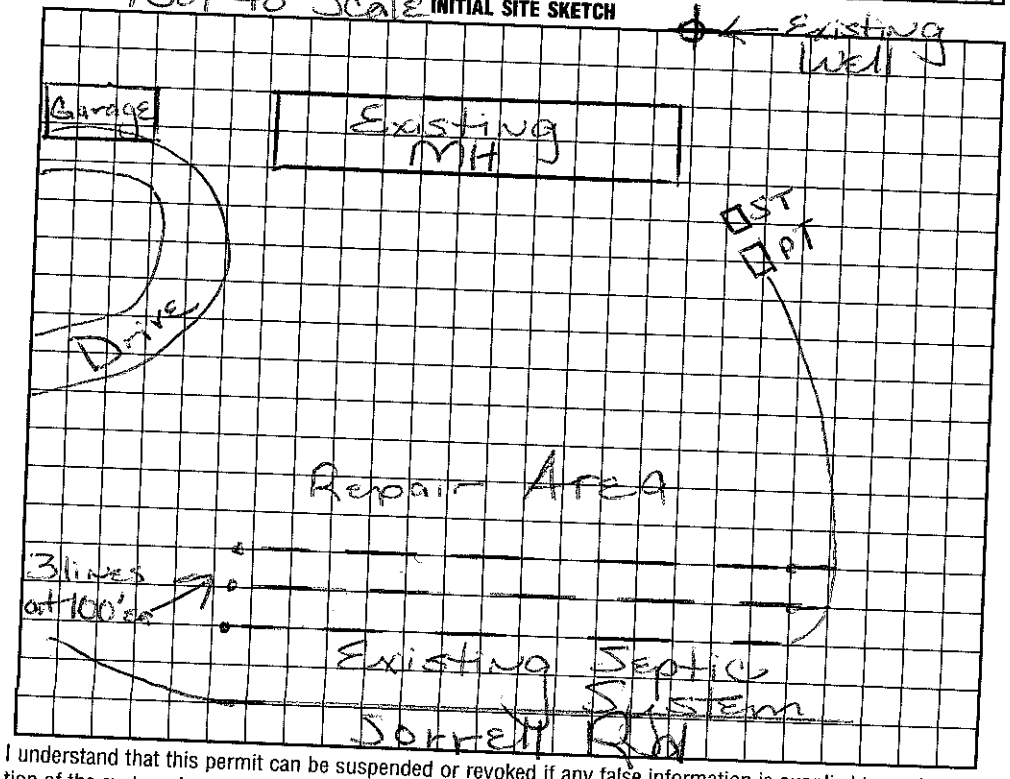

AS BUILT SKETCH

I understand that this permit can be suspended or revoked if any false information is supplied toward securing the permit/any unauthorized changes are made to the site/any unauthorized changes are made in the installation of the system. Improvement Permit with plat valid without expiration. Improvement Permit with site plan valid for sixty months. Authorization to Construct is valid for a period equal to that of Improvement Permit – not to exceed sixty months.

Signed: X Nicki Webster date

Improvement Permit by: Maria H Dolan date 7/17/98

Authorization to Construct by: Maria H Dolan date 7/17/98

Existing

Installed by: —

Operation Permit by: — date —

Existing System Inspection by: — date —

HEALTH DEPT. COPY: WHITE INSPECTION COPY (FINAL): GREEN OWNER COPY (FINAL): YELLOW INSPECTION COPY (INITIAL): PINK OWNER COPY (INITIAL): GOLD