IREDELL COUNTY HEALTH DEPARTMENT

AUTHORIZATION TO CONSTRUCT (9/30)

STATESVILLE 704-878-5305 MOORESVILLE 704-664-5281

IMPROVEMENT PERMIT / ~~CERTIFICATE OF COMPLETION~~ / OPERATION PERMIT / EXISTING SYSTEM INSPECTION

PROPERTY DESCRIPTION NO. 25965 DATE 4/29/97 TAX MAP NO. 4649972828 Watershed: ☐ Yes ☑ No

OWNER OR CONTRACTOR OLDE TOWNE MOBILE HOMES PHONE: Business _____ Home 873-1451

ADDRESS 2016 NORTHSIDE DR STATESVILLE

LOCATION 21 N - TL FLOWER HOUSE - TL RANKIN HILL RD - TL THOROUGHBRED (PALOMINO PARK) - TL SORREL LN - NEAR END ONLY

SUBDIVISION PALOMINO PARK BLOCK / SECTION _____ LOT 41 LOT AREA - SITE CLASS. PS DESIGN FLOW 240 GPD L.T.A.R. 130 GPD/FT

Septic Tank: 1000 Gallons; STB 1012 Date 4/25/97
Pump Tank: 1000 Gallons; PT 17 Date 7/13/97
Pump Make: GOULDS Model WE0712H Serial No. _____
Nitrification Field: No Fields 1 Square Feet 801 Linear Feet 267
No Lines 4@67 Trench Width 36" Max Trench Bottom Depth 24" Gravel Depth 12"

☑ New System ☐ Repair System Type: I, II, (III), IV, V, VI
System Description: PUMP CONVENTIONAL
Repair System Description: PUMP CHAMBERED
Maintenance Agreement Required: ☐ Yes ☑ No

☐ House/Mod. Home ☑ Mobile Home ☐ Business ☐ Other
No. Bedrooms 2 No. Bathrooms 2 No. Employees ____


☐ Slab ☑ Crawl Space ☐ Basement w/plumbing ☐ Basement wo/plumbing

Water Supply: ☑ Individual ☐ Community ☐ Public


Comments: SEE HEALTH DEPARTMENT BEFORE INSTALLATION TO DETERMINE EXACTLY WHERE TO INSTALL SYSTEM. *

Comments: Drainfield, Tanks,

INITIAL SITE SKETCH

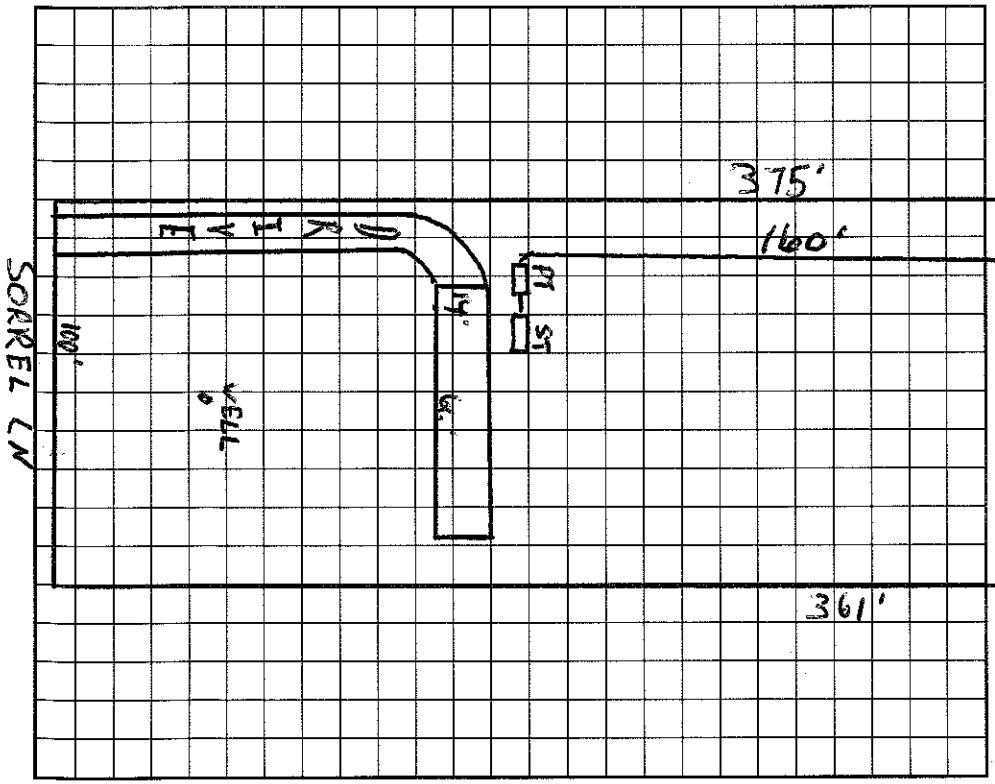

AS BUILT SKETCH

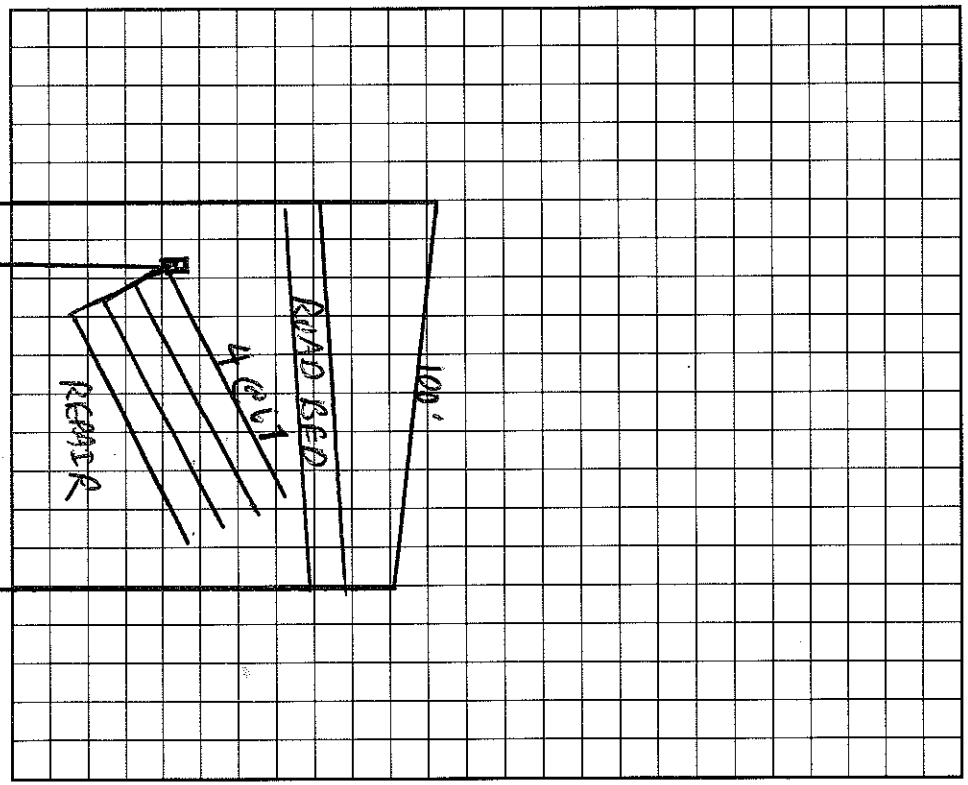

I understand that this permit can be suspended or revoked if any false information is supplied toward securing the permit/any unauthorized changes are made to the site/any unauthorized changes are made in the installation of the system. Improvement Permit is valid for 60 months from date of issuance.

Signed: E. N. Hall

Improvement Permit by: C. [illegible] date 4-29-97

AUTHORIZATION TO CONSTRUCT Existing System Inspection by: C. [illegible] date 4/29/97

Installed by: Donald Lackey

Certificate of Completion by: Wesley Sparks RS date 9/29/97

Operation Permit by: Wesley Sparks RS date 9/29/97

HEALTH DEPT. COPY: WHITE INSPECTION COPY (FINAL): GREEN OWNER COPY (FINAL): YELLOW INSPECTION COPY (INITIAL): PINK OWNER COPY (INITIAL): GOLD