IREDELL COUNTY HEALTH DEPARTMENT

STATESVILLE 704-878-5305 MOORESVILLE 704-664-5281

IMPROVEMENT PERMIT / AUTHORIZATION TO CONSTRUCT / OPERATION PERMIT / EXISTING SYSTEM INSPECTION

PERMIT# 073505 PIN# 4649974121 DATE 6/3/98

OWNER OR CONTRACTOR PRUITT DEV. PHONE: Business Home 660-5900

ADDRESS 142 STUTTS RD - MOORESVILLE NC 28115

LOCATION 21/115N - TL SAILWINDS - ON RT

SUBDIVISION WINWARD PT. BLOCK / SECTION 2 LOT 92 LOT AREA .53AC SITE CLASS. PS DESIGN FLOW 360GAD L.T.A.R. .30APD/FT

Septic Tank: 1000 Gallons; STB 1012 Date 5/8/98

Pump Tank: Gallons; PT Date

Pump Make: Model Serial No.

Nitrification Field: No Fields 1 Square Feet 900 Linear Feet 300

No Lines 5@60' Trench Width 36" Max Trench Bottom Depth 36" Gravel Depth N/A

☑ New System ☐ Repair System Type: I, II, (III), IV, V, VI

System Description: GRAVITY CHAMBERS OR HDS

Repair System Description: GRAVITY/PUMP PANEL

Maintenance Agreement Required: ☐ Yes ☑ No

☐ House/Mod. Home No. Bedrooms 3

☑ Mobile Home No. Bathrooms 2

☐ Business No. Employees

☐ Other


☐ Slab ☑ Crawl Space ☐ Basement w/plumbing ☐ Basement wo/plumbing

Water Supply: ☑ Individual ☐ Public ☐ Community

Comments:/Conditions:

Comments:/Conditions:

INITIAL SITE SKETCH 1"=50'

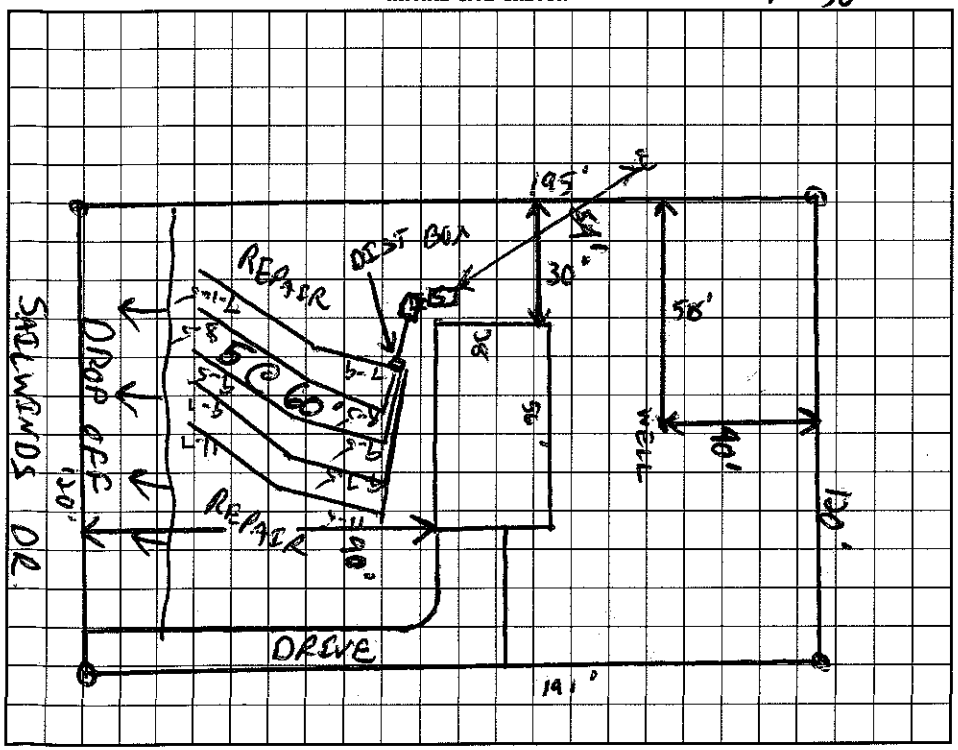

AS BUILT SKETCH

I understand that this permit can be suspended or revoked if any false information is supplied toward securing the permit/any unauthorized changes are made to the site/any unauthorized changes are made in the installation of the system. Improvement Permit with plat valid without expiration. Improvement Permit with site plan valid for sixty months. Authorization to Construct is valid for a period equal to that of Improvement Permit – not to exceed sixty months.

Signed: date

Improvement Permit by: C. Rhyne RS date 6/3/98

Authorization to Construct by: C. Rhyne RS date 6/3/98

Installed by: A-1 Backhoe

Operation Permit by: Wesley Sparks RS date 7/14/98

Existing System Inspection by: Wesley Sparks RS date 7/14/98

HEALTH DEPT. COPY: WHITE INSPECTION COPY (FINAL): GREEN OWNER COPY (FINAL): YELLOW INSPECTION COPY (INITIAL): PINK OWNER COPY (INITIAL): GOLD