1.30

IREDELL COUNTY HEALTH DEPARTMENT

STATESVILLE 704-878-5305 MOORESVILLE 704-664-5281

IMPROVEMENT PERMIT / AUTHORIZATION TO CONSTRUCT / OPERATION PERMIT / EXISTING SYSTEM INSPECTION

PERMIT# 074073 PIN# 4649 97 5143 DATE 7/13/98

OWNER OR CONTRACTOR Pruitt Dev. Co. PHONE: Business 660-5900 Home

ADDRESS 142 Stutts Rd. Mooresville, NC. 28115

LOCATION 115N, Tk Sailwinds Road, 2ND on (R) past Tradewinds Court

SUBDIVISION Winward Pointe BLOCK / SECTION 11 LOT 91 LOT AREA .52 Ac SITE CLASS. PS DESIGN FLOW 360 L.T.A.R. .3

Septic Tank: 1000 Gallons; STB 1012 Date 5/14/98
Pump Tank: 1000 Gallons; PT 825 Date 12/25/97
Pump Make: Model Serial No.
Nitrification Field: No Fields 1 Square Feet 900 Linear Feet 360
No Lines 4 Trench Width 36" Max Trench Bottom Depth 30" Gravel Depth SAND

[X] New System [ ] Repair System Type: I, II, (III) IV, V, VI
System Description: PressMan — CH. PLASTIC
Repair System Description: Pressure PVC
Maintenance Agreement Required: [ ] Yes [X] No


[ ] House/Mod. Home No. Bedrooms 3
[X] Mobile Home No. Bathrooms 2
[ ] Business No. Employees
[ ] Other
[ ] Slab [ ] Crawl Space [ ] Basement w/plumbing [ ] Basement wo/plumbing

Water Supply: [X] Individual [ ] Public [ ] Community

Comments:/Conditions: * 25% reduction for Ch Plastic on A.D.S. use

Comments:/Conditions:

INITIAL SITE SKETCH

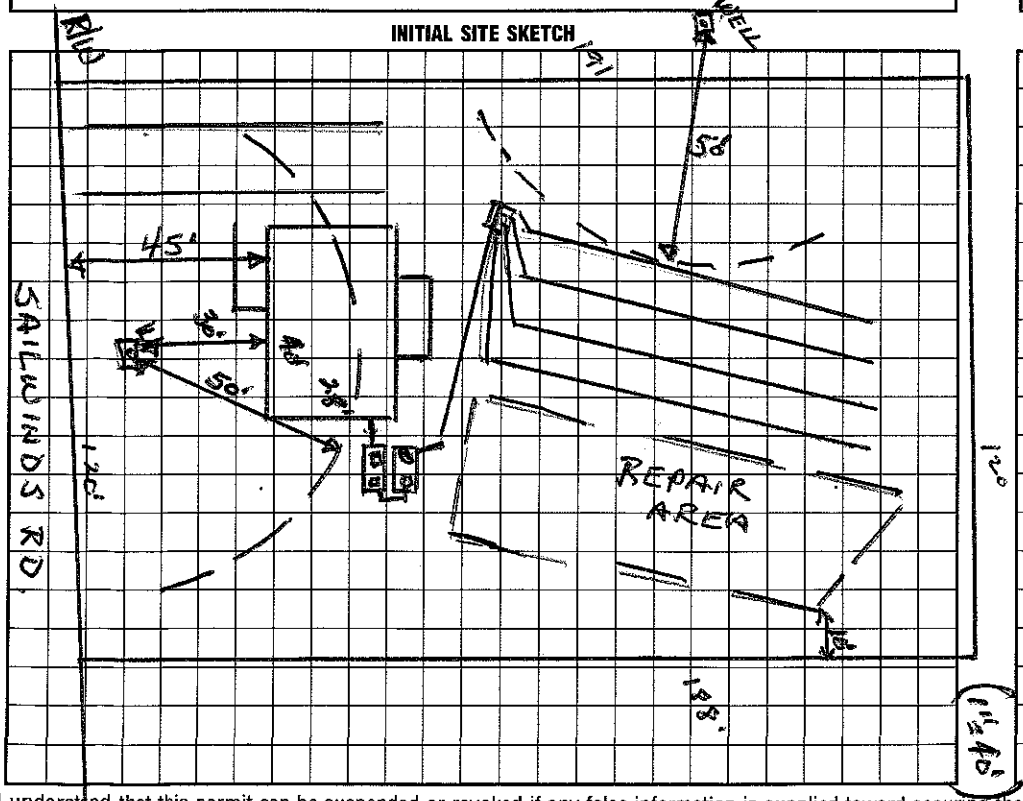

AS BUILT SKETCH

I understand that this permit can be suspended or revoked if any false information is supplied toward securing the permit/any unauthorized changes are made to the site/any unauthorized changes are made in the installation of the system. Improvement Permit with plat valid without expiration. Improvement Permit with site plan valid for sixty months. Authorization to Construct is valid for a period equal to that of Improvement Permit – not to exceed sixty months.

Signed: X date

Improvement Permit by: Wesley Sparks RS. date 7/13/98

Authorization to Construct by: Wesley Sparks RS. date 7/13/98

Installed by: A-1 B/A & Assoc

Operation Permit by: date 8/18/98

Existing System Inspection by: date

HEALTH DEPT. COPY: WHITE INSPECTION COPY (FINAL): GREEN OWNER COPY (FINAL): YELLOW INSPECTION COPY (INITIAL): PINK OWNER COPY (INITIAL): GOLD