IREDELL COUNTY HEALTH DEPARTMENT

STATESVILLE 704-878-5305 MOORESVILLE 704-634-5281

IMPROVEMENT PERMIT / AUTHORIZATION TO CONSTRUCT / OPERATION PERMIT / EXISTING SYSTEM INSPECTION

PERMIT# 87500 PIN# 4649975774

OWNER OR CONTRACTOR WEBB CLIFFORD - CliffordWebb PHONE: Business _____ Home _____ DATE 1/28/00

ADDRESS 240 SORREL LN TROUTMAN NC 28166

LOCATION FLOWER HOUSE - TL RANKEN HILL - TL THOUROUGHBRED - TL SORREL - ON RT NEAR END

SUBDIVISION PALOMINO PARK BLOCK / SECTION _____ LOT 28 LOT AREA _____ SITE CLASS. PS DESIGN FLOW 360 L.T.A.R. .3

Septic Tank: EXISTING Gallons; STB _____ Date _____

Pump Tank: _____ Gallons; PT _____ Date _____

Pump Make: _____ Model _____ Serial No. _____

Nitrification Field: No Fields 1 Square Feet 480 Linear Feet 160

No Lines 2@80' Trench Width 36" Max Trench Bottom Depth 36" Gravel Depth 12"

☑ New System ☐ Repair System Type: I (II) III, IV, V, VI

System Description: CONVENTIONAL

Repair System Description: STUB

Maintenance Agreement Required: ☐ Yes ☑ No

☐ House/Mod. Home ☑ Mobile Home ☐ Business ☐ Other

No. Bedrooms 3 No. Bathrooms 2 No. Employees ____


☐ Slab ☐ Crawl Space ☐ Basement w/plumbing ☐ Basement wo/plumbing

Water Supply: ~~Individual~~ ☐ Public ☐ Community

Comments:/Conditions:

Comments:/Conditions:

INITIAL SITE SKETCH

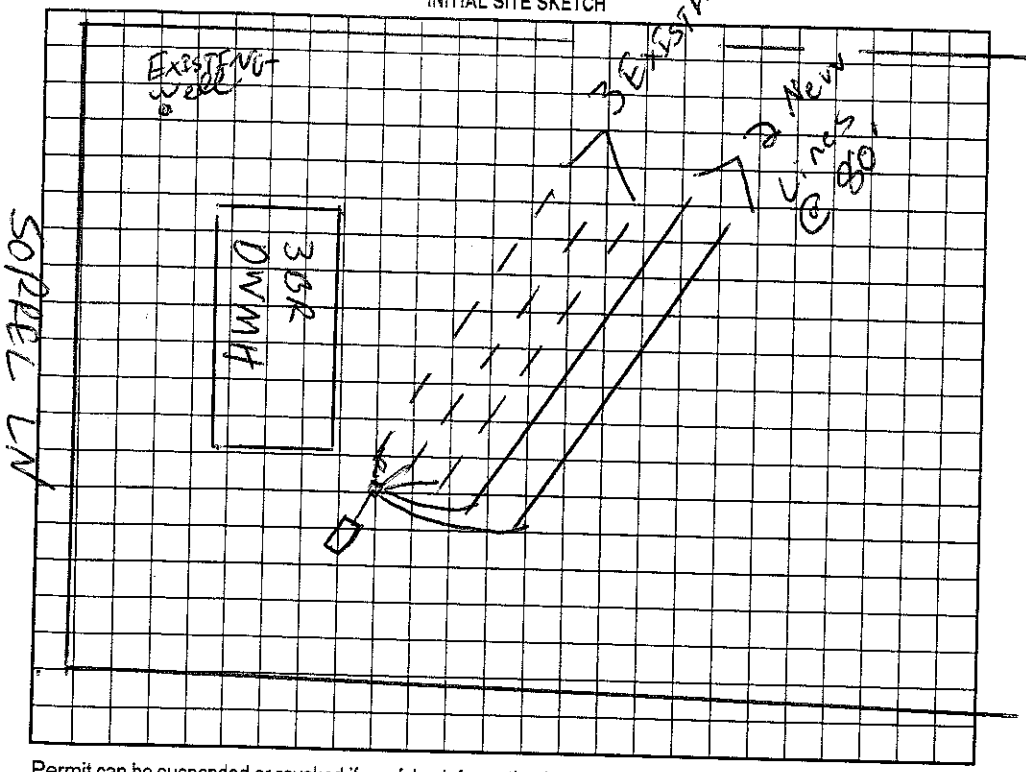

AS BUILT SKETCH

Permit can be suspended or revoked if any false information is supplied toward securing the permit/any unauthorized changes are made to the site/any unauthorized changes are made in the installation of the system. Improvement Permit with plat valid without expiration. Improvement Permit with site plan valid for sixty months. Authorization to Construct is valid for a period equal to that of Improvement Permit – not to exceed sixty months.

Signed: Rose Webb date 2-3-2000 Installed by: Richard Abernathy

Improvement Permit by: C. [signature] date 1/26/00 Operation Permit by: Wesley Sparks RS date 2/11/00

Authorization to Construct by: C [signature] RS date 1/25/00 Existing System Inspection by: _____ date _____

HEALTH DEPT. COPY: WHITE OWNER COPY (FINAL): YELLOW OWNER COPY (INITIAL): PINK