IREDELL COUNTY HEALTH DEPARTMENT

STATESVILLE 704-878-5305 MOORESVILLE 704-664-3281

IMPROVEMENT PERMIT / AUTHORIZATION TO CONSTRUCT / OPERATION PERMIT / EXISTING SYSTEM INSPEC

PERMIT# 089197 PIN# 4649 97 5866. DATE 5/1..

OWNER OR CONTRACTOR Robert Player PHONE: Business _____ Home 662-8436

ADDRESS 250 Sorrell Lane Trentman, NC. 28166

LOCATION Sorrell near end on (R)

SUBDIVISION Pokinino Park BLOCK / SECTION _____ LOT 29 LOT AREA .64 SITE CLASS. P5 DESIGN FLOW 360 L.T.A.R. .25

Septic Tank: 1000 Gallons: STB 1012 Date 6/60

Pump Tank: _____ Gallons; PT _____ Date _____

Pump Make: _____ Model _____ Serial No. _____

Nitrification Field: No Fields 1 Square Feet 1440 Linear Feet 480

No Lines 6 Trench Width 36" Max Trench Bottom Depth 36" Gravel Depth 12"

(X) New System ☐ Repair System Type: I (II) III, IV, V, VI

System Description: Low-Conventional

Repair System Description: None

Maintenance Agreement Required: ☐ Yes (X) No

☐ House/Mod. Home No. Bedrooms 3

(X) Mobile Home No. Bathrooms 3

☐ Business No. Employees _____

☐ Other _____


☐ Slab (X) Crawl Space ☐ Basement w/plumbing ☐ Basement wo/plumbing

Water Supply: (X) Individual ☐ Public ☐ Community


Comments:/Conditions:

Comments:/Conditions:

INITIAL SITE SKETCH

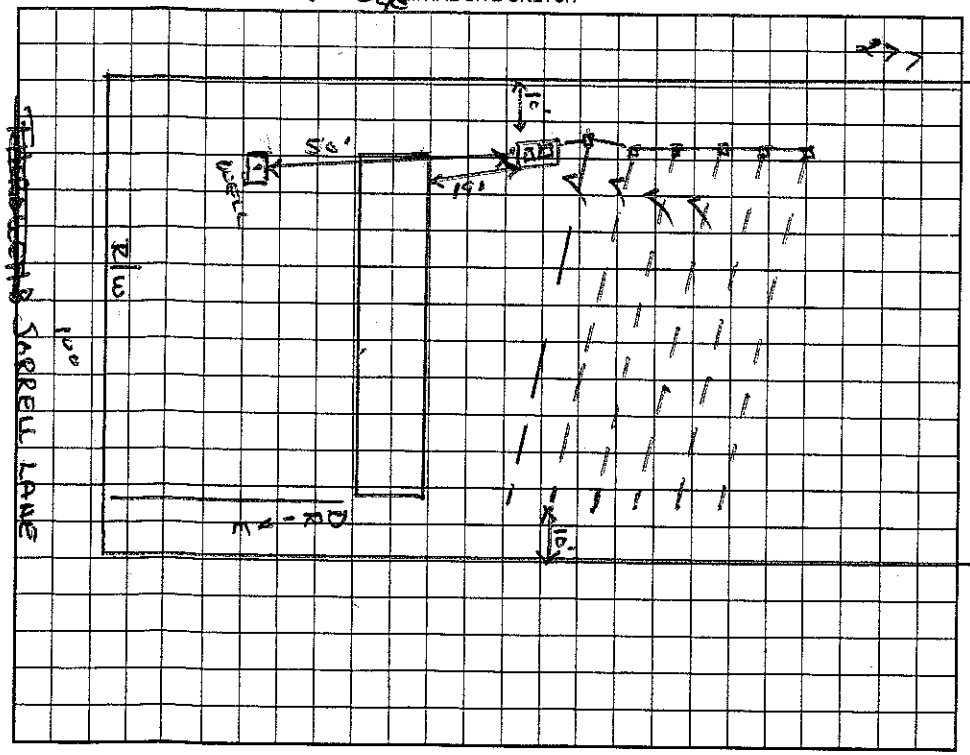

AS BUILT SKETCH

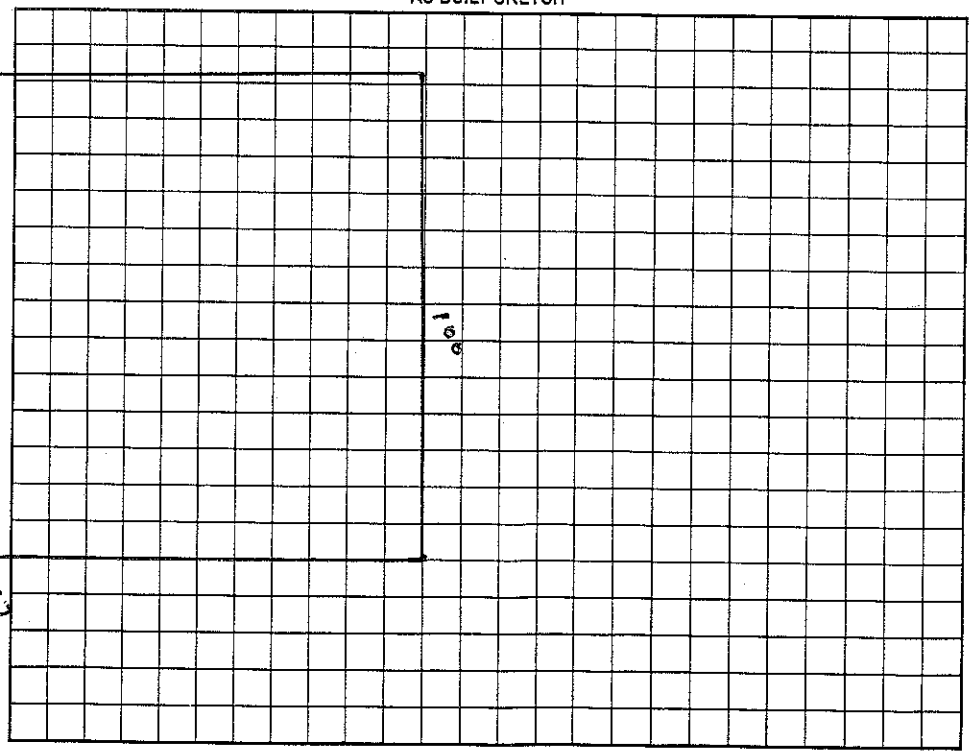

Permit can be suspended or revoked if any false information is supplied toward securing the permit/any unauthorized changes are made to the site/any unauthorized changes are made in the installation of the system. Improvement Permit with plat valid without expiration. Improvement Permit with site plan valid for sixty months. Authorization to Construct is valid for a period equal to that of Improvement Permit – not to exceed sixty months.

Signed: X _____ date _____

Improvement Permit by: Wesley Sparks RS. date 5/10/00

Authorization to Construct by: Wesley Sparks RS. date 5/10/00

Installed by: Forest Stanford

Operation Permit by: Wesley Sparks RS. date 6/13/00

Existing System Inspection by: _____ date _____

HEALTH DEPT. COPY: WHITE OWNER COPY (FINAL): YELLOW OWNER COPY (INITIAL): PINK