IREDELL COUNTY HEALTH DEPARTMENT

AUTHORIZATION TO CONSTRUCTION 11:00

STATESVILLE 704-878-5305 MOORESVILLE 704-664-5281

IMPROVEMENT PERMIT / ~~CERTIFICATE OF COMPLETION~~ / OPERATION PERMIT / EXISTING SYSTEM INSPECTION

PROPERTY DESCRIPTION NO. 24866 DATE 6/2/97 TAX MAP NO. 4E A 12 Watershed: ☑ ~~Yes~~ ☐ No

OWNER OR CONTRACTOR PRUETT DEVELOPMENT PHONE: Business 4049979285 Home

ADDRESS 240 LAKEVIEW DR. MOORESVILLE

LOCATION 21 S ~ TL SAILWINDS - 17th LOT ON RT

SUBDIVISION WINDWARD PT BLOCK / SECTION LOT 17 LOT AREA 21780 SITE CLASS. RS DESIGN FLOW 360 L.T.A.R. .3 gpd/ft²

Septic Tank: 1000 Gallons; STB 821 Date 5/16/97

Pump Tank: Gallons; PT Date

Pump Make: Model Serial No.

Nitrification Field: No Fields 1 Square Feet ~~900~~ 900 Linear Feet 300

No Lines ~~4~~ 3 Trench Width 36" Max Trench Bottom Depth 36" Gravel Depth N/A

☑ New System ☐ Repair System Type: I, II, III, IV, V, VI

System Description: GRAVITY CHAMBERED OR PANEL SYSTEM

Repair System Description:

Maintenance Agreement Required: ☐ Yes ☑ No

☐ House/Mod. Home ☑ Mobile Home ☐ Business ☐ Other

No. Bedrooms 3 No. Bathrooms 2 No. Employees


☐ Slab ☑ Crawl Space ☐ Basement w/plumbing ☐ Basement wo/plumbing

Water Supply: ☑ Individual ☐ Community ☐ Public

Comments:

Comments:

INITIAL SITE SKETCH 1"=40'

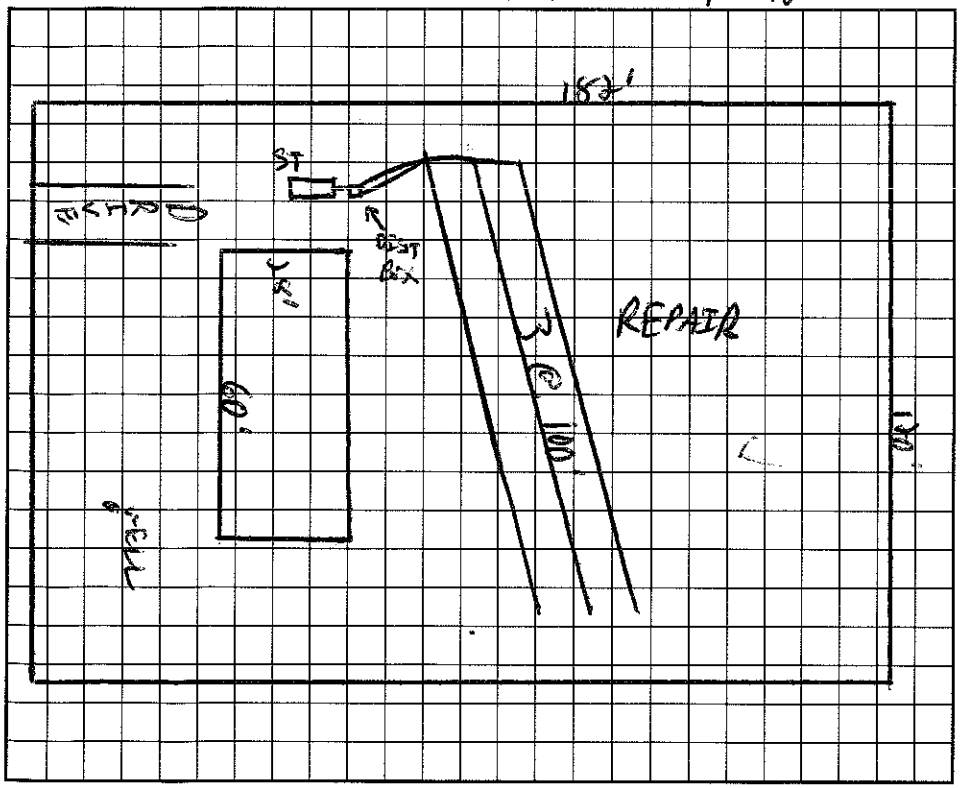

AS BUILT SKETCH

Same as Site Sketch

I understand that this permit can be suspended or revoked if any false information is supplied toward securing the permit/any unauthorized changes are made to the site/any unauthorized changes are made in the installation of the system. Improvement Permit is valid for ~~60~~ months from date of issuance.

Signed:

Improvement Permit by: C. Ray Thomas date 6/2/97

~~Existing System Inspection by:~~ AUTHORIZATION TO CONSTRUCT C. Ray Thomas date 6/2/97

Installed by: G & M ENTERPRISES

Certificate of Completion by: date

Operation Permit by: C. Ray Thomas date 6/27/97

HEALTH DEPT. COPY: WHITE INSPECTION COPY (FINAL): GREEN OWNER COPY (FINAL): YELLOW INSPECTION COPY (INITIAL): PINK OWNER COPY (INITIAL): GOLD