IREDELL COUNTY HEALTH DEPARTMENT

STATESVILLE 704-878-5305 MOORESVILLE 704-664-5281

IMPROVEMENT PERMIT / CERTIFICATE OF COMPLETION / OPERATION PERMIT / EXISTING SYSTEM INSPECTION

PROPERTY DESCRIPTION NO. 15965 DATE 8/11/93

OWNER OR CONTRACTOR Jonathan Jourdan PHONE: Business 4649-98-2047 TAX MAP NO. 4E 3A 39

ADDRESS Home 594-1480

LOCATION Palomino Park

SUBDIVISION Palomino Park BLOCK / SECTION LOT 39 LOT AREA 101'x338' SITE CLASS. P L.T.A.R. (.25-.3)

Water Supply: ☑ Individual ☐ Community ☐ Public NOT DRILLED

Septic Tank: 1000 Gallons; STB 782 Date 6-16-93

Pump Tank: Gallons; PT Date

Nitrification Field: No Fields 1 Square Feet 1200 Linear Feet 400

No Lines 3 Trench Width 36" Trench Depth 36" Gravel Depth 12"

☑ New System ☐ Repair System Type: ☑ II, IV, V, VI

System Description: CONV - GRAVITY

Repair System Description:

Maintenance Agreement Required: ☐ Yes ☐ No

☑ House/Mod. Home No. Bedrooms 3

☐ Mobile Home No. Bathrooms 2

☐ Business No. Employees

☐ Other

☐ Slab ☑ Crawl Space ☐ Basement w/plumbing

Garbage Disposal: ☐ Yes ☑ No

Auto. Dishwasher: ☑ Yes ☐ No

Auto. Washing Machine: ☑ Yes ☐ No


Other

☐ Basement wo/plumbing

Comments

INITIAL SITE SKETCH

AS BUILT SKETCH

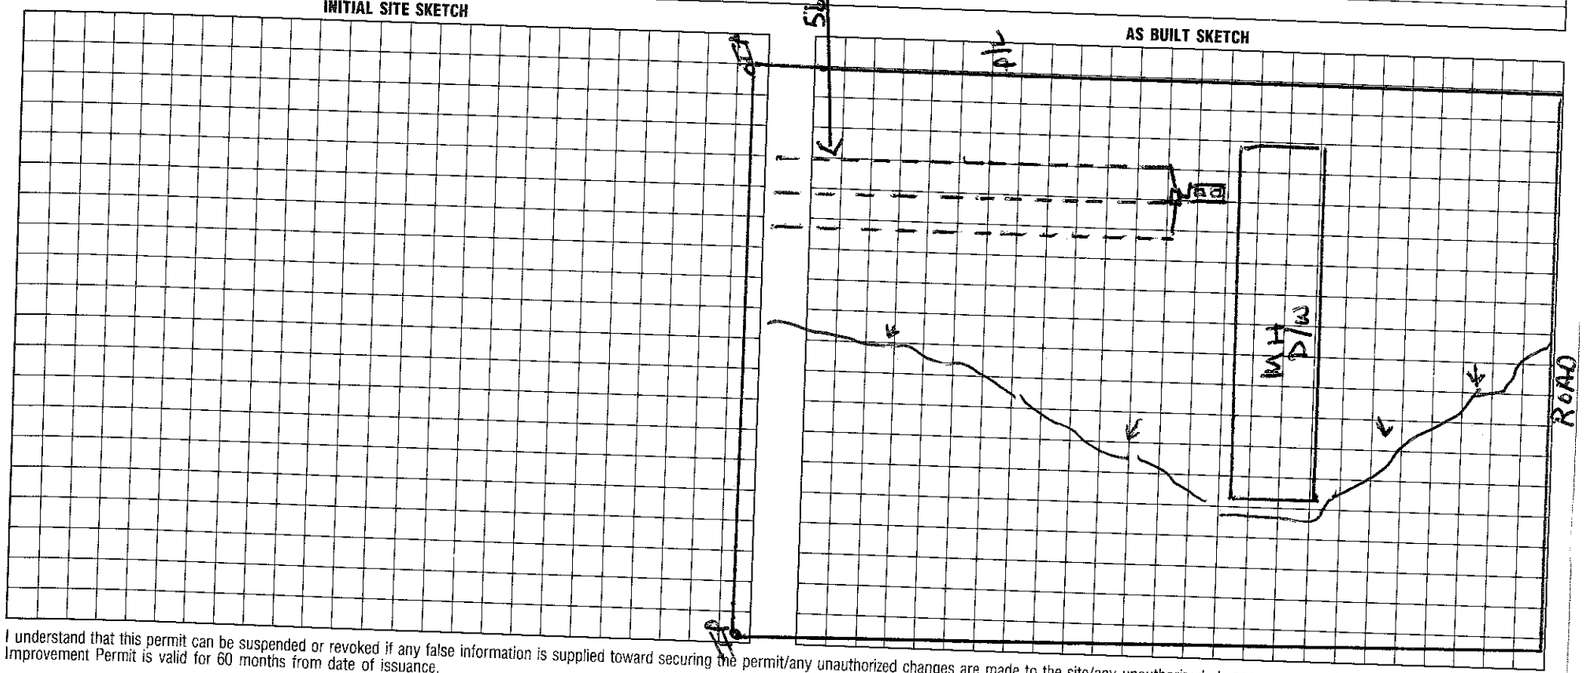

I understand that this permit can be suspended or revoked if any false information is supplied toward securing the permit/any unauthorized changes are made to the site/any unauthorized changes are made in the installation of the system. Improvement Permit is valid for 60 months from date of issuance.

Signed:

Improvement Permit by: date

Existing System Inspection by: date

Installed by: Dennis Dalliege

Certificate of Completion by: Wesley Sparks R.S. date 8/11/93

Operation Permit by: date

HEALTH DEPT. COPY: WHITE INSPECTION COPY (FINAL): GREEN OWNER COPY (FINAL): YELLOW INSPECTION COPY (INITIAL): PINK OWNER COPY (INITIAL): GOLD

15965

IREDELL COUNTY HEALTH DEPARTMENT

IMPROVEMENT PERMIT AND CERTIFICATE OF COMPLETION / OPERATIONS PERMIT

OWNER OR CONTRACTOR Jonathen Jourdan DATE 4/21/93 PERMIT NO. 4E-3-A-39

PHONE: Business _____ Home 594-1480

LOCATION Palomino Park - near section on ⓛ 3rd lot before cul de sac

SUBDIVISION NAME Palomino Park LOT NO. 39 SECTION OR BLOCK NO. _____ S.R. No. _____

House ☐ Mobile Home ☑ Business ☐ Other _____

No. Bedrooms 3 No. Bathrooms 2

Garbage Disposal Unit Yes ☐ No ☑

Auto. Dishwasher Yes ☑ No ☐

Auto. Wash. Machine Yes ☑ No ☐

Lot Area ~20,000 FT2

Soil Characteristics P - 5; C / 5;


Application Rate P - .25 - .3 (wslr, 55)

Topography P - Colo

Depth to Water Table 5 - 74"

Rock or other impervious formations 5 - None obsvd

_____ Basement with Plumbing _____ Basement without Plumbing _____ No Basement ✓ Crawl Space

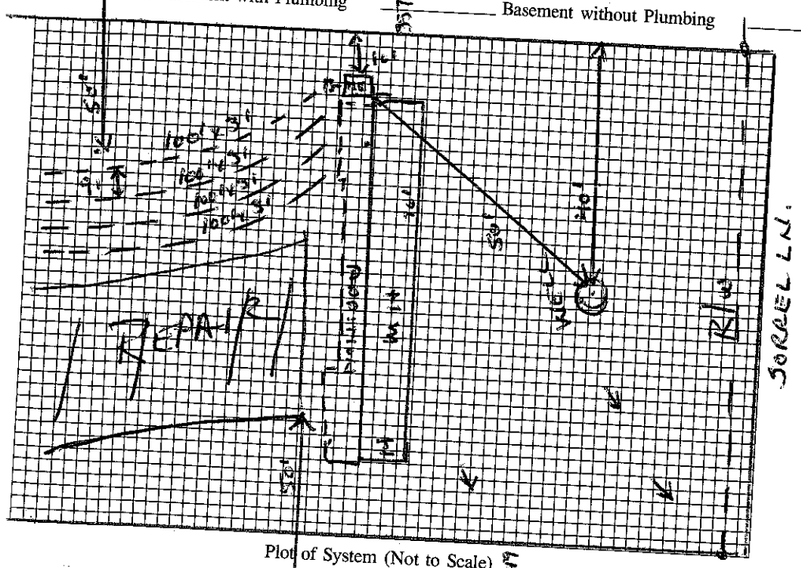

Plot of System (Not to Scale)

Size of Tank 1000 Gals.

Nitrification Field:

No. of Lines 4 @ 100' x 3'

Sq. Ft. 1200 Linear Ft. 400

Depth of Stone in Lines 12"

Water Supply: Individual ☑ Not Drilled Public ☐

Installed by _____

I understand and agree to install a septic tank system as specified on this Improvement Permit.

Signed: Shawn Landon

(IMPROVEMENT PERMIT IS VALID FOR 60 MONTHS FROM DATE OF ISSUE.)

IMPROVEMENT PERMIT BY Wesley Sparks R.S.

COMMENTS Keep trenches shallow, no deeper than 36" to trench bottom. No heavy grading in drainfield area

CERTIFICATE OF COMPLETION BY _____ DATE _____

EXISTING SYSTEM CHECKED BY _____ DATE _____

CONSTRUCTION MUST COMPLY WITH ALL OTHER APPLICABLE STATE AND LOCAL REGULATIONS

Permit is VOID if any unauthorized changes are made in installation of system, and/or if any unapproved changes are made to the site, and/or if any false information is supplied toward securing Improvement Permit.

Health Dept. Copy: White Inspection Dept. Copy: Yellow Sanitarian's Copy: Pink Owner's Copy: Gold