IREDELL COUNTY HEALTH DEPARTMENT

STATESVILLE 704-878-5305 MOORESVILLE 704-664-5281

IMPROVEMENT PERMIT / CERTIFICATE OF COMPLETION / OPERATION PERMIT / EXISTING SYSTEM INSPECTION

PROPERTY DESCRIPTION NO. 22455 DATE Dec 5, '95 TAX MAP NO. 4638 32

OWNER OR CONTRACTOR Jerry Hawkins Jr. ~~PHONE: Business~~ 4649-98-5196 Home Watershed: ☐ Yes ☐ No

ADDRESS 157 Circle Lynn Dr. Mooresville

LOCATION 115-21N TL Flower House Loop TL Rankin Hill Rd. TL Thoroughbred Dr. TL Sorrell Dr. on Right near end

SUBDIVISION Palomino Park BLOCK / SECTION LOT 32 LOT AREA 27,800 ft² SITE CLASS. PS DESIGN FLOW 360gpd L.T.A.R. .3

Septic Tank: 1000 Gallons; STB 521 Date 12-5-95

Pump Tank: Gallons; PT Date

Pump Make: Model Serial No.

Nitrification Field: No Fields 1 Square Feet 1200 Linear Feet 400

No Lines 4@100' Trench Width 36" Max Trench Bottom Depth ±24" Gravel Depth 12"

☑ New System ☐ Repair System Type: I, II, III, IV, V, VI

System Description: gravity conventional

Repair System Description: same

Maintenance Agreement Required: ☐ Yes ☑ No

☑ House/Mod. Home No. Bedrooms 3

☐ Mobile Home No. Bathrooms 2

☐ Business No. Employees

☐ Other


☐ Slab ☑ Crawl Space ☐ Basement w/plumbing ☐ Basement wo/plumbing

Water Supply: ☑ Individual ☐ Community ☐ Public


Comments: Follow contour as shown

Comments: was staked as shown on permit.

INITIAL SITE SKETCH

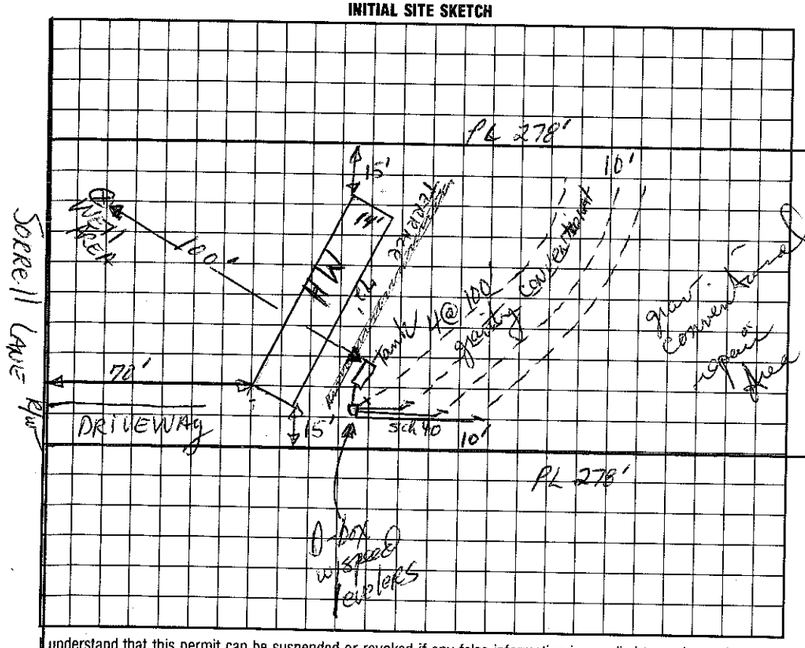

AS BUILT SKETCH

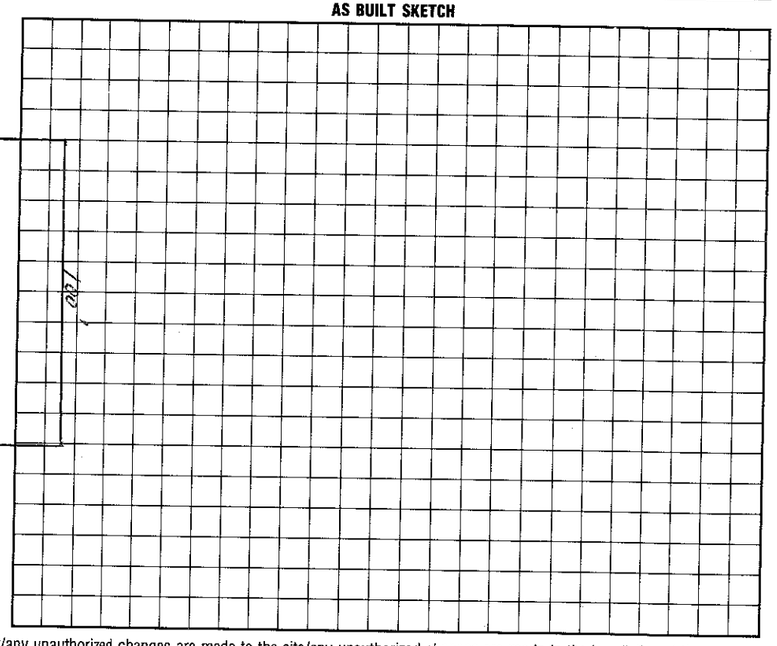

I understand that this permit can be suspended or revoked if any false information is supplied toward securing the permit/any unauthorized changes are made to the site/any unauthorized changes are made in the installation of the system.

Signed: Franklin W Hawkins pictured Hawkins

Improvement Permit by: Authorization to construct Jerry Patterson, RS date 12-5-95

~~Existing System Inspection by:~~ Jerry Patterson, RS date 12-5-95

Installed by: Miller Const. Co.

Certificate of Completion by: date

Operation Permit by: Wesley Sparkes date 11/30/96

HEALTH DEPT. COPY: WHITE INSPECTION COPY (FINAL): GREEN OWNER COPY (FINAL): YELLOW INSPECTION COPY (INITIAL): PINK OWNER COPY (INITIAL): GOLD