IREDELL COUNTY HEALTH DEPARTMENT

STATESVILLE 704-878-5305 315.00 Paid MOORESVILLE 704-664-5281

IMPROVEMENT PERMIT / AUTHORIZATION TO CONSTRUCT / OPERATION PERMIT / EXISTING SYSTEM INSPECTION

PERMIT# 11887J PIN# ~~4644-99-7447~~ 5409110 DATE 4/30/04

OWNER OR CONTRACTOR BURKE BUILDERS PHONE: Business 361-0047 Home

ADDRESS PO BOX 3481 MOORESVILLE NC 28115

LOCATION 115(S) - TR BRIDGES FARM - TR CLOVER BANK RD - ON LT

SUBDIVISION ESTATES BLOCK / SECTION LOT 2 LOT AREA .58Ac SITE CLASS A5 DESIGN FLOW 360GPD L.T.A.R. .36 EAPT/FT2

Septic Tank: 1000 Gallons; STB 794 Date 4/17/05 ☑ New System ☐ Repair System Type: I, II, III, (IV) V, VI

Pump Tank: 1000 Gallons; PT 283 Date 7/23/06 System Description: LP PANEL

Pump Make: Goulds Model PE 5T Serial No. Repair System Description: SAME

Nitrification Field: No Fields 1 Square Feet 420 Linear Feet 210 Maintenance Agreement Required: ☑ Yes ☐ No

No Lines 3@70' Trench Width 24" Max Trench Bottom Depth 36" Gravel Depth N/A ☐ Slab ☑ Crawl Space ☐ Basement w/plumbing ☐ Basement wo/plumbing

☑ House/Mod. Home No. Bedrooms 3

☐ Mobile Home No. Bathrooms 3

☐ Business No. Employees

☐ Other


Water Supply: ☑ Individual ☐ Public ☐ Community

Comments:/Conditions: DO NOT CUT HOUSE PAD - SITE VISIT REQUIRE BEFORE A/C TO BE ISSUED - DO NOT DISTURB ~~SITE~~ SEPTIC OR REPAIR AREA WITH ROAD CUT OR


Comments:/Conditions: EROSION CONTROL METHODS - ROAD NOT CUT IN AT TIME OF EVALUATION

48 Panels 5 1" holes

INITIAL SITE SKETCH 1"=50'

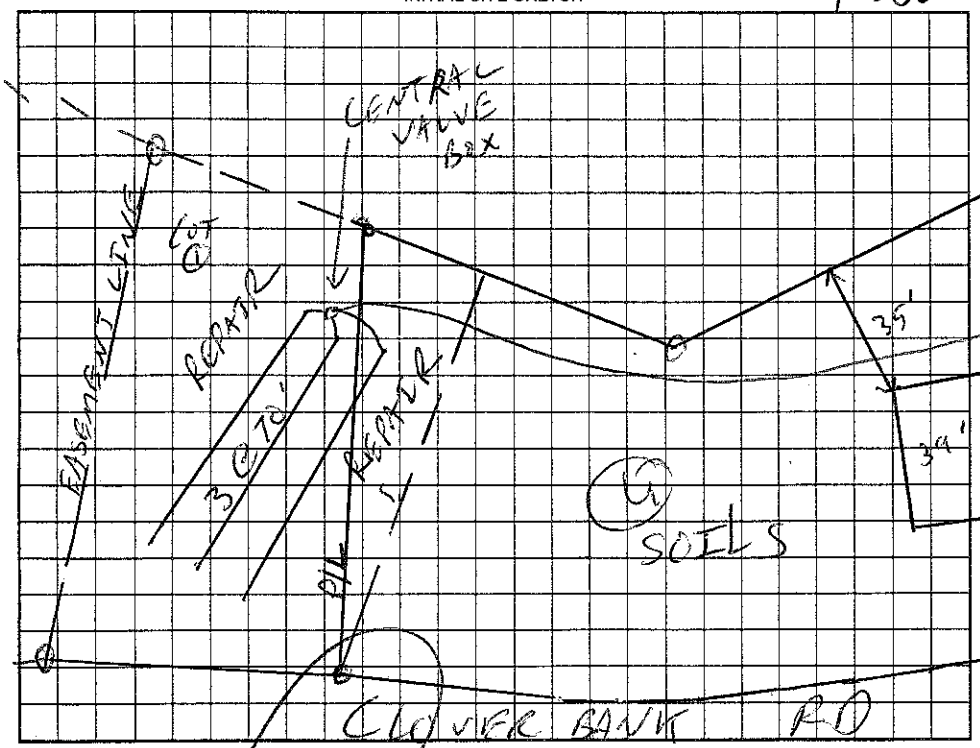

AS BUILT SKETCH

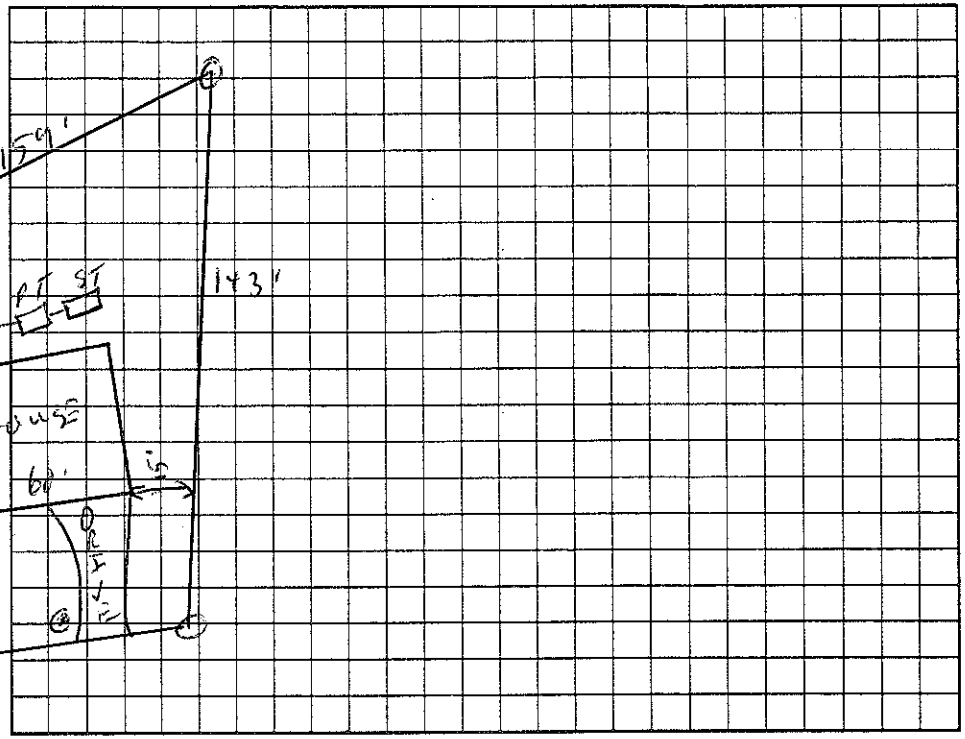

Permit can be suspended or revoked if any false information is supplied toward securing the permit/any unauthorized changes are made to the site/any unauthorized changes are made in the installation of the system. Improvement Permit with plat valid without expiration. Improvement Permit with site plan valid for sixty months. Authorization to Construct is valid for a period equal to that of Improvement Permit – not to exceed sixty months.

Signed: date 5-11-04 Installed by: M-Carver

Improvement Permit by: RS date 4/30/04 Operation Permit by: RS date 9/28/06

Authorization to Construct by: RS date 5/13/06 Existing System Inspection by: date

HEALTH DEPT. COPY: WHITE OWNER COPY (FINAL): YELLOW OWNER COPY (INITIAL): PINK