IREDELL COUNTY HEALTH DEPARTMENT

STATESVILLE 704-878-5305 MOORESVILLE 704-664-5281

IMPROVEMENT PERMIT / AUTHORIZATION TO CONSTRUCT / OPERATION PERMIT / EXISTING SYSTEM INSPECTION

PERMIT# 118913 PIN# 4644 99 7447.23 4654-09-2381 DATE 4/26/04

OWNER OR CONTRACTOR BURKE BUILDERS PHONE: Business 391-0047 Home

ADDRESS PO BOX 3481 MOORESVILLE NC 28115

LOCATION 115(S) - TR BRIDGES FARM - TR CLOVERBANK - ON RT CORNER

SUBDIVISION ESTATES BLOCK / SECTION LOT 23 LOT AREA 1.47AC SITE CLASS. PS DESIGN FLOW 360GPD L.T.A.R. .36GPD/FT²/.25 repair

Septic Tank: 1000 Gallons; STB 312 Date 8/26/05
Pump Tank: 1000 Gallons; PT 27 Date 1/22/06
Pump Make: Goulds Model PESTLM Serial No.
Nitrification Field: No Fields 1 Square Feet 900 Linear Feet 300
No Lines 6@50' Trench Width 36" Max Trench Bottom Depth 30" Gravel Depth N/A

☑ New System ☐ Repair System Type: I, II, III, IV, V, VI
System Description: pump 25% REDUCTION
Repair System Description: SAME
Maintenance Agreement Required: ☐ Yes ☑ No


☑ House/Mod. Home No. Bedrooms 3
☐ Mobile Home No. Bathrooms 3
☐ Business No. Employees
☐ Other
☐ Slab ☑ Crawl Space ☐ Basement w/plumbing ☐ Basement wo/plumbing

Water Supply: ☑ Individual ☐ Public ☐ Community


Comments:/Conditions: 1) DO NOT CUT HOUSE SITE 2) SITE VISIT REQUIRE BEFORE A/C TO BE ISSUED 3) CHECK FOR EROSION CONTROL METHODS 4) EROSION CONTROL SHALL NOT COMPROMISE SEPTIC & REPAIR

Comments:/Conditions: 5) ROAD NOT CUT AT TIME OF EVALUATION
ROAD CUT

INITIAL SITE SKETCH 1"=50'

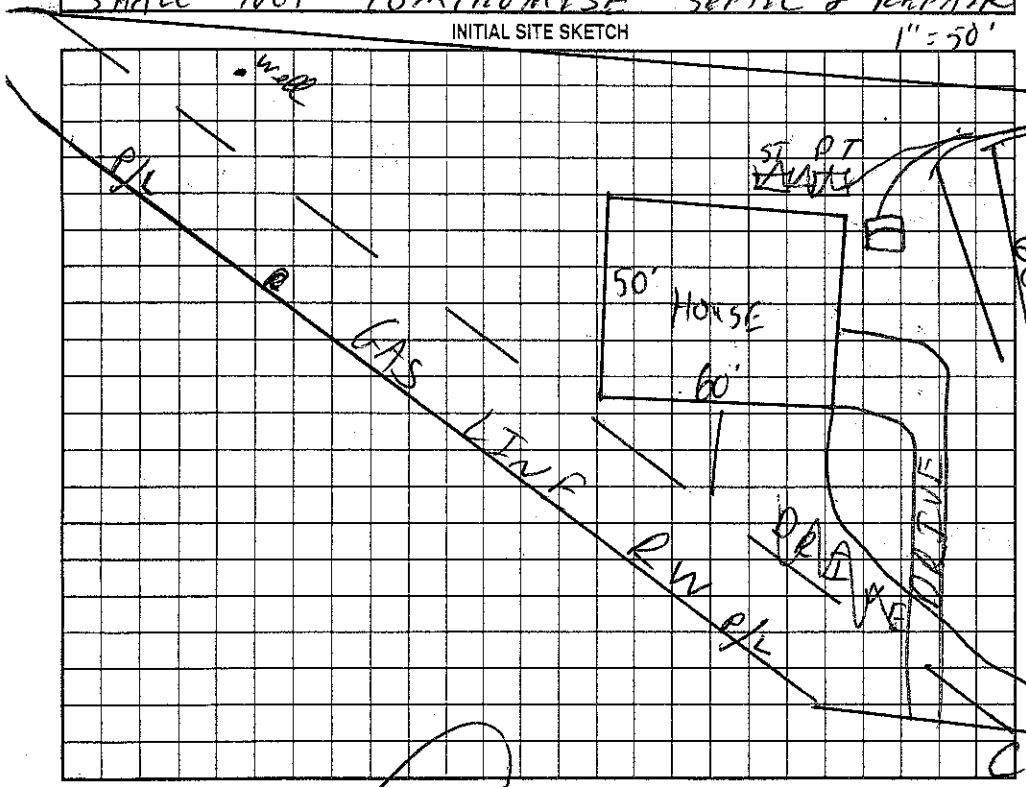

AS BUILT SKETCH

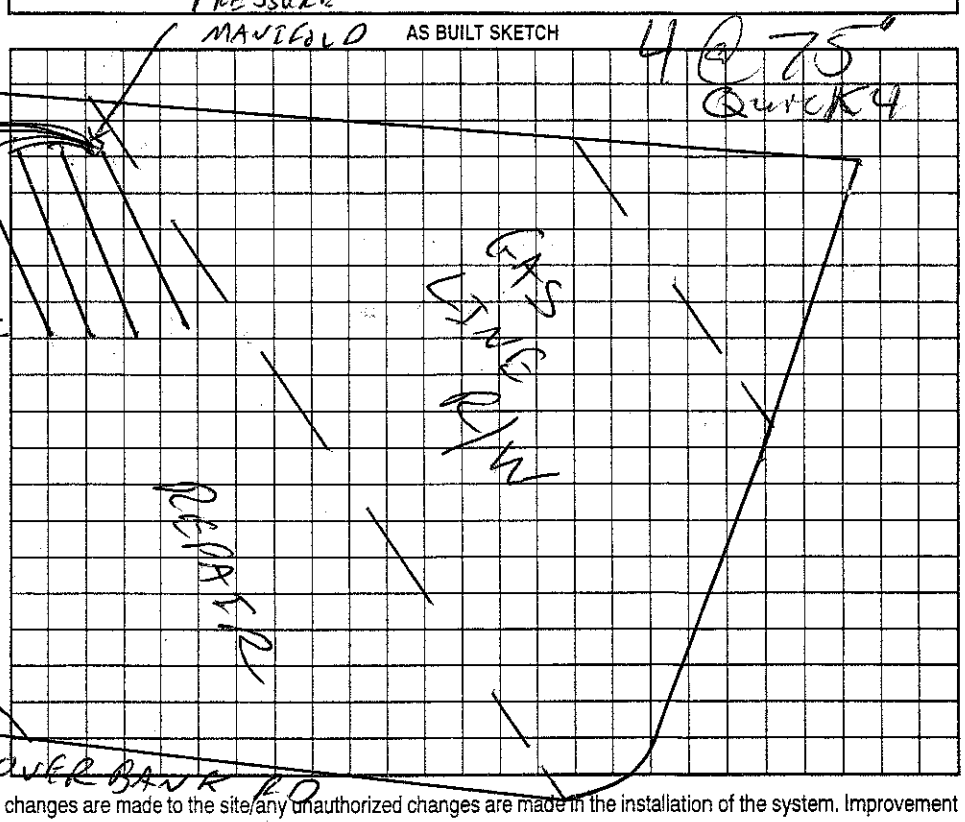

Permit can be suspended or revoked if any false information is supplied toward securing the permit/any unauthorized changes are made to the site/any unauthorized changes are made in the installation of the system. Improvement Permit with plat valid without expiration. Improvement Permit with site plan valid for sixty months. Authorization to Construct is valid for a period equal to that of Improvement Permit – not to exceed sixty months.

Signed: date 4/27/04 Installed by: M C Carver

Improvement Permit by: RS date 4/26/04 Operation Permit by: RS date 6/21/06

Authorization to Construct by: Whitney Sparks RS date 11/16/05 Existing System Inspection by: date

HEALTH DEPT. COPY: WHITE OWNER COPY (FINAL): YELLOW OWNER COPY (INITIAL): PINK