IREDELL COUNTY HEALTH DEPARTMENT

STATESVILLE 704-878-5305 130.00 Paid MOORESVILLE 704-664-5281

IMPROVEMENT PERMIT / AUTHORIZATION TO CONSTRUCT / OPERATION PERMIT / EXISTING SYSTEM INSPECTION

PERMIT# 118870 PIN# ~~4644997447.1~~ 4654093028 DATE 4/30/04

OWNER OR CONTRACTOR BURKE BUILDERS PHONE: Business 361-0047 Home

ADDRESS PO BOX 3481 MOORESVILLE NC 28115

LOCATION 115 (S) - TR BRIDGES FARM - TR @ CLOVER BANK - ON LT CORNER

SUBDIVISION ESTATES BLOCK / SECTION LOT 1 LOT AREA .78 AC SITE CLASS PS DESIGN FLOW 360GPD L.T.A.R. 1250SQFT

Septic Tank: 1000 Gallons; STB S12 Date 8/14/05
Pump Tank: 1000 Gallons; PT 2S5 Date 8/15/05
Pump Make Gould's Model EPOS11AC Serial No.
Nitrification Field: No Fields 1 Square Feet 480 Linear Feet 240
No Lines 6@40' Trench Width 24" Max Trench Bottom Depth 36" Gravel Depth N/A

☑ New System ☐ Repair System Type: I, II, III, IV, V, VI
System Description: PUMP PANEL
Repair System Description: SAME
Maintenance Agreement Required: ☐ Yes ☑ No

☑ House/Mod. Home No. Bedrooms 3
☐ Mobile Home No. Bathrooms 3
☐ Business No. Employees
☐ Other


☐ Slab ☑ Crawl Space ☐ Basement w/plumbing ☐ Basement wo/plumbing

Water Supply: ☑ Individual ☐ Public ☐ Community


Comments:/Conditions: 1) DO NOT CUT HOUSE PAD 2) SITE VISIT REQUIRED BEFORE A/C CAN BE ISSUED 3) H.D. CHECK FOR ROAD CUT AND EROSION CONTROL 4) EROSION CONTROL/ROAD CUT CANNOT COMPROMISE

Comments:/Conditions: → SEPTIC AND REPAIR AREA. 5) WELL ON OTHER SIDE OF GAS R/W. ROAD NOT CUT IN AT TIME OF EVALUATION.

INITIAL SITE SKETCH 1" = 50'

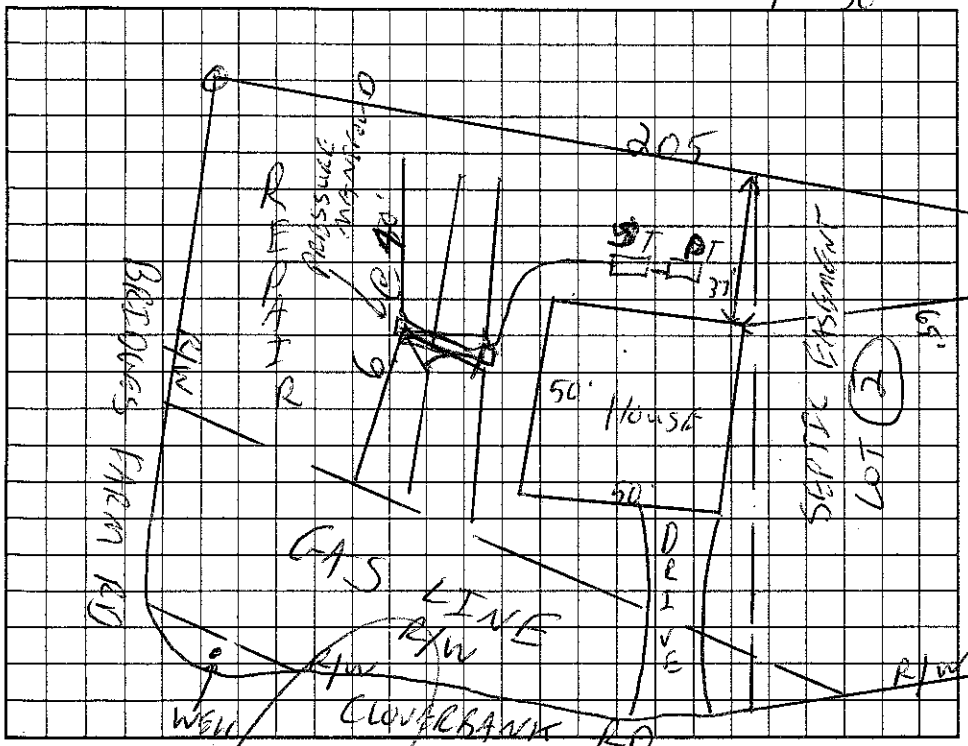

AS BUILT SKETCH

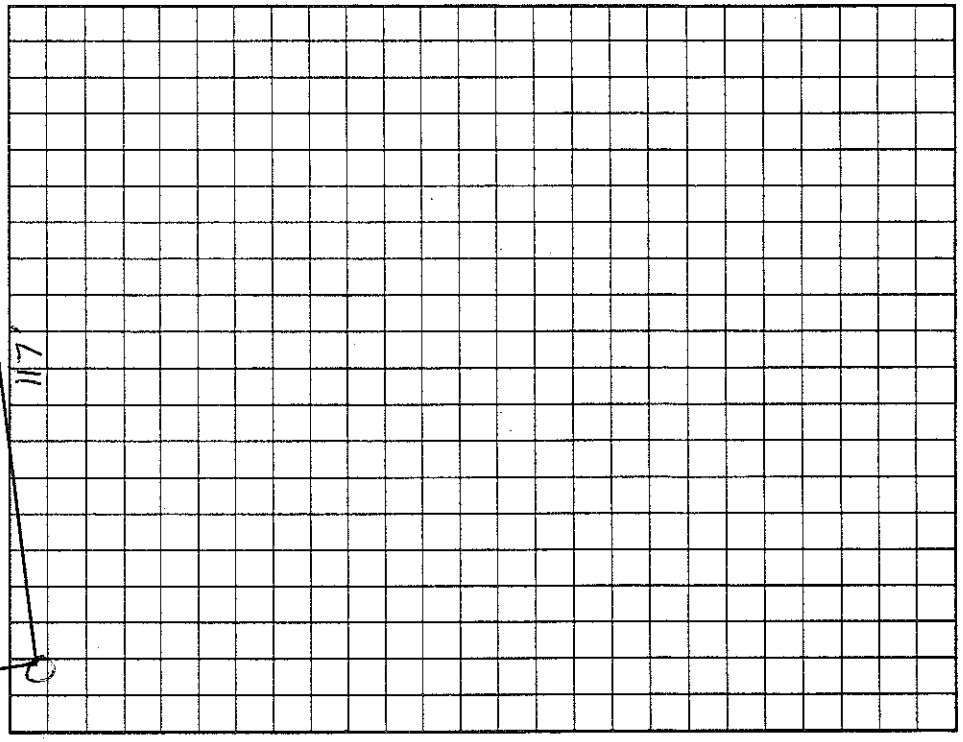

Permit can be suspended or revoked if any false information is supplied toward securing the permit/any unauthorized changes are made to the site/any unauthorized changes are made in the installation of the system. Improvement Permit with plat valid without expiration. Improvement Permit with site plan valid for sixty months. Authorization to Construct is valid for a period equal to that of Improvement Permit – not to exceed sixty months.

Signed: date 5-10-04 Installed by: Bob McCarver

Improvement Permit by: RS date 4/30/04 Operation Permit by: RS date 12/8/05

Authorization to Construct by: RS date 6/2/05 Existing System Inspection by: date

HEALTH DEPT. COPY: WHITE OWNER COPY (FINAL): YELLOW OWNER COPY (INITIAL): PINK