IREDELL COUNTY HEALTH DEPARTMENT

Statesville Office (704) 878-5305 (Mooresville Office) (704) 660-3625 PERMIT # 235171

SEPTIC IMPROVEMENT PERMIT / AUTHORIZATION TO CONSTRUCT / OPERATION PERMIT / EXISTING SYSTEM

PIN # 4654276957

APPLICANT/OWNER: Kirsten Cocrane / Peggy Meeks APPLICANT ADDRESS: 19460 Old Jetton Rd. Cornelius, NC

SITE ADDRESS: 1975 Mecklenburg Hwy. Mooresville, NC 28115 PHONE: 704-763-7466 ALT. PHONE 704-578-9095

SITE DIRECTIONS: NC 115 S → lot on L SAP CONTROLLED: ☐ YES ☐ NO

SUBDIVISION: J G Kennerly SECTION: — LOT # 9-14 LOT AREA: — DESIGN FLOW: 240gpd L.T.A.R.: —

Septic Tank 1000 (gal) STB 1060 infiltrator Date

Pump Tank (gal) PT Date

Pump Make Model Serial #

Nitrification Fields # Lines Linear Ft

Trench Width EXIST Trench Bottom Depth(Low side) INC Gravel Depth

☐ New System ☑ Repair ☐ Expansion System Type: I (II) III IV V VI

System Description:

Repair System Description: tank replacement

Maintenance Agreement Required: ☐ YES ☑ NO

☑ GRAVITY ☐ PRESSURE


☑ Residence ☐ Business ☐ Other ☐ Slab ☐ Basement w/plumbing

No. Bedrooms 2 No. Persons 4 No. Employees — ☑ Crawl Space ☐ Basement w/o plumbing


Water Supply: ☑ Private ☐ Public ☐ Community

Comments / Conditions: Pump, crush, & fill existing septic tank. *New tank must maintain a minimum of 5' from house *
Drain field not failing during time of inspection.

INITIAL SITE SKETCH

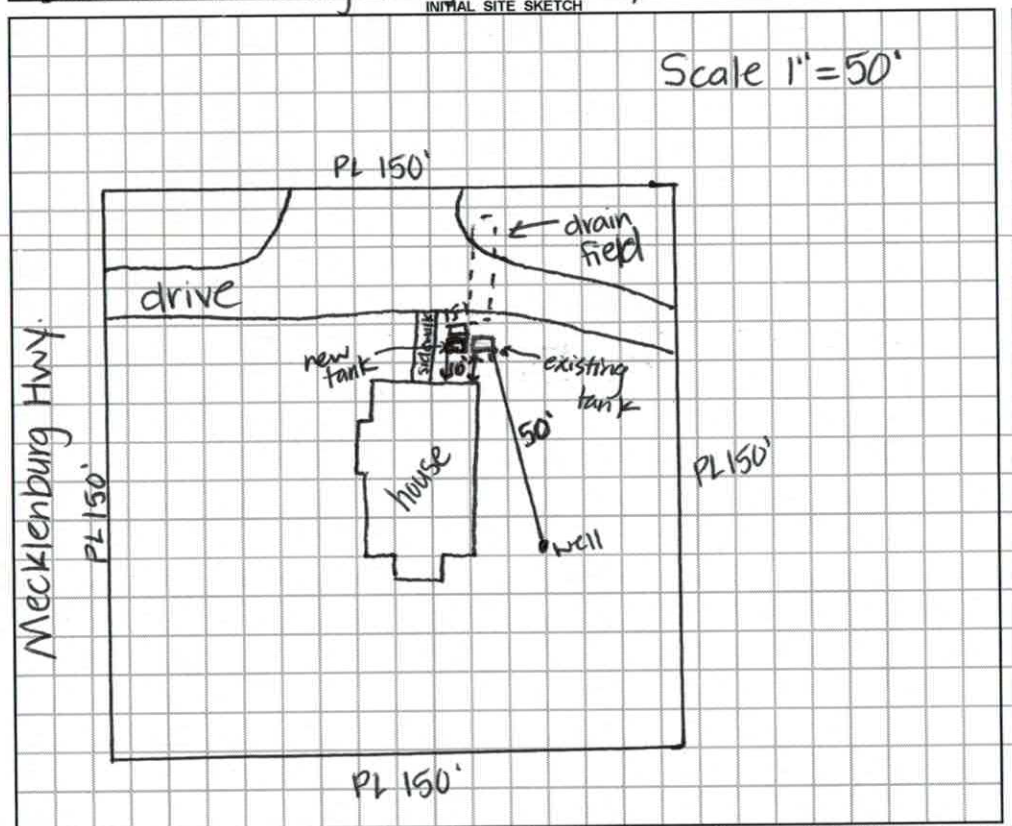

AS BUILT SKETCH

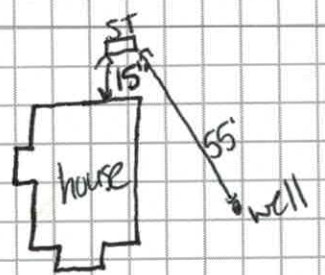

Permit can be suspended or revoked if any false information is supplied toward securing the permit / any unauthorized changes are made to the site / any unauthorized changes are made in the installation of the system. **CONTACT A LOCATOR SERVICE PRIOR TO ANY EXCAVATION**

☐ **IMPROVEMENT PERMIT** *with plat valid without expiration.* ☑ **IMPROVEMENT PERMIT** *with site plan valid for 60 mos.* ☑ **AUTHORIZATION TO CONSTRUCT** *valid for period equal to IMPROVEMENT PERMIT--not to exceed 60 mo.*

Owner / Applicant Signature: Peggy Meeks Date: 5-4-18 Installed by: Ammons Septic Services

IMPROVEMENT PERMIT by: Kayla Wilson Date: 4-30-18 OPERATION PERMIT by: Kayla Wilson Date: 6-21-18

AUTHORIZATION TO CONSTRUCT by: Kayla Wilson Date: 4-30-18 Existing System Inspected by: Date:

FOR SEPTIC FINAL INSPECTION: CALL 704-664-3703 between 8am-9am the day the inspection is needed. Be sure to speak with an inpsector to confirm your inspection time.

RECEIVED APR 26 2018

IREDELL COUNTY DEPARTMENT of ENVIRONMENTAL HEALTH #235171

APPLICATION FORM Rpr. Evaluation - No Chg

Application For: ( ) New Well Permit ( ) Well Repair Permit ( ) Well Abandonment
( ) Septic Improvement Permit ( ) Authorization to Construct ( ) Existing System Inspection (X) Septic System Repair

THE ABOVE PERMIT DOCUMENTS WILL BECOME INVALID IF INFORMATION PROVIDED ON THIS APPLICATION IS FALSIFIED OR CHANGED, OR IF THE SITE IS ALTERED. THE IMPROVEMENT PERMIT IS VALID FOR EITHER 60 MONTHS OR WITHOUT EXPIRATION DEPENDING UPON DOCUMENTATION SUBMITTED. APPLICATION WITH SITE PLAN 60 MONTHS, APPLICATION WITH COMPLETE, SCALED PLAT WITHOUT EXPIRATION. SEE 15A NCAC 18A .1937(f) FOR DETAILS.

Page 2: *Site Plan Worksheet* form MUST accompany this application Paid $150.00 5/4/18

The following optional attachments may also be submitted: ( ) Survey Plat, scaled no more than 1 inch = 60 feet
Place an (X) beside whichever is submitted if applicable ( ) Custom Site Plan, scaled no more than 1 inch = 60 feet

Applicant Information: (PRINT CLEARLY)

Applicant Name: Kirsten Cocrane **Address:** 19460 Old Jetton Road, Cornelius **Zip:** 28031
Applicant Email: kirsten.cocrane@allentate.com **Phone:** 704-763-7466 **Alt. Phone:**
Owner Name: Peggy Meeks **Address:** 1975 Mecklenburg Highway, Mooresville **Zip:** 28115
Owner Email: Peggy.meeks@duke-energy.com **Phone:** +17045789095 **Alt. Phone:**

Property Information:

Street Address: 1975 Mecklenburg Highway, Mooresville, NC 28115

Subdivision Name: JG Kennerly **Section/Phase:** M2 **Lot Number:** 9-14

Driving Directions: I-77N to exit 30. RIGHT onto Griffith Street. Continue straight through two roundabouts. LEFT onto North Main Street. Home is located about a mile up the road on the RIGHT.

Site Development Information: *(check or complete ALL that apply*

CHECK FOUNDATION TYPE

( ) New Single Family Residence
( ) New Multi-Family Residence
( ) Accessory Building
( ) Bedroom(s) Addition
(X) Repair to failing septic system

Maximum Number of Bedrooms: 2
Maximum Number of Occupants:
( ) Swimming Pool
( ) Other Addition/Structure:

(X) Crawl Space Foundation
( ) Concrete Slab Foundation
( ) Basement with Plumbing
( ) Basement without Plumbing

X Tank ___ Drain lines Describe Problem:

Non-Residential Site Development: Type of Business:
Square Footage of Building: Max. Number of Employees: Max. Number of Seats/Beds/Other:

Water Supply: ( ) Replacement Well – Reason:
( ) Multi-connection Well Number of Houses: Number of Persons:

( ) New Well (X) Existing Well ( ) Community Well ( ) City Water ( ) Other Public Water

Desired Septic System Type: *(you may rank in order of preference)* Year existing system installed: 1954
(X) No Preference ( ) Alternative ( ) Conventional ( ) Innovative ( ) Modified Conventional ( ) Other:

Please answer the following to the best of your ability:

( ) Yes (X) No Does the site contain any jurisdictional wetlands?
( ) Yes (X) No Is any non-domestic sewage (i.e. industrial) to be generated?
( ) Yes (X) No Is the site subject to approval by any other public agency?

I have read this application and certify that the information provided herein is true, complete, and correct. Authorized county and state officials are granted right of entry to conduct necessary inspections to determine compliance with applicable laws and rules. I understand that I am solely responsible for the proper identification and labeling of all property lines and corners and making the site accessible so that a complete site evaluation can be performed.

Signature: Peggy Johnson Meeks 4-25-18
Property owner or owner's legal representative signature (SIGNATURE REQUIRED) DATE

IREDELL COUNTY DEPARTMENT OF ENVIRONMENTAL HEALTH

DOCUMENTATION TO AUTHORIZE AN OWNER'S LEGAL REPRESENTATIVE

Applications for permits require the "signature of the owner or owner's legal representative" (15A NCAC 18A .1937). If the owner does not sign the application himself or herself, they can submit any one of the following documents to designate their legal representative:

Power of Attorney; Real Estate Contract; Estate executor; Bankruptcy trustee; Court ordered guardianship

In the absence of the above documentation, the property owner may provide the local health department with documentation that designates a legal representative. A property owner may:

Complete this form to document his or her legal representative, or provide his or her own form that contains the information in this form.

If there are multiple property owners, then all property owners must sign the form that designates a legal representative.

By signing a form that designates a legal representative for purposes of 15A NCAC 18A .1937, the property owner authorizes that representative to act on their behalf in matters pertaining to the application and permitting process, including signing or receiving any application, document or permit. The owner retains full responsibility to meet all permit conditions specified by the local health department.

I, Peggy Meeks, am the legal owner(s) of the property located at 1975 Mecklenburg Highway, Mooresville, N C 28115, identified as PIN (Parcel Identification Number) 4654-27-6957.000, located in Iredell County, North Carolina.

I do hereby authorize (**print legal representative/company name**) Kirsten Cocrane at Allen Tate Company, to act as an agent on my behalf in applying for/signing/obtaining any of the documents described below.

- Application for Improvement Permit (IP) / Authorization to Construct (AC)
- Improvement Permit (IP) / Authorization to Construct (AC)
- Application for soil-site evaluation (new/repair)
- Application/permit for private drinking water well/well abandonment
- Application for Compliance Inspection

I agree to abide by all decisions and/or conditions between the legal representative acting on my behalf and the Iredell County Department of Public Health, Environmental Health Division.

Peggy Johnson Meeks — 4-25-18

Signature of Owner(s) Date Signature of Witness Date

Please return this signed form to the appropriate office:

Mooresville - Environmental Health
ronda.hart@co.iredell.nc.us
Fax: 704-662-3239
610 E. Center Avenue, Mooresville, NC 28115

Statesville - Environmental Health
adrienne.shea@co.iredell.nc.us
Fax: 704-871-3483
349 N. Center Street, Statesville, NC 28677