2:00

IREDELL COUNTY HEALTH DEPARTMENT

STATESVILLE 704-878-5305 MOORESVILLE 704-664-5281

IMPROVEMENT PERMIT / AUTHORIZATION TO CONSTRUCT / OPERATION PERMIT / EXISTING SYSTEM INSPECTION

PERMIT # REPAIR PIN # 4654-28-5486 DATE 7-9-09

OWNER or APPLICANT JESSIE HASTINGS PHONE: Business Home:

OWNER or APPLICANT ADDRESS 1953 HWY 115

LOCATION / DIRECTIONS Hwy 115 S before Presbyterian on left

SUBDIVISION — BLOCK / SECTION — LOT # — LOT AREA ~1AC DESIGN FLOW 360 L.T.A.R. .3

Used Exist ST

Septic Tank ~~1000~~ Gallons: STB Date

Pump Tank Gallons: P T Date

Pump Make Model Serial #

Nitrification Field No Fields 1 No Lines BED Linear Feet 44X21' BED

Trench Width 21' Max. Trench Bottom Depth 36" Gravel Depth —

☐ New System ☒ Repair ☐ Expansion System Type I (II) III IV V VI

System Description:

Repair System Description: GRAVITY CHAMBER BED

Maintenance Agreement Required ☐ YES ☒ NO

☒ GRAVITY ☐ PRESSURE


☒ Residence No. Bedrooms 3 ☐ Business No. Persons ☐ Other No. Employees ☐ Slab ☒ Crawl Space ☐ Basement w/plumbing ☐ Basement w/o plumbing

Water Supply: ☒ Private ☐ Public ☐ Community


Comments / Conditions 1) OLD BED TO BE DISCONECTED 2) OLD TANK TO BE PUMPED, CRUSHED + FILLED 3) USE BULL RUN VALVE SO BOTH DRAIN FIELDS MAY BE USED IN FUTURE IF NEEDED

Comments / Conditions * CHECKED BED 7-30-09 7/31/09 Visual Check, ST looked Structurally Sound.

INITIAL SITE SKETCH

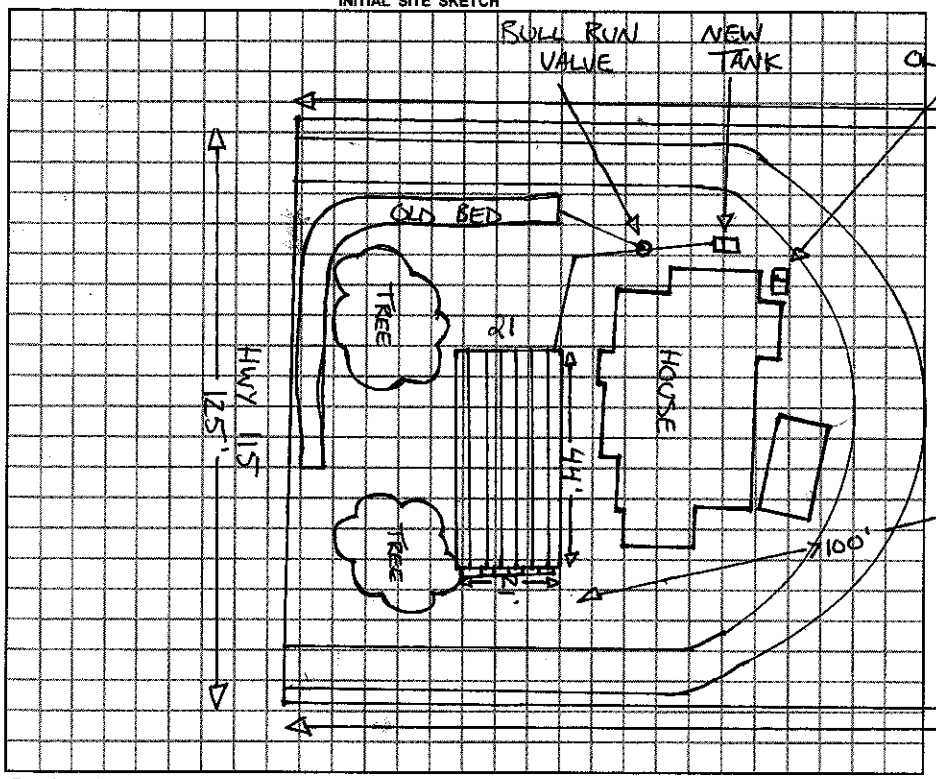

AS BUILT SKETCH

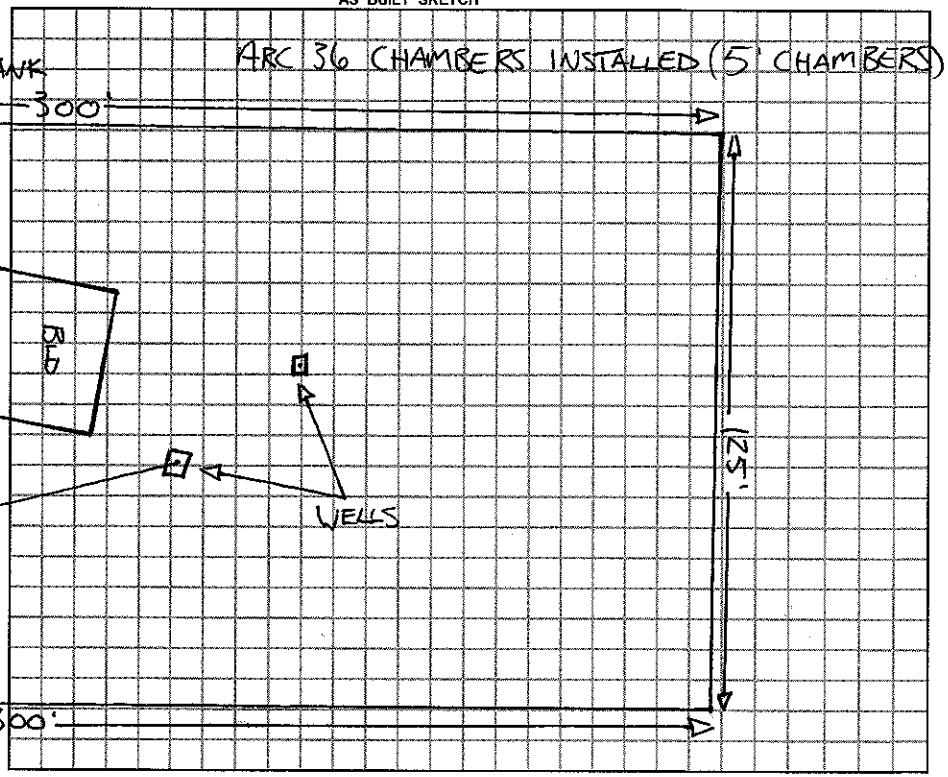

Permit can be suspended or revoked if any false information is supplied toward securing the permit / any unauthorized changes are made to the site / any unauthorized changes are made in the installation of the system.

☐ *IMPROVEMENT PERMIT w / plat valid without expiration.* ☐ *IMPROVEMENT PERMIT w / site plan valid for 60 mos.* ☒ *AUTHORIZATION TO CONSTRUCT valid for period equal to IMPROVEMENT PERMIT-not to exceed 60 mo.*

Owner / Applicant Signature: Jessie Hastings Date

Improvement Permit by: J. Allen Date 7-9-09

Authorzation to Construct by: J. Allen Date 7-9-09

YOU SHOULD CONTACT A LOCATOR SERVICE PRIOR TO ANY EXCAVATION.

Installed by: Richard Abernathy

Operation Permit by: Maria H. Dolan RS Date 7/31/09

Existing System Inspected by: Date:

WHITE COPY Environmental Health YELLOW COPY (Final) Owner / Applicant PINK COPY (Initial) Owner / Applicant