IREDELL COU..I HEALTH DEPARTMENT

Statesville Phone TR 3-7271 Mooresville Phone NO 3-1271

PERMIT TO INSTALL SEPTIC TANK

Permit No._____ Permit Date 18 Nov 1966

Cont. ~~Owner~~ Floyd Ballard Address Davidson, N.C.

Installed By Daryle Orbinson Address Mt Marne, NC.


Location of Property 115 S. beside Jacks Grill

Tank		Capacity		Length of Lines		Fixtures	
Block	( )	1000	(✓)	225'	(✓)	No. of Baths	( )
Precast	( )	1250	( )	250'	( )	Dishwasher	( )
		1500	( )	Other_____		Garbage Grdr.	( )
		Other_____				Other_____	

NOTIFY HEALTH DEPARTMENT AT LEAST EIGHT HOURS BEFORE TANK IS TO BE INSPECTED.

Final Inspection 18 Nov 1966 Approved (✓) Disapproved ( )

Remarks Water From next lot

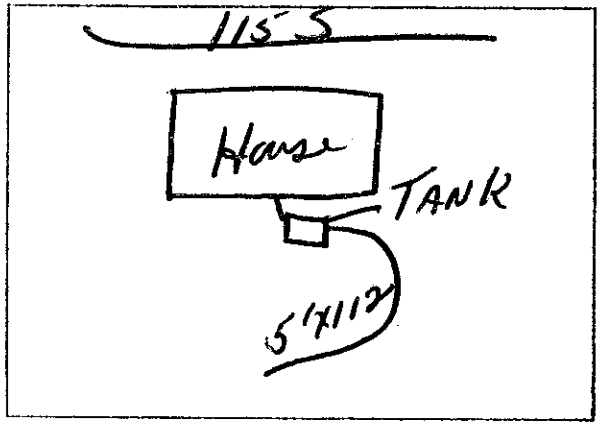

Sketch of Installation

Ray Scoggins RS

Sanitarian