IREDELL COUNTY HEALTH DEPARTMENT

Authorization to Construct

(1, 30)

STATESVILLE 704-878-5305 MOORESVILLE 704-664-5281

IMPROVEMENT PERMIT / ~~CERTIFICATE OF COMPLETION~~ / OPERATION PERMIT / EXISTING SYSTEM INSPECTION

PROPERTY DESCRIPTION NO. Repair DATE 7/8/97 TAX MAP NO. N/A 4059294112

OWNER OR CONTRACTOR Les Robinson PHONE: Business Watershed: ☐ Yes ☒ No

ADDRESS 3704 Tinsley Brook Tr. Clemmons, NC. 27012 Home 910-712-0468

LOCATION 1155 TL Mitchem Lake Rd 1st house on (L) - white frame

SUBDIVISION BLOCK / SECTION LOT LOT AREA SITE CLASS. DESIGN FLOW L.T.A.R.

Septic Tank: 1000 Gallons; STB 794 Date 7/18/97

Pump Tank: Gallons; PT Date

Pump Make: Model Serial No.

Nitrification Field: No Fields 1 Square Feet 900 Linear Feet 300

No Lines 6 Trench Width 36" Max Trench Bottom Depth 36" Gravel Depth 12"

☐ New System ☒ Repair System Type: I, II, III, IV, V, VI

System Description: Conventional

Repair System Description:

Maintenance Agreement Required: ☐ Yes ☐ No

☒ House/Mod. Home ☐ Mobile Home ☐ Business ☐ Other

No. Bedrooms 3 No. Bathrooms 1 No. Employees


☐ Slab ☒ Crawl Space ☐ Basement w/plumbing ☐ Basement wo/plumbing

Water Supply: ☒ Individual ☐ Community ☐ Public


Comments:

Comments: WASHING MACHINE DRAIN COMING FROM SIDE OF HOUSE TO DITCH. ANOTHER PERMIT TO BE DRAWN UP.

INITIAL SITE SKETCH

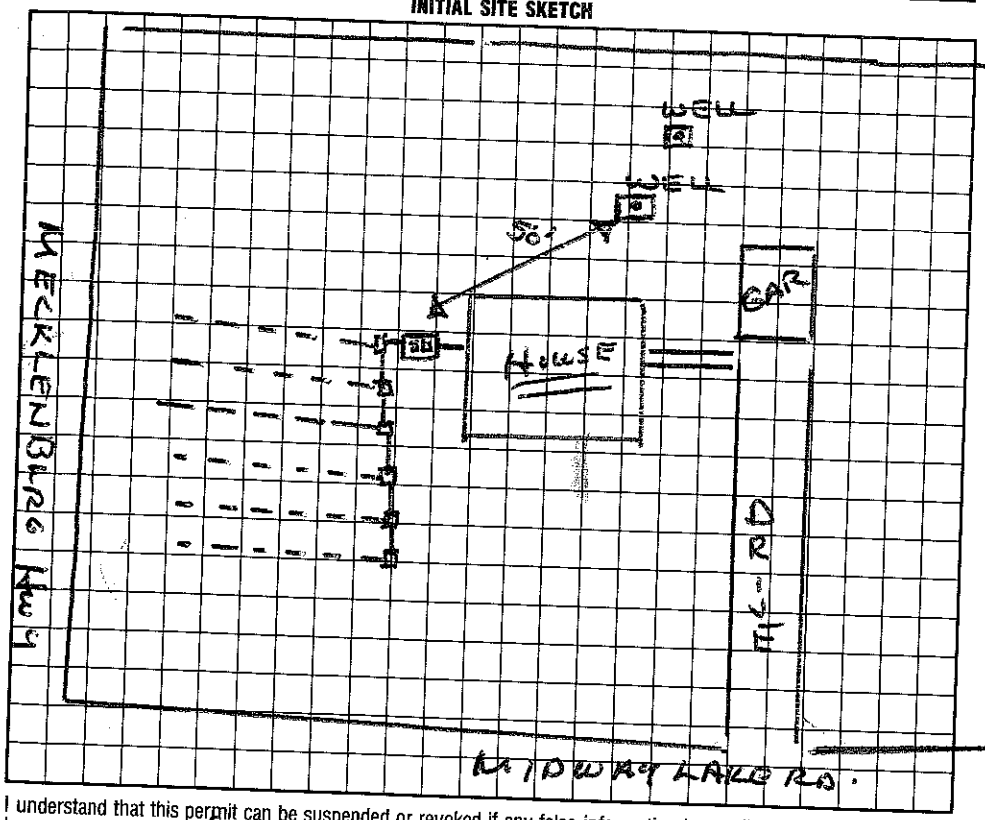

AS BUILT SKETCH

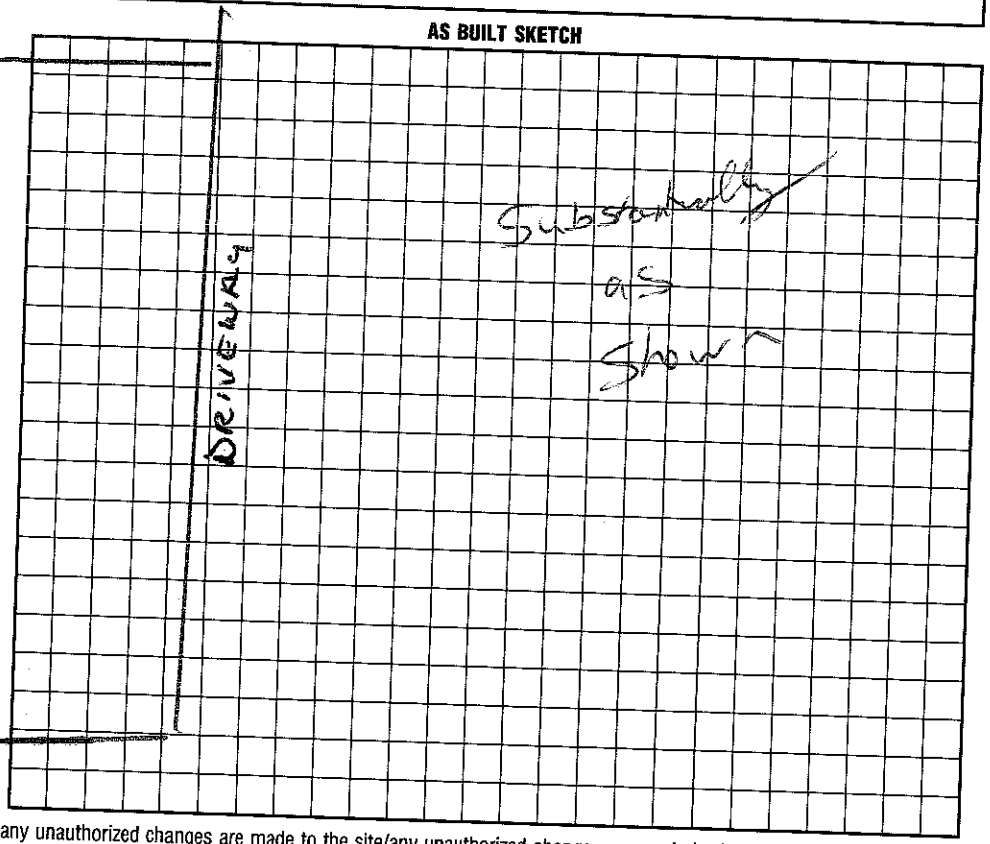

I understand that this permit can be suspended or revoked if any false information is supplied toward securing the permit/any unauthorized changes are made to the site/any unauthorized changes are made in the installation of the system. Improvement Permit is valid for 60 months from date of issuance.

Signed: ~~X~~ Les Robinson

Improvement Permit by: Wesley Sparks RS. date 7/8/97

Existing System Inspection by: Wesley Sparks RS. date 7/9/97

Installed by: DUNNING.

Certificate of Completion by: date

Operation Permit by: C. Ruby Tenn date 7/17/97

HEALTH DEPT. COPY: WHITE INSPECTION COPY (FINAL): GREEN OWNER COPY (FINAL): YELLOW INSPECTION COPY (INITIAL): PINK OWNER COPY (INITIAL): GOLD