IREDELL COUNTY HEALTH DEPARTMENT

STATESVILLE 704-878-5305 MOORESVILLE 704-664-5281

IMPROVEMENT PERMIT / AUTHORIZATION TO CONSTRUCT / OPERATION PERMIT / EXISTING SYSTEM INSPECTION

PERMIT # 173710-MOORESVILLE PIN# ~~4654 296 211~~ DATE 8/6/12

OWNER or APPLICANT FLOYD BLACKWELL PHONE: Business 4654296217 Home: 704-892-6536

OWNER or APPLICANT ADDRESS 550 MIDWAY LAKE RD

LOCATION / DIRECTIONS 115 S - TL MIDWAY LAKE - ON LEFT

SUBDIVISION — BLOCK / SECTION — LOT # — LOT AREA DESIGN FLOW 360 L.T.A.R. EXISTING

Septic Tank EXISTING Gallons: STB Date

Pump Tank Gallons: PT Date

Pump Make Model Serial #

Nitrification Field No Fields 2 No Lines 4 Linear Feet 400 EXISTING

Trench Width EXISTING Max. Trench Bottom Depth EXISTING Gravel Depth EXISTING ☒ GRAVITY ☐ PRESSURE

☒ New System ☐ Repair ☐ Expansion System Type I (II) III IV V VI

System Description: GRAVITY CONVENTIONAL

Repair System Description: SAME PUMP

Maintenance Agreement Required ☐ YES ☒ NO

☒ Residence No. Bedrooms 3

☐ Business No. Persons 2

☐ Other No. Employees

☐ Slab ☒ Crawl Space

☐ Basement w/plumbing ☐ Basement w/o plumbing


Water Supply: ☒ Private ☐ Public ☐ Community

Comments / Conditions


1"=60'

Comments / Conditions

INITIAL SITE SKETCH

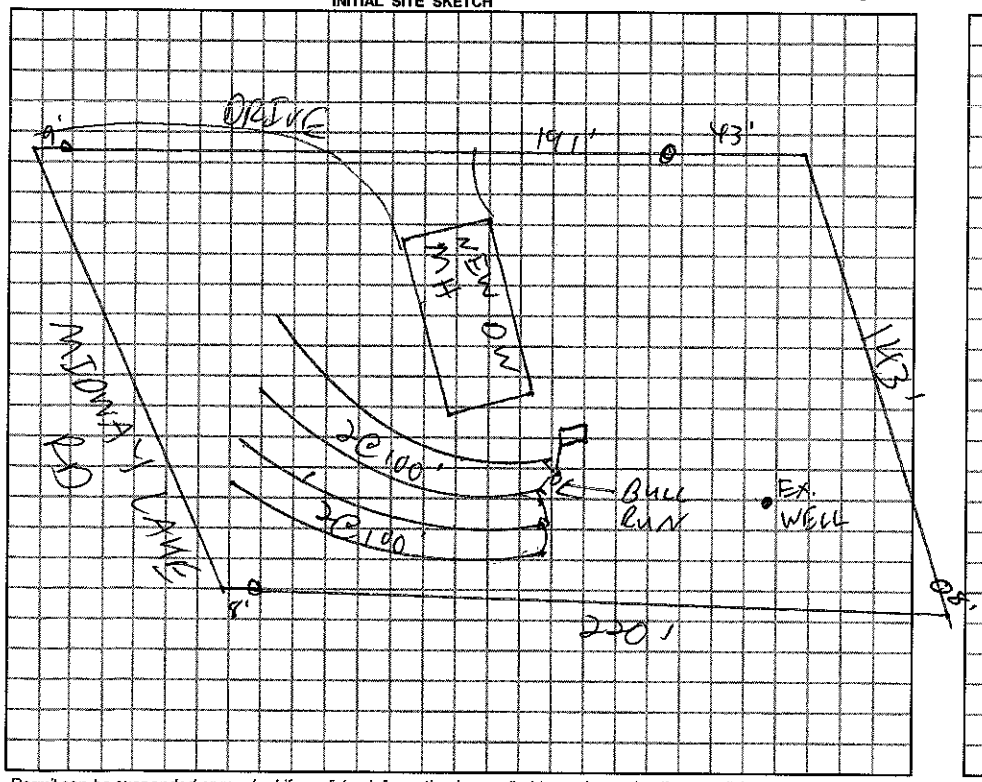

AS BUILT SKETCH

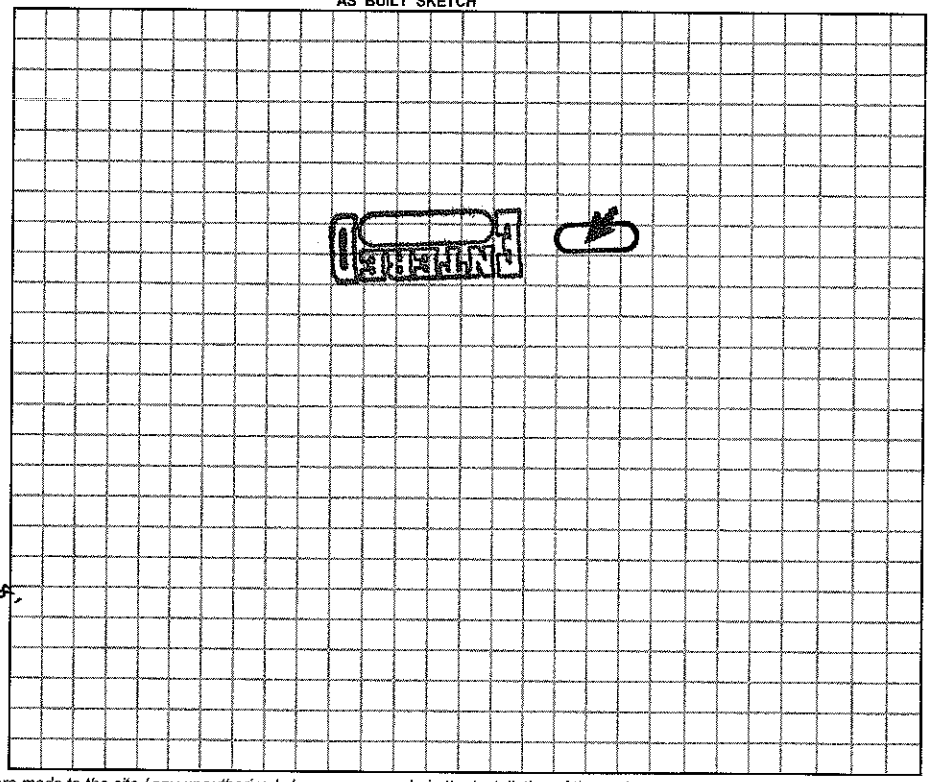

Permit can be suspended or revoked if any false information is supplied toward securing the permit / any unauthorized changes are made to the site / any unauthorized changes are made in the installation of the system.

☐ *IMPROVEMENT PERMIT w / plat valid without expiration.* ☐ *IMPROVEMENT PERMIT w / site plan valid for 60 mos.* ☐ *AUTHORIZATION TO CONSTRUCT valid for period equal to IMPROVEMENT PERMIT-not to exceed 60 mo.*

Owner / Applicant Signature: Floyd Blackwell Date 8-6-12

Improvement Permit by: Date

Authorization to Construct by: Date

YOU SHOULD CONTACT A LOCATOR SERVICE PRIOR TO ANY EXCAVATION.

Installed by:

Operation Permit by: Date:

Existing System Inspected by: C. Brady Franklin REHS Date: 8/6/12

WHITE COPY Environmental Health YELLOW COPY (Final) Owner / Applicant PINK COPY (Initial) Owner / Applicant