IREDELL COUNTY HEALTH DEPARTMENT

4654370266

STATESVILLE 704-878-5305 MOORESVILLE 704-664-5281

IMPROVEMENT PERMIT / ~~CERTIFICATE OF COMPLETION~~ / OPERATION PERMIT / EXISTING SYSTEM INSPECTION

PROPERTY DESCRIPTION NO. Repair DATE 4/15/96 TAX MAP NO. Watershed: ☐ Yes ☑ No

OWNER OR CONTRACTOR Jean King PHONE: Business Home 896-0353

ADDRESS 115 Rockwell Loop Mooresville NC 28115

LOCATION 115 S TR Rockwell Loop Rd — 2nd house on Left.

SUBDIVISION BLOCK / SECTION LOT LOT AREA SITE CLASS. PS DESIGN FLOW 360 L.T.A.R. .3 gpd/sf

Septic Tank: Existing Gallons; STB Date

Pump Tank: Gallons; PT Date

Pump Make: Model Serial No.

Nitrification Field: No Fields 1 Square Feet 500 Linear Feet 50

No Lines 3 Trench Width 10-36 Max Trench Bottom Depth 36" Gravel Depth 24"

☐ New System ☑ Repair System Type: I (II) III IV V VI

System Description: Gravity Conventional Bed

Repair System Description:

Maintenance Agreement Required: ☐ Yes ☑ No

☑ House/Mod. Home No. Bedrooms 3

☐ Mobile Home No. Bathrooms 2

☐ Business No. Employees

☐ Other

☐ Slab ☑ Crawl Space ☐ Basement w/plumbing ☐ Basement wo/plumbing

Water Supply: ☑ Individual ☐ Community ☐ Public

Comments: Washing Machine and sink drains need to be tied into System, Stay 50' from any part of well area, Building in back need to be moved, Use old & new system.


Comments: 47

3 | 14

12

20

INITIAL SITE SKETCH Replace sanitary tee if necessary.

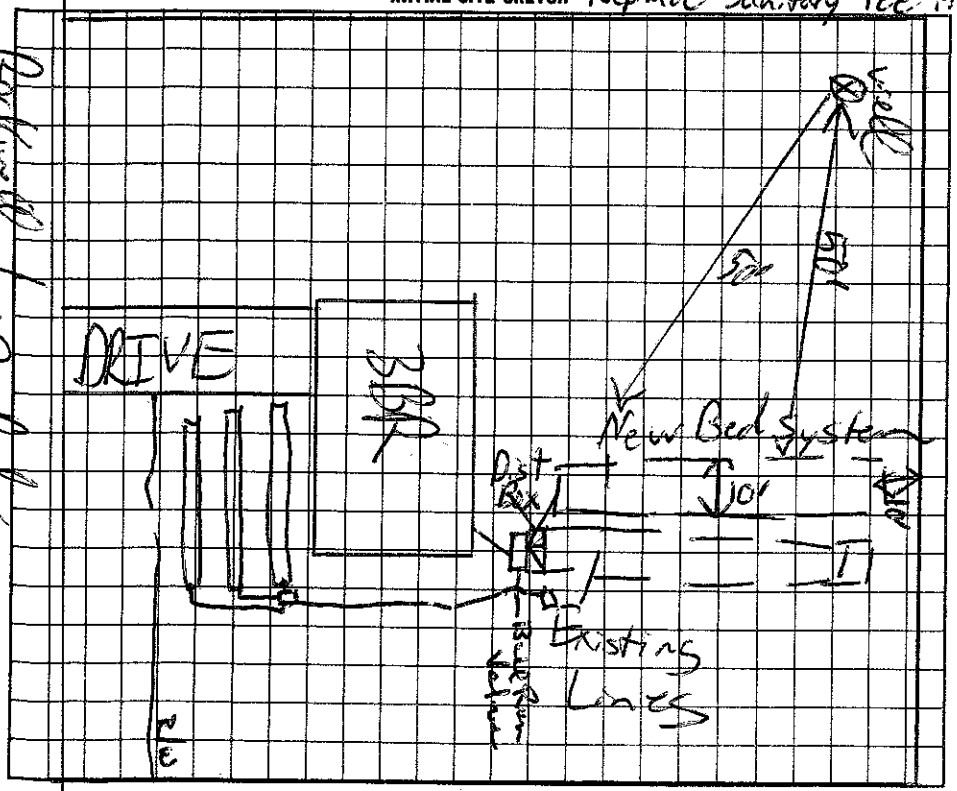

AS BUILT SKETCH

I understand that this permit can be suspended or revoked if any false information is supplied toward securing the permit/any unauthorized changes are made to the site/any unauthorized changes are made in the installation of the system.

Signed: Jean King

Improvement Permit by: C. Beaty Freeman EHSO date 4/15/96

~~Existing System Inspection~~ by: C. Beaty Freeman EHSO date 4/15/96

Installed by: Tim Simmons

Certificate of Completion by: date

Operation Permit by: Wesley Sparks R.S. date 5/17/96

to Cons, HEALTH DEPT. COPY: WHITE INSPECTION COPY (FINAL): GREEN OWNER COPY (FINAL): YELLOW INSPECTION COPY (INITIAL): PINK OWNER COPY (INITIAL): GOLD