IREDELL COUNTY HEALTH DEPARTMENT

STATESVILLE 704-878-5305 MOORESVILLE 704-664-5281

IMPROVEMENT PERMIT / AUTHORIZATION TO CONSTRUCT / OPERATION PERMIT / EXISTING SYSTEM INSPECTION

PERMIT# 075597 PIN# 4654 37 1402 DATE 10/6/98

OWNER OR CONTRACTOR Rockwell Baptist Church PHONE: Business 892-7302 Home

ADDRESS 133 Rockwell Loop Mooresville, NC. 28115

LOCATION Presbyterian Rd. TR at Rockwell Church.

SUBDIVISION BLOCK / SECTION LOT LOT AREA EXISTING SITE CLASS. PS DESIGN FLOW 300GPD L.T.A.R. .3

Septic Tank: 1000 Gallons; STB 312 Date 6/11/00

Pump Tank: 1000 Gallons; PT 283 Date 5/26/00

Pump Make: Hoaldo Model NEO 311M Serial No. 8/22/00 pm 250

Nitrification Field: No Fields 1 Square Feet 900 Linear Feet

No Lines 3 Trench Width 12' Max Trench Bottom Depth 36" Gravel Depth 24"

☒ New System ☐ Repair System Type: I, II, III, IV, V, VI

System Description: PressMan - CH PLASTIC

Repair System Description:

Maintenance Agreement Required: ☐ Yes ☐ No

☐ House/Mod. Home No. Bedrooms

☐ Mobile Home No. Bathrooms

☐ Business No. Employees

☐ Other

☐ Slab ☐ Crawl Space ☐ Basement w/plumbing ☐ Basement wo/plumbing


Water Supply: ☐ Individual ☐ Public ☐ Community

Comments:/Conditions:


PARKING
DAS LINE AND SIGN WILL NEED TO BE RELOCATED

Comments:/Conditions: Checked lines (bed) 12/9/99
~ 2006/DOSE

INITIAL SITE SKETCH

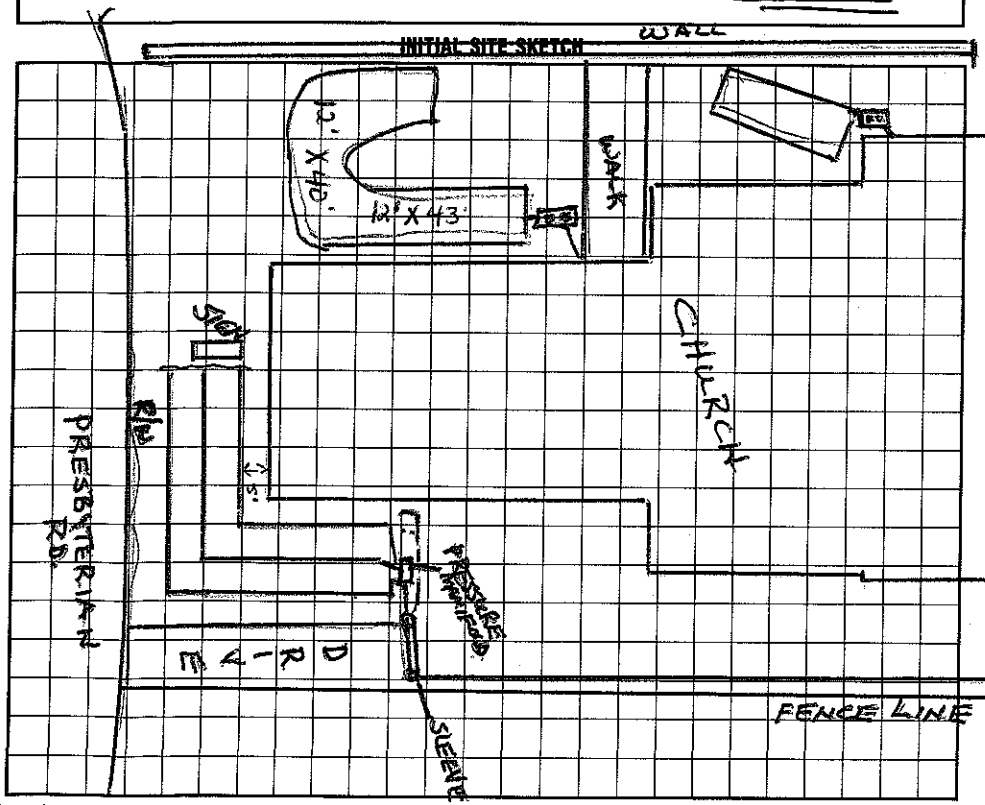

AS BUILT SKETCH

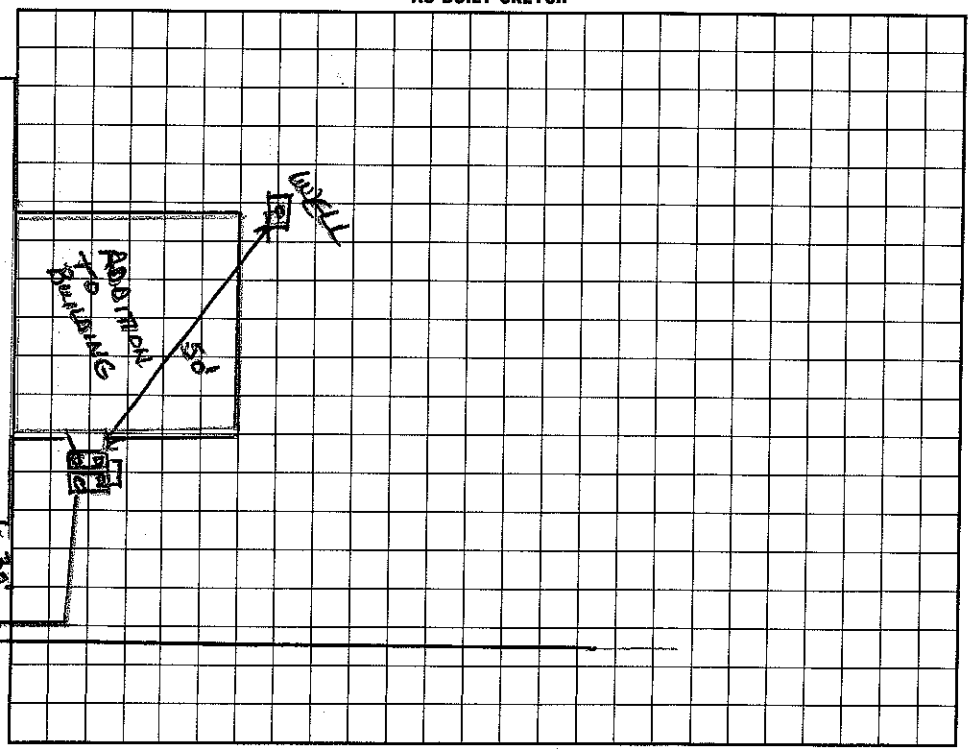

I understand that this permit can be suspended or revoked if any false information is supplied toward securing the permit/any unauthorized changes are made to the site/any unauthorized changes are made in the installation of the system. Improvement Permit with plat valid without expiration. Improvement Permit with site plan valid for sixty months. Authorization to Construct is valid for a period equal to that of Improvement Permit – not to exceed sixty months.

Signed: Michael D. Barber date 10-12-98

Improvement Permit by: Wesley Sparks RS. date 10/6/98

Authorization to Construct by: Wesley Sparks RS date 10/6/98

Installed by: FJ Erwin

Operation Permit by: Wesley Sparks RS. date 10/24/00

Existing System Inspection by: date

HEALTH DEPT. COPY: WHITE INSPECTION COPY (FINAL): GREEN OWNER COPY (FINAL): YELLOW INSPECTION COPY (INITIAL): PINK OWNER COPY (INITIAL): GOLD