IREDELL COUNTY HEALTH DEPARTMENT

STATESVILLE 704-878-5305 MOORESVILLE 704-664-5281

IMPROVEMENT PERMIT / AUTHORIZATION TO CONSTRUCT / OPERATION PERMIT / EXISTING SYSTEM INSPECTION

PERMIT # 160410 PIN # 4654-37-2036 DATE 3-30-10

OWNER or APPLICANT DAVID & BRITTANY BARBER PHONE: Business 704-655-8997 Home:

OWNER or APPLICANT ADDRESS 118 ROCKWELL LOOP MOORESVILLE, NC 28115

LOCATION / DIRECTIONS 1155, TL ROCKWELL LP, 2ND ON R

SUBDIVISION — BLOCK / SECTION — LOT # — LOT AREA .57AC DESIGN FLOW 360GPD L.T.A.R. .3

Septic Tank 1000 Gallons: STB 512 Date 5-7-10

Pump Tank — Gallons: P T Date —

Pump Make — Model — Serial # —

Nitrification Field No Fields 1 No Lines 5 Linear Feet 400'

Trench Width 36" Max. Trench Bottom Depth 36" Gravel Depth 12"

☒ New System ☐ Repair ☐ Expansion System Type I II III IV V VI

System Description: GRAVITY GRAVEL / 25%

Repair System Description: PM - GRAVEL / 25%

Maintenance Agreement Required ☐ YES ☒ NO

☒ GRAVITY ☐ PRESSURE


☒ Residence No. Bedrooms 3 ☐ Business No. Persons — ☐ Other No. Employees — ☐ Slab ☒ Crawl Space ☐ Basement w/plumbing ☐ Basement w/o plumbing

Water Supply: ☒ Private ☐ Public ☐ Community


Comments / Conditions 1) FOR OWNER TO INSTALL, SYSTEM MUST BE GRAVITY [redacted] GRAVEL. OTHER WISE A CERTIFIED INSTALLER MUST DO THE INSTALLATION 2) ANY PART OF SEPTIC MUST BE 50' MIN FROM WELLS 3) TANK MUST BE

Comments / Conditions 5' MIN FROM HOUSE 4) DRAIN LINES MUST BE 5' MIN FROM PROPERTY LINES 5) PUMP CRUSH & FILL OLD TANK 6) IF STUBBED OUT TOO LOW, GRAVITY DISTRIBUTION WILL NOT WORK & PUMP FEE WILL BE CHARGED

INITIAL SITE SKETCH

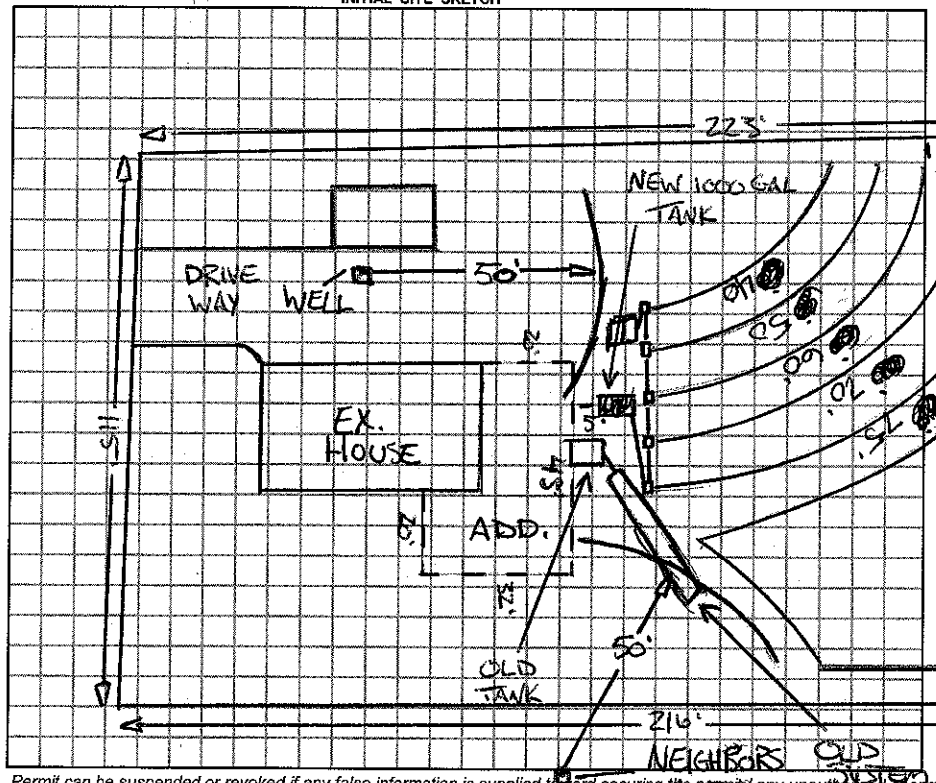

AS BUILT SKETCH

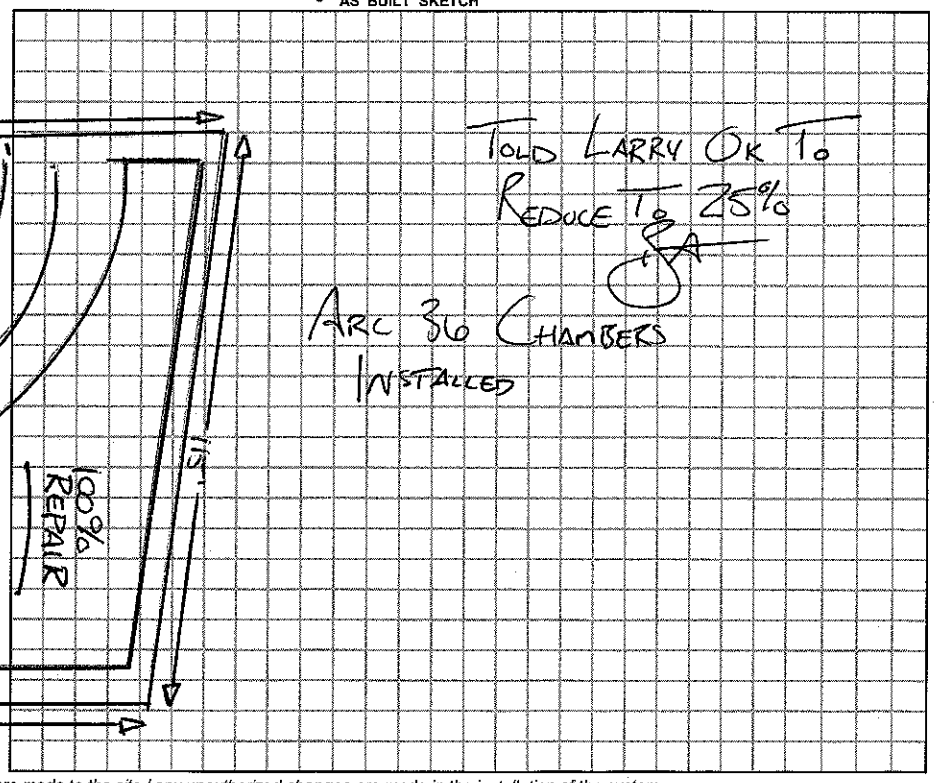

Permit can be suspended or revoked if any false information is supplied toward securing the permit, any unauthorized changes are made to the site / any unauthorized changes are made in the installation of the system.

☐ *IMPROVEMENT PERMIT w / plat valid without expiration* ☒ *IMPROVEMENT PERMIT w / site plan valid for 60 mos.* ☒ *AUTHORIZATION TO CONSTRUCT valid for period equal to IMPROVEMENT PERMIT-not to exceed 60 mo.*

Owner / Applicant Signature: [signature] Date 4-6-10

Improvement Permit by: [signature] REHS Date 3-30-10

Authorzation to Construct by: [signature] REHS Date 4-6-10

YOU SHOULD CONTACT A LOCATOR SERVICE PRIOR TO ANY EXCAVATION.

Installed by: LARRY BEAM GRADING

Operation Permit by: [signature] REHS Date: 6-29-10

Existing System Inspected by: [signature] Date:

WHITE COPY Environmental Health YELLOW COPY (Final) Owner / Applicant PINK COPY (Initial) Owner / Applicant